


DH 251 through 282

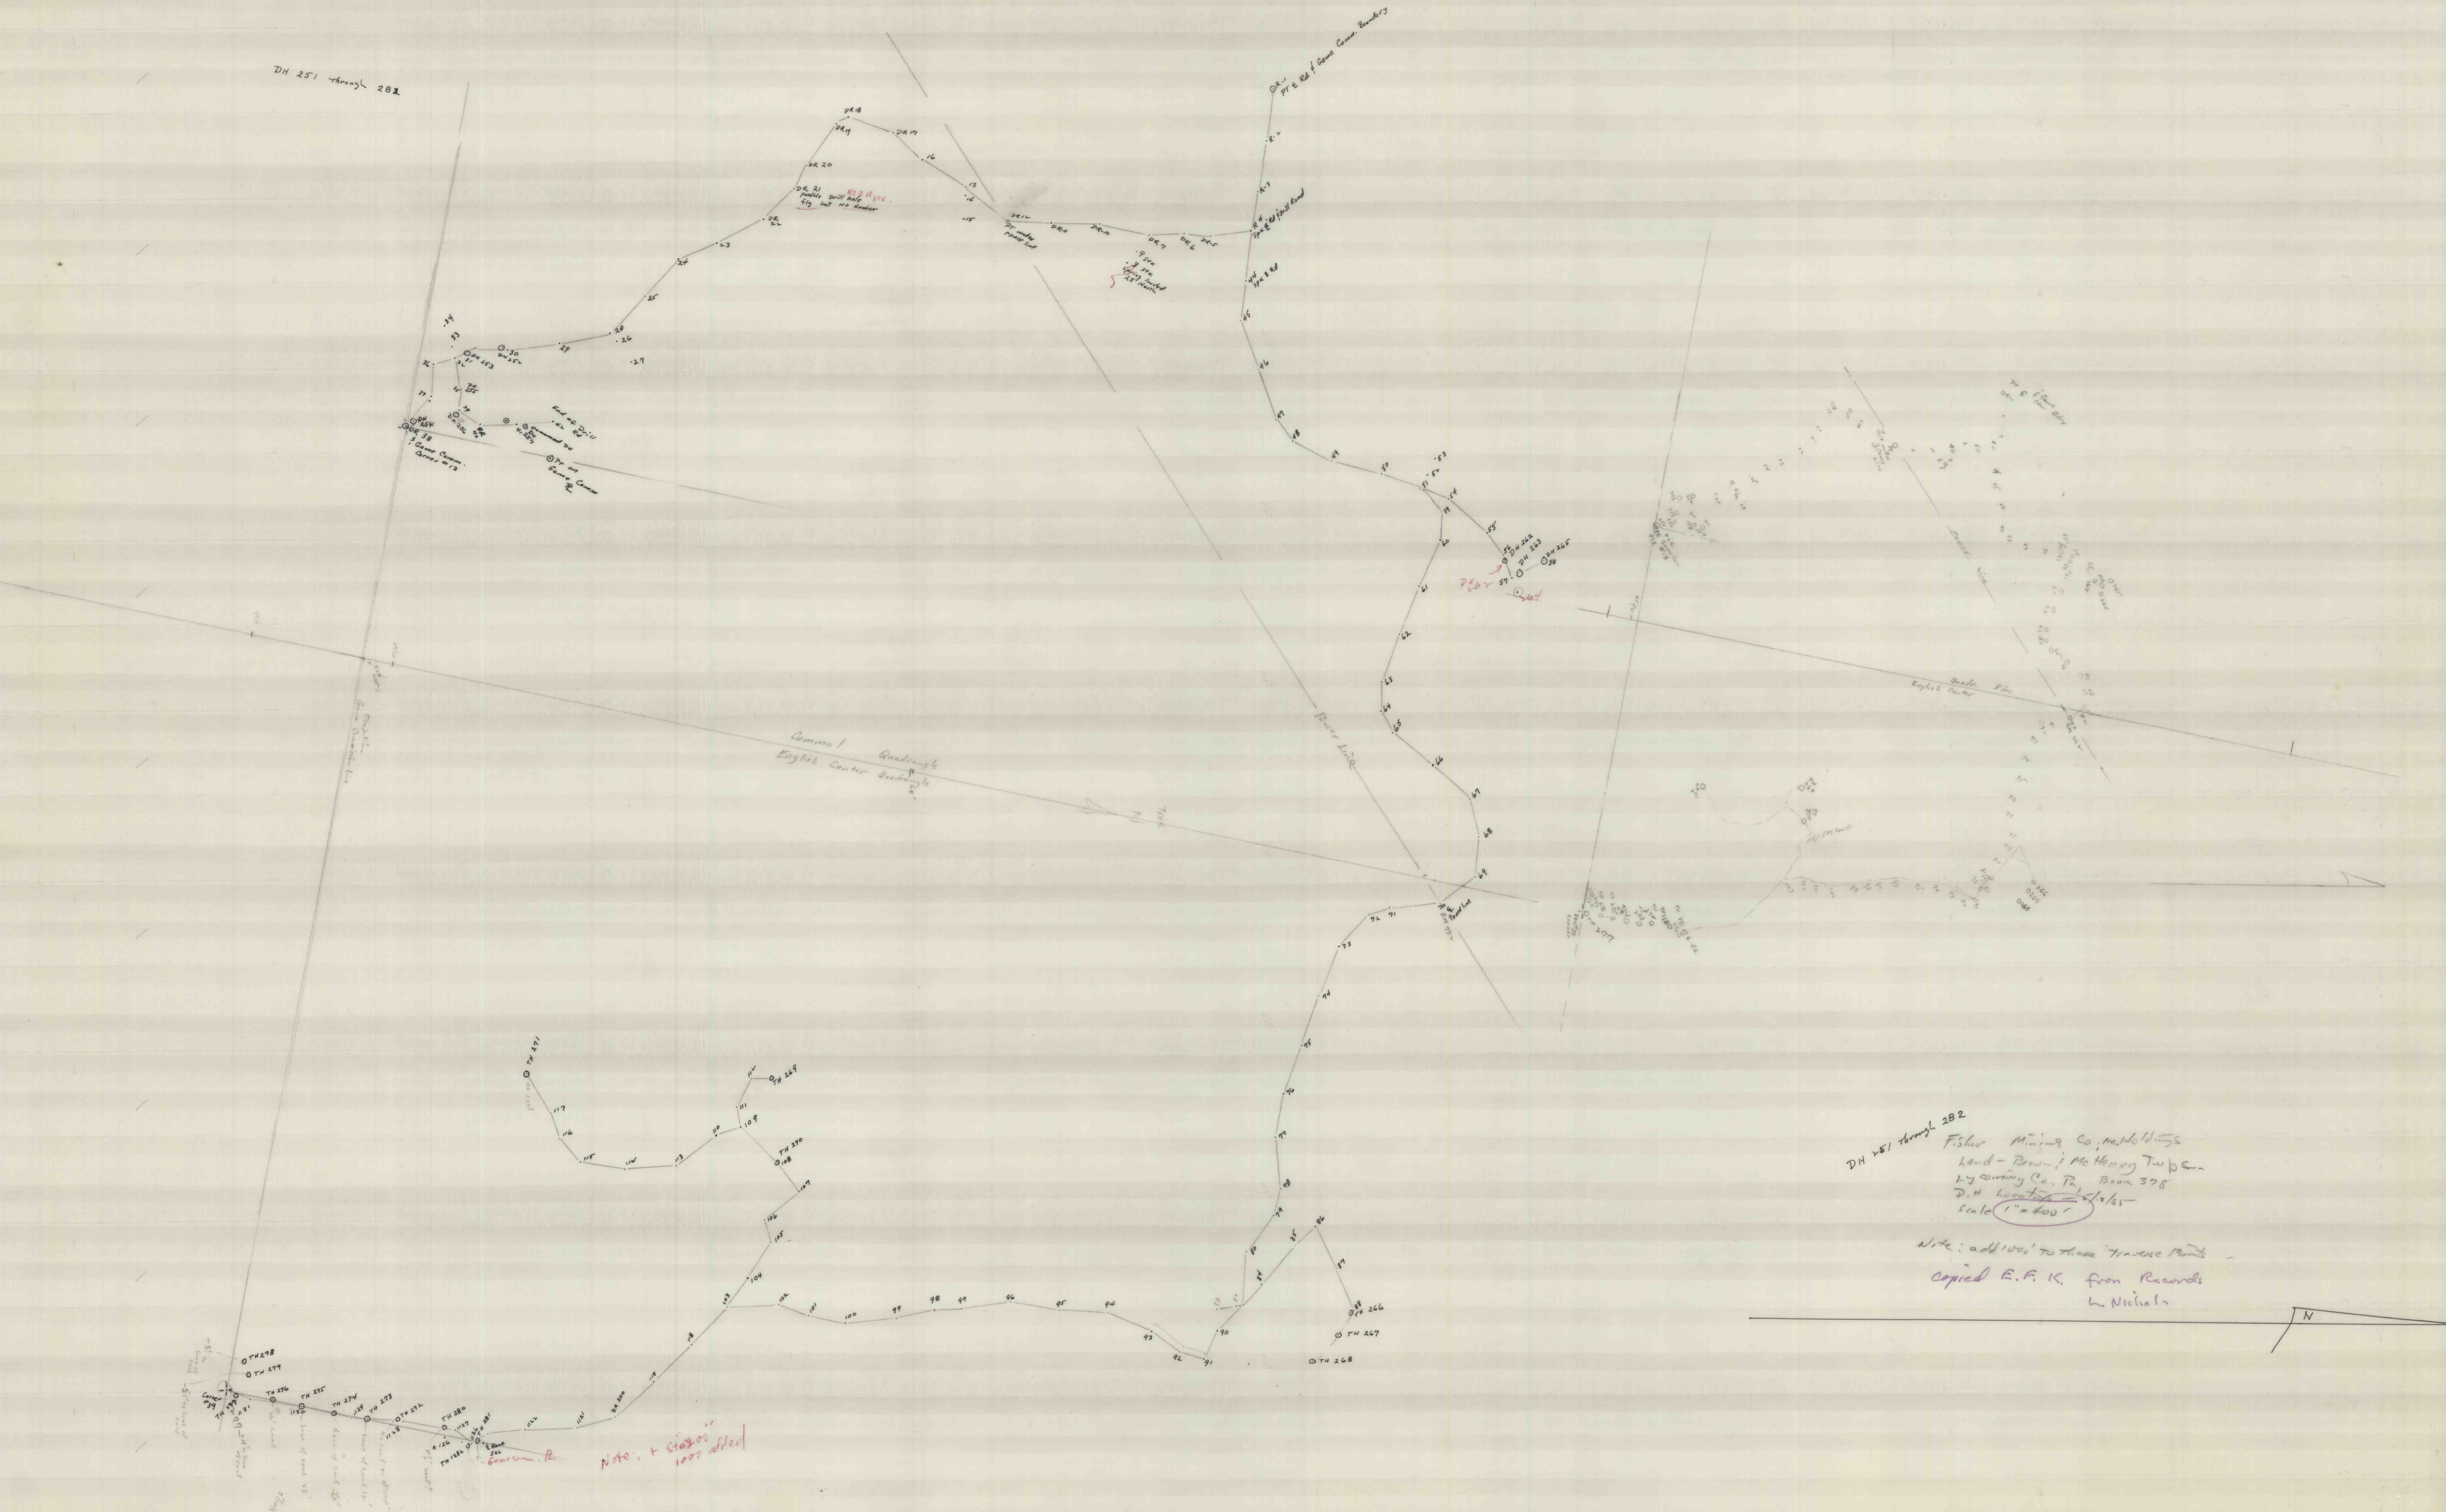

DH 251 through 282
 Fisher Mining Co. Holdings
 Land - Brown & McHenry Twp
 Lycoming Co., Pa. Book 378
 D.H. Location 1/2/1/2
 scale 1" = 400'

Note: add 1000' to these traverse points -
 Copied E.F.K. from Records
 L. Nichols

N