


MAP OF MERCER COUNTY

SCALE 0 1 2 3 MILES

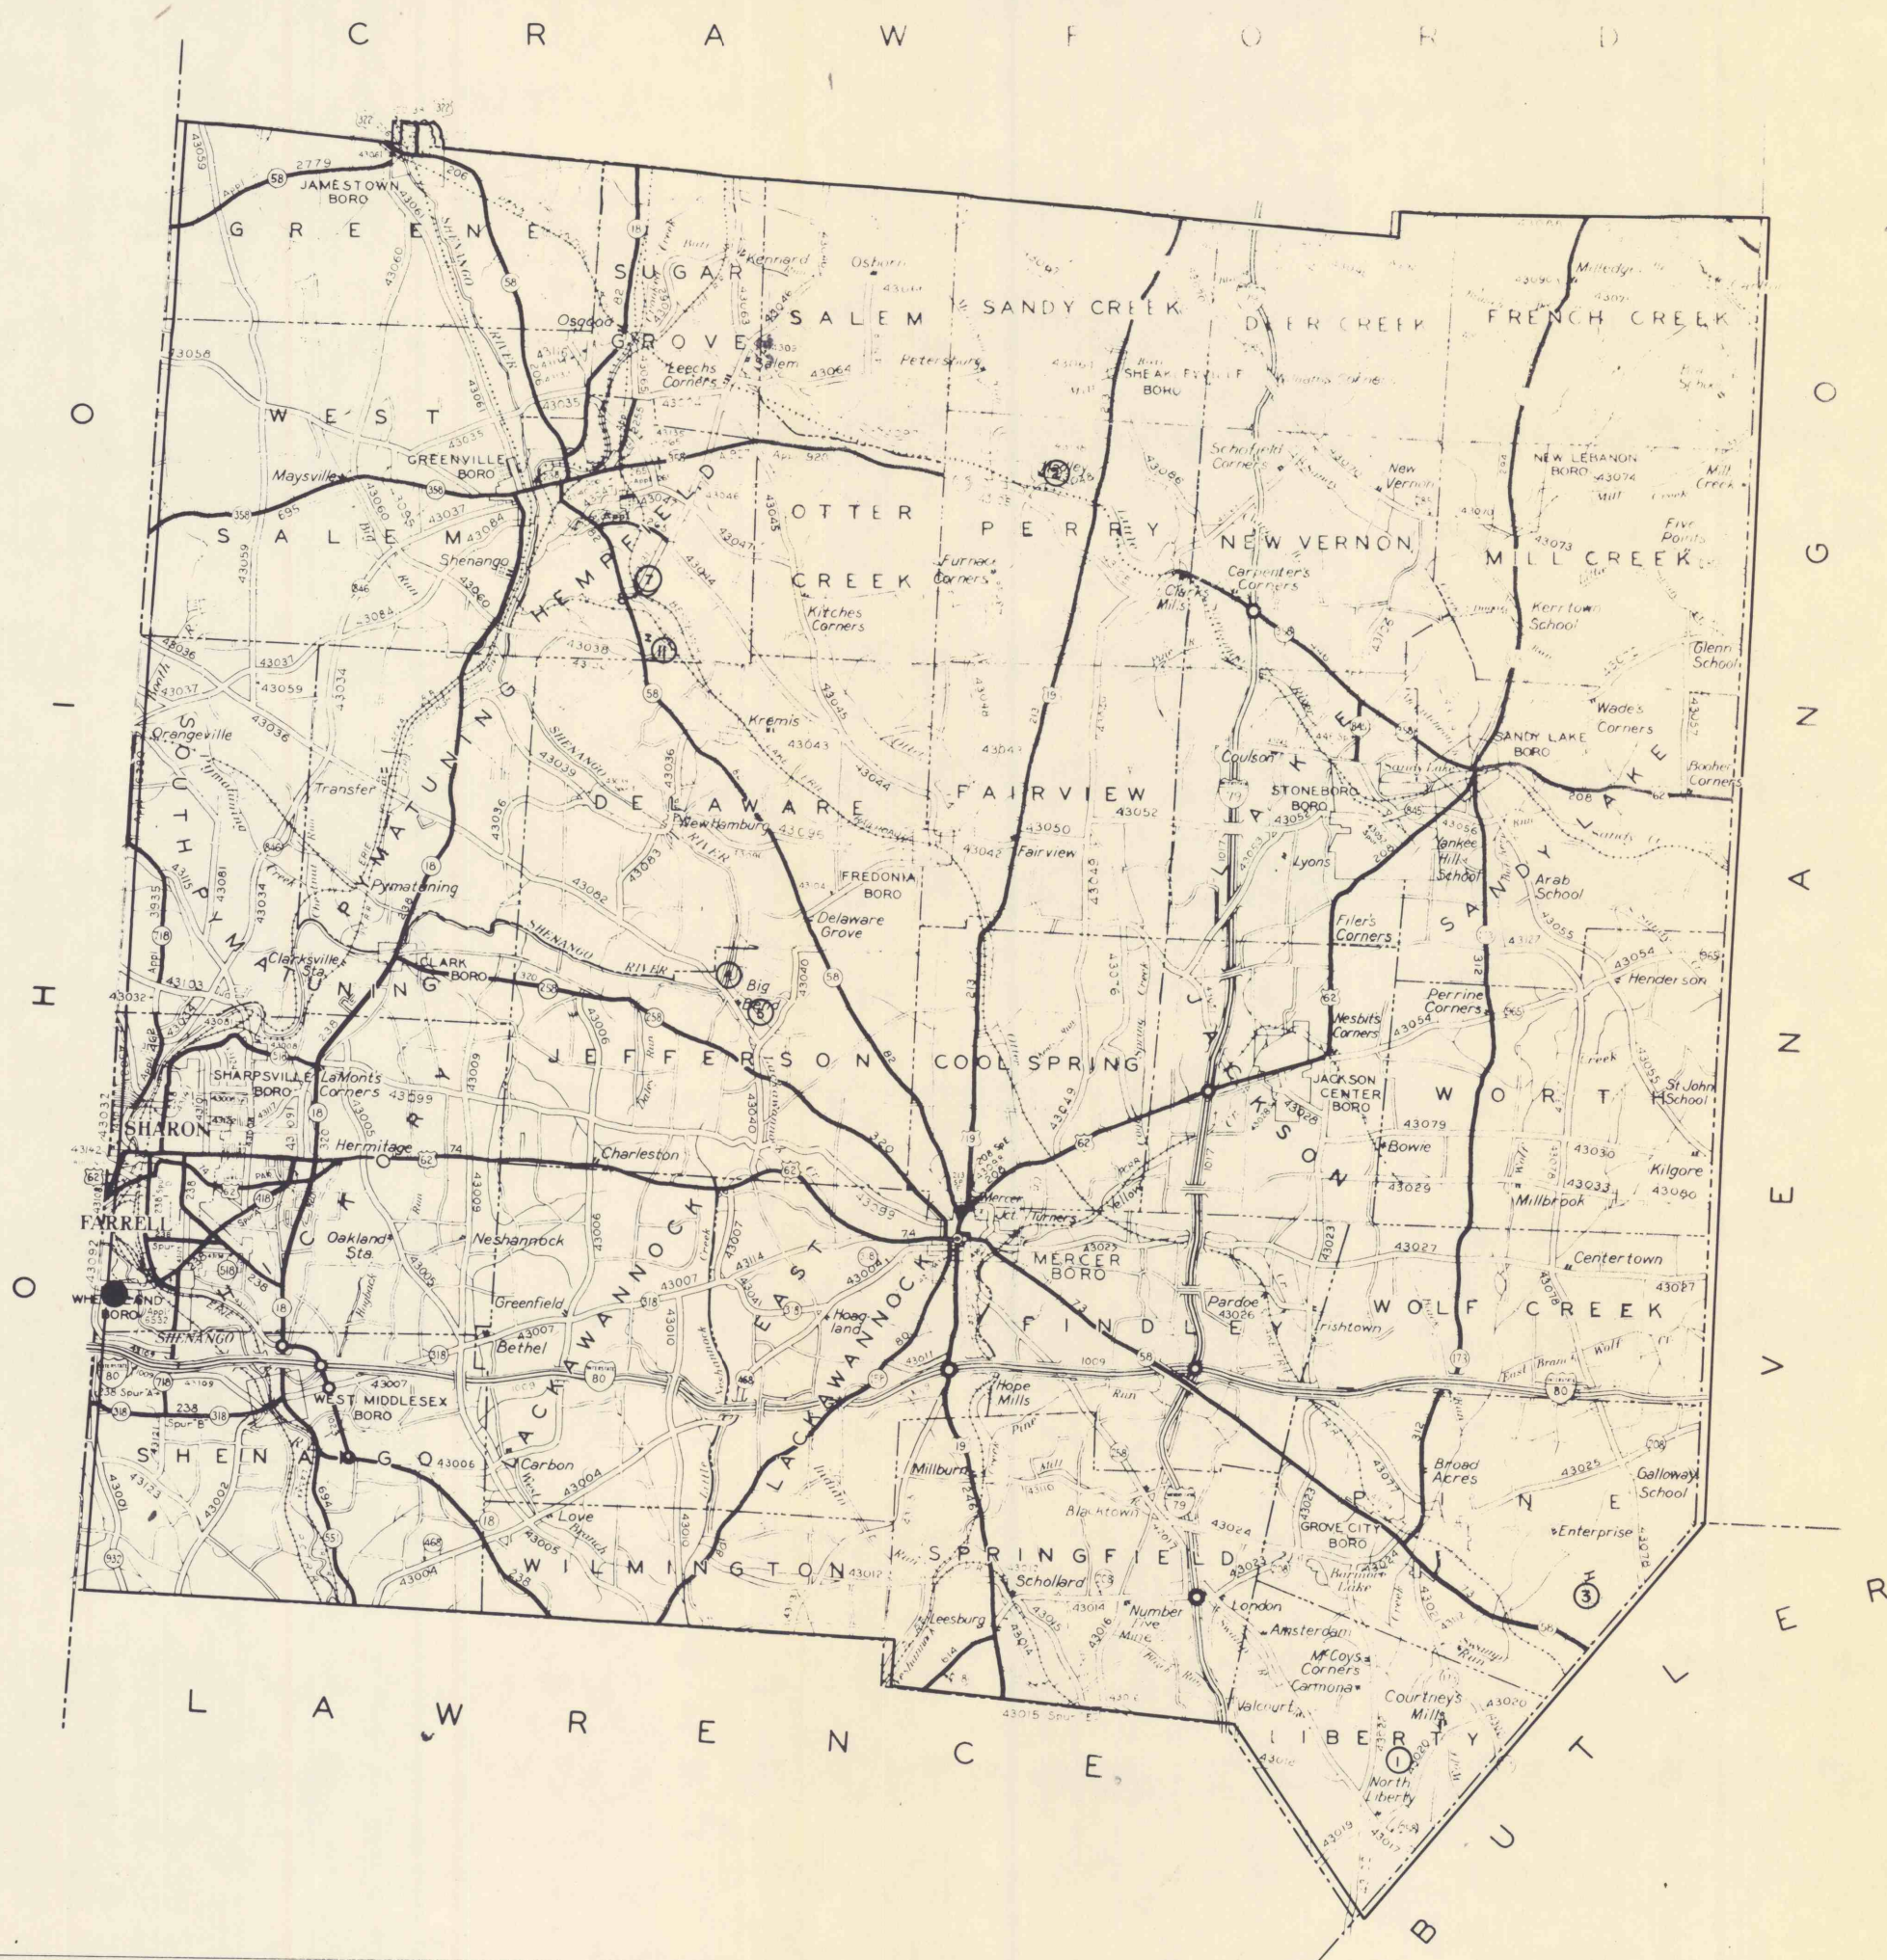

NO.	PRODUCER	SOURCE NAME	ROCK TYPE	FORMATION (GEOLOGICAL SYMBOL)	PDT TYPE			STATUS	FINE AGG.	LATITUDE NORTH	LONGITUDE WEST
					A	B	C				
1	VANPORT STONE CO. BOX 144 EDINBURG, PA. 16116	SLIPPERY ROCK LIBERTY TWP.	LIMESTONE	IPv			(NA)	ACTIVE		41-06-07	80-05-17
2	ATLAS SAND & GRAVEL CO. BOX 332 HADLEY, PA. 16130	HADLEY	SAND & GRAVEL	Gravel Wisc. or Ill. Drift			(NA)	ACTIVE	✓	41-24-45	80-13-15
3	CROWN SAND & GRAVEL CO. R.D. #3, GROVE CITY, PA.	HARRISVILLE						INACTIVE		41-08-48	80-02-02
4	SEIDLE SAND & GRAVEL CO. RD 7, MERCER, PA. 16137	JEFFERSON TWP PLANT 2	SAND & GRAVEL	Gravel, Kent Drift			(NA)	ACTIVE	✓	41-17-05	80-13-10
5	TAYLOR SAND & GRAVEL CO. BOX 661 SHARON, PA. 16146	JEFFERSON TWP (BIG BEND)	"	Gravel, Kent Drift			(NA)	ACTIVE	✓	41-16-36	80-18-36
6	DUNBAR SLAG CO. BOX 666, SHARON, PA. 16146	WHEATLAND HICKORY TWP.	SLAG	Blast Furn. Slag	X	X		ACTIVE		41-11-45	80-30-12
7		QUARRY HILL	S S & CONGLOM.	Upper Mp or Pos. IPp			(NA)	ACTIVE		41-22-55	80-21-30
8	WHITE ROCK SILICA SAND CO. PO. BOX 391, GREENVILLE, PA. 16125	GREENVILLE	SANDSTONE CONG.	Mp			(NA)	ACTIVE		41-22-55	80-21-12
9	WILMER S. WIKE & SON RD. #1, HARRISVILLE, PA.	WIKE	GRAVEL	Kent Drift				INACTIVE		?	?
10	TRANSFER SAND & GRAVEL CO. 215 ANDREWS AVE., YOUNGSTOWN 2, OHIO		SAND & GRAVEL					INACTIVE		?	?
11	GREENVILLE MATERIALS, MERCER RD. BOX 245, GREENVILLE, PA.	(ONIONTOWN)						INACTIVE		41-21-21	80-21-12

- 7 1/2' QUAD.
- 1 Slippery Rock NO
 - ✓ 2 Hadley
 - ✓ 3 Grove City
 - ✓ 4 Shenandoah
 - ✓ 5 "
 - NO 6 Sharon West
 - NO 8 "
 - ? 9 ?
 - ? 10 ?
 - ? 11 Fredonia

(NA) = Not approved by PennDOT