


TAYLOR FARM

M. W. BOWIE

WOLF CREEK TWP. MERCER CO. PENNA.

F.P. Graham, R.P.E. Grove City, Pa. Oct. 1935

| LEGEND. | | |
|---------|---------|-----------|
| SYMBOL | BY WHOM | DATE |
| A | G.M.P. | Oct. 1935 |
| B | S.J.T. | May 1936 |
| C | S.J.T. | Oct. 1941 |
| D | H.L. | July 1942 |
| | | |
| | | |
| | | |

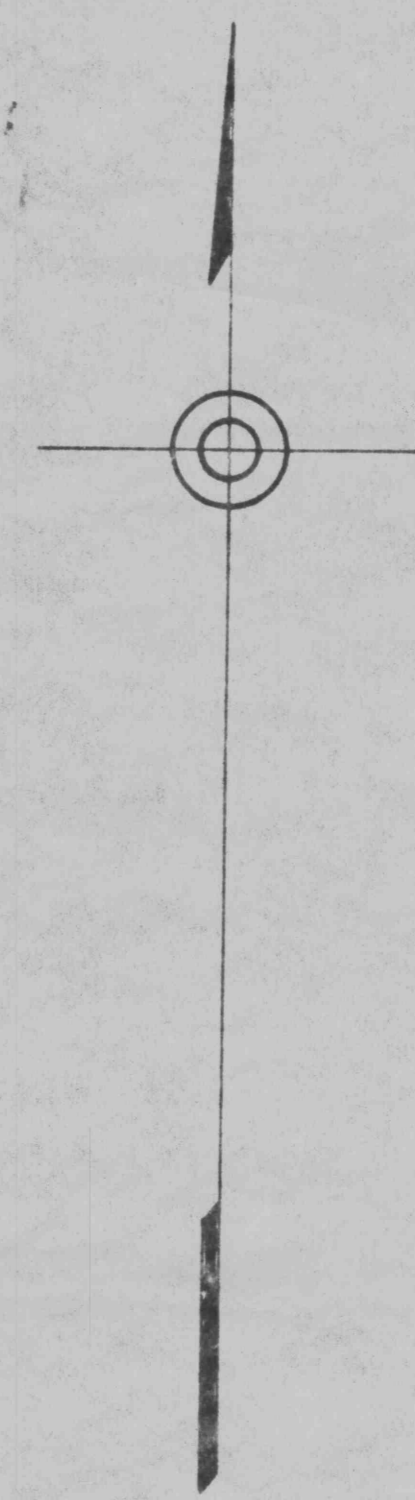

MCCOY

MARTIN

JAS DUNLAP