

HIGHLAND FUEL



TAYLOR FARM

M. W. BOWIE

WOLF CREEK TWP. MERCER CO. PENNA.

F. P. Graham R.P.E. Grove City, Pa. Oct. 1935
100' = 1"

LEGEND.		
SYMBOL	BY WHOM	DATE
A	G.M.P.	Oct. 1935
B	S.J.T.	May 1936
C	S.J.T.	Oct. 1941
D	A.J.L.	July 1942

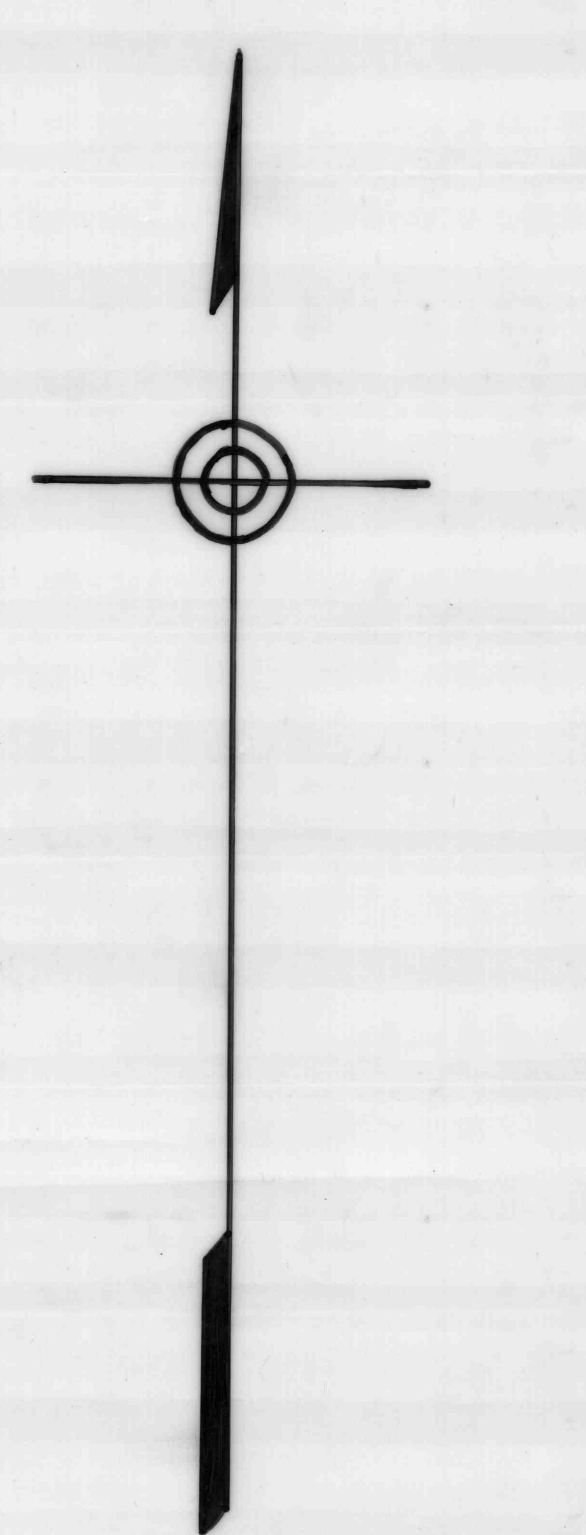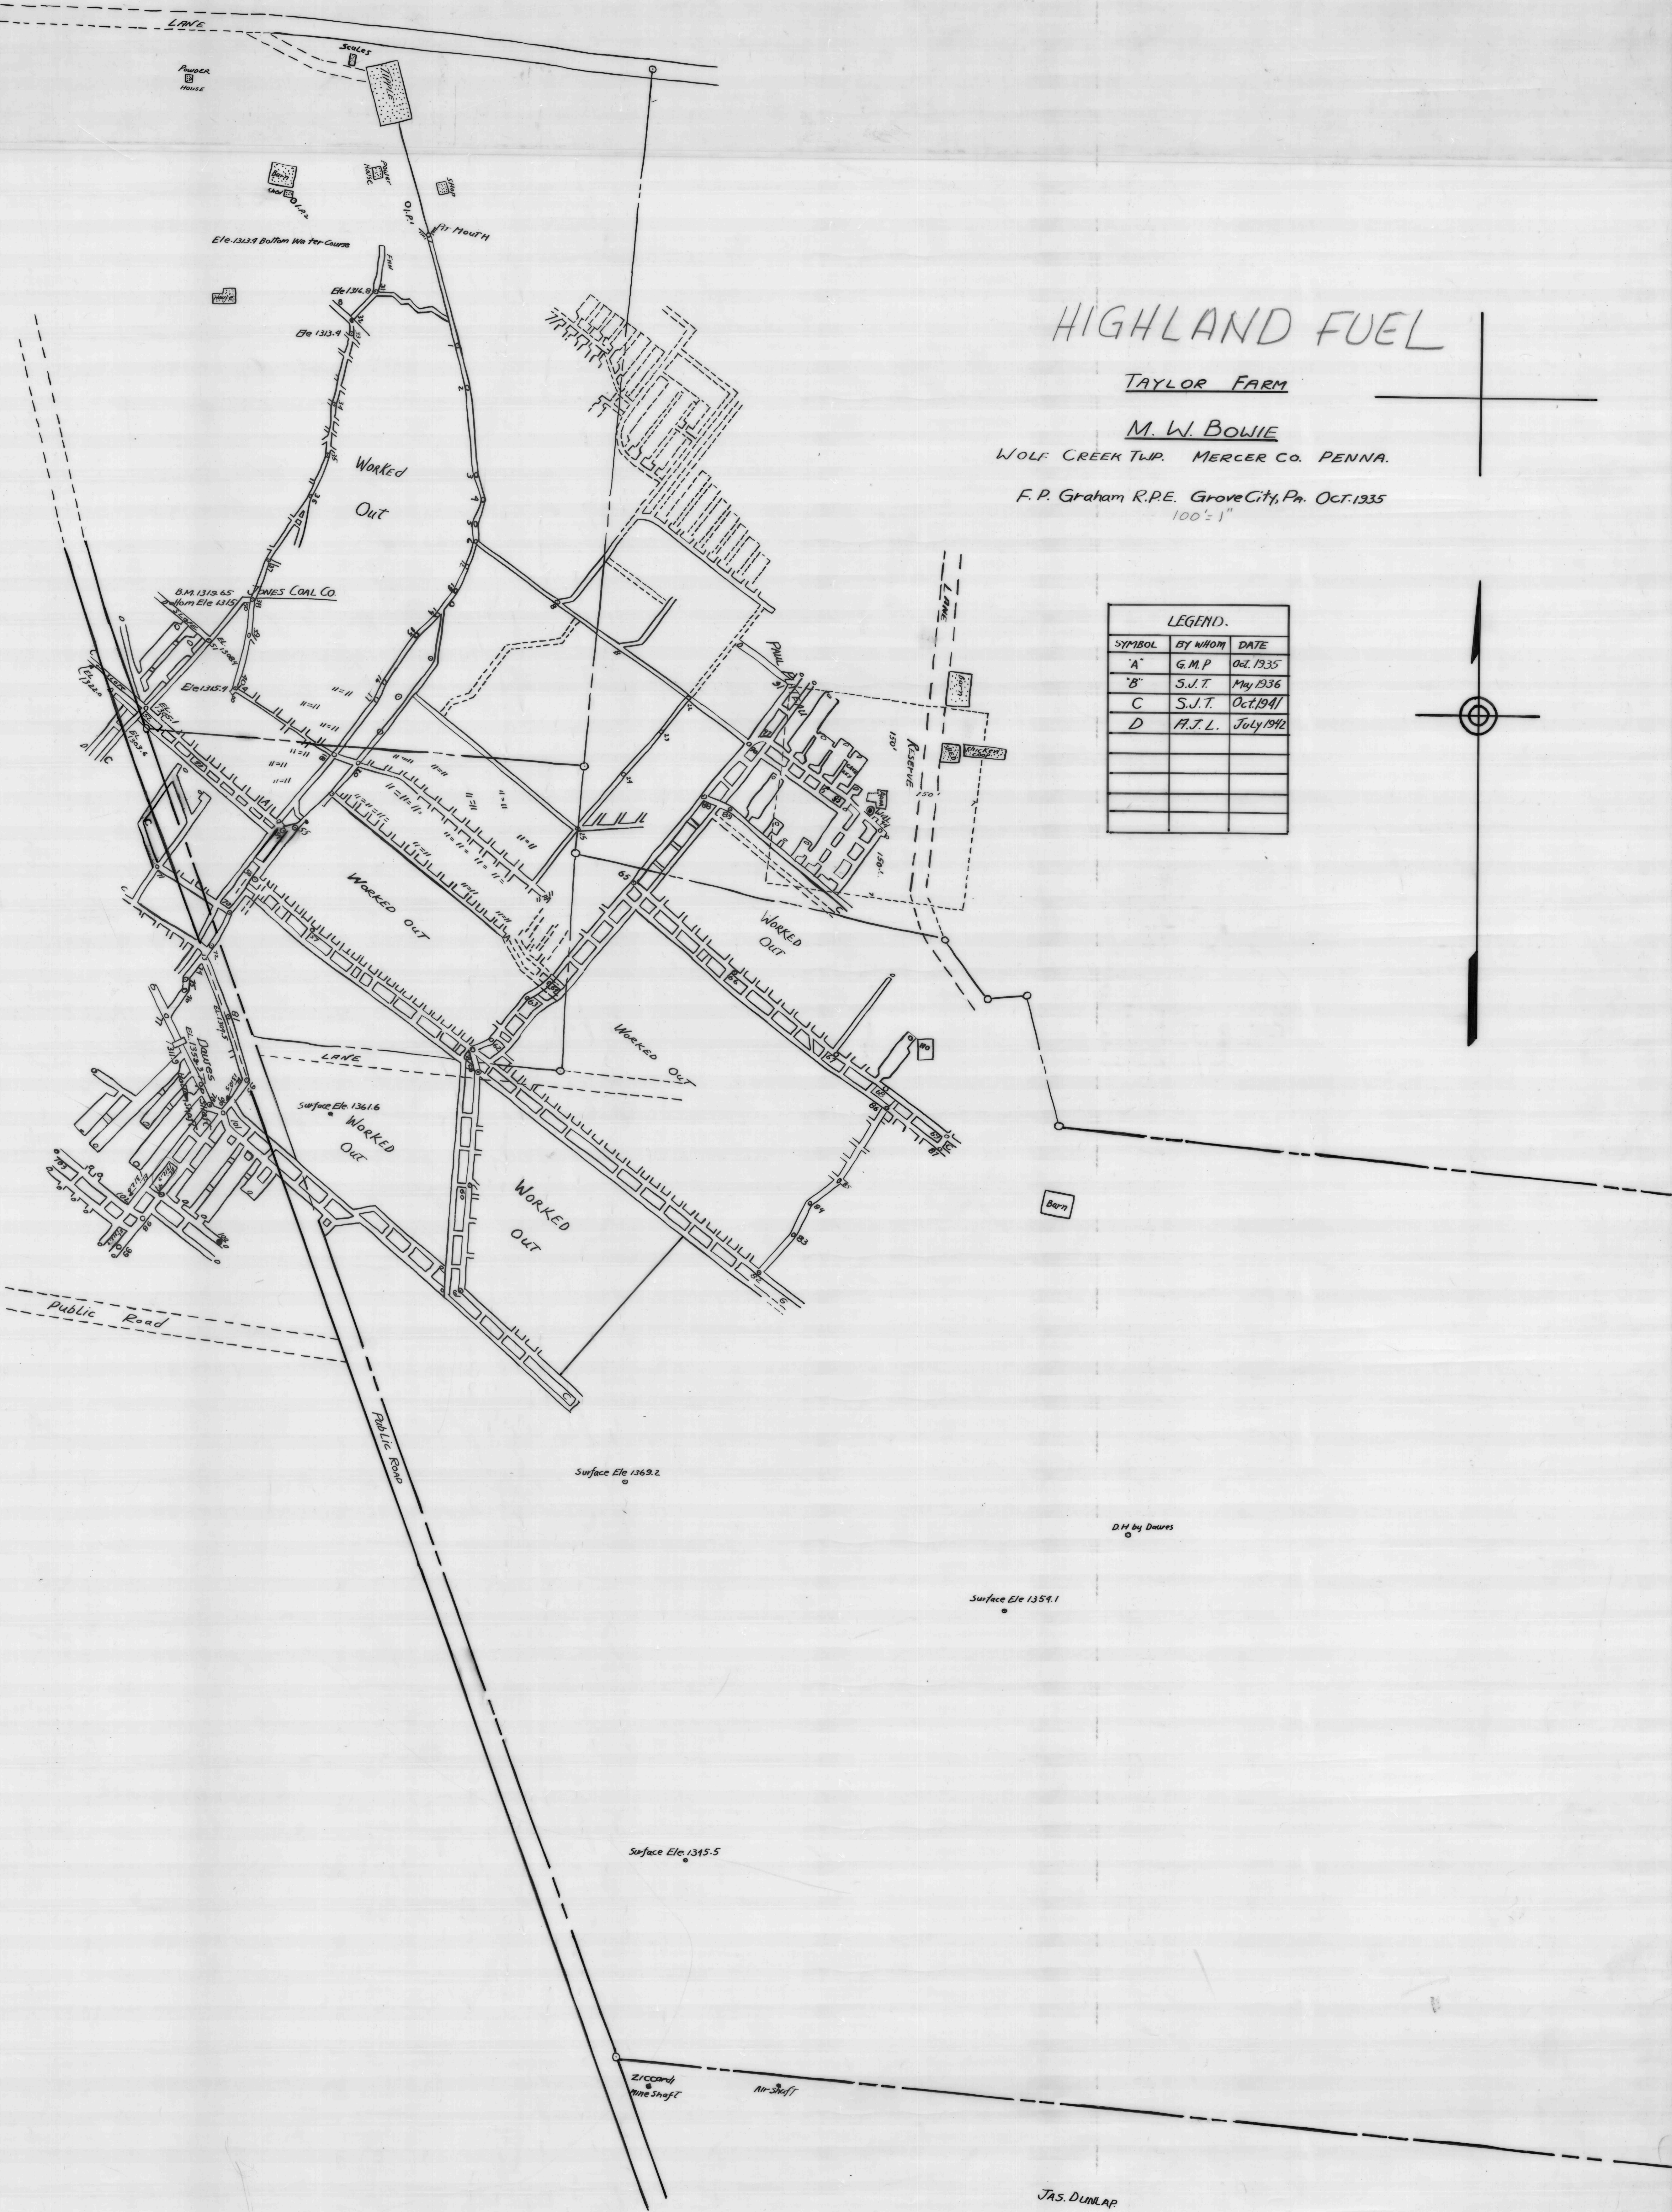

D.M. by Dawes

JAS. DUNLAP