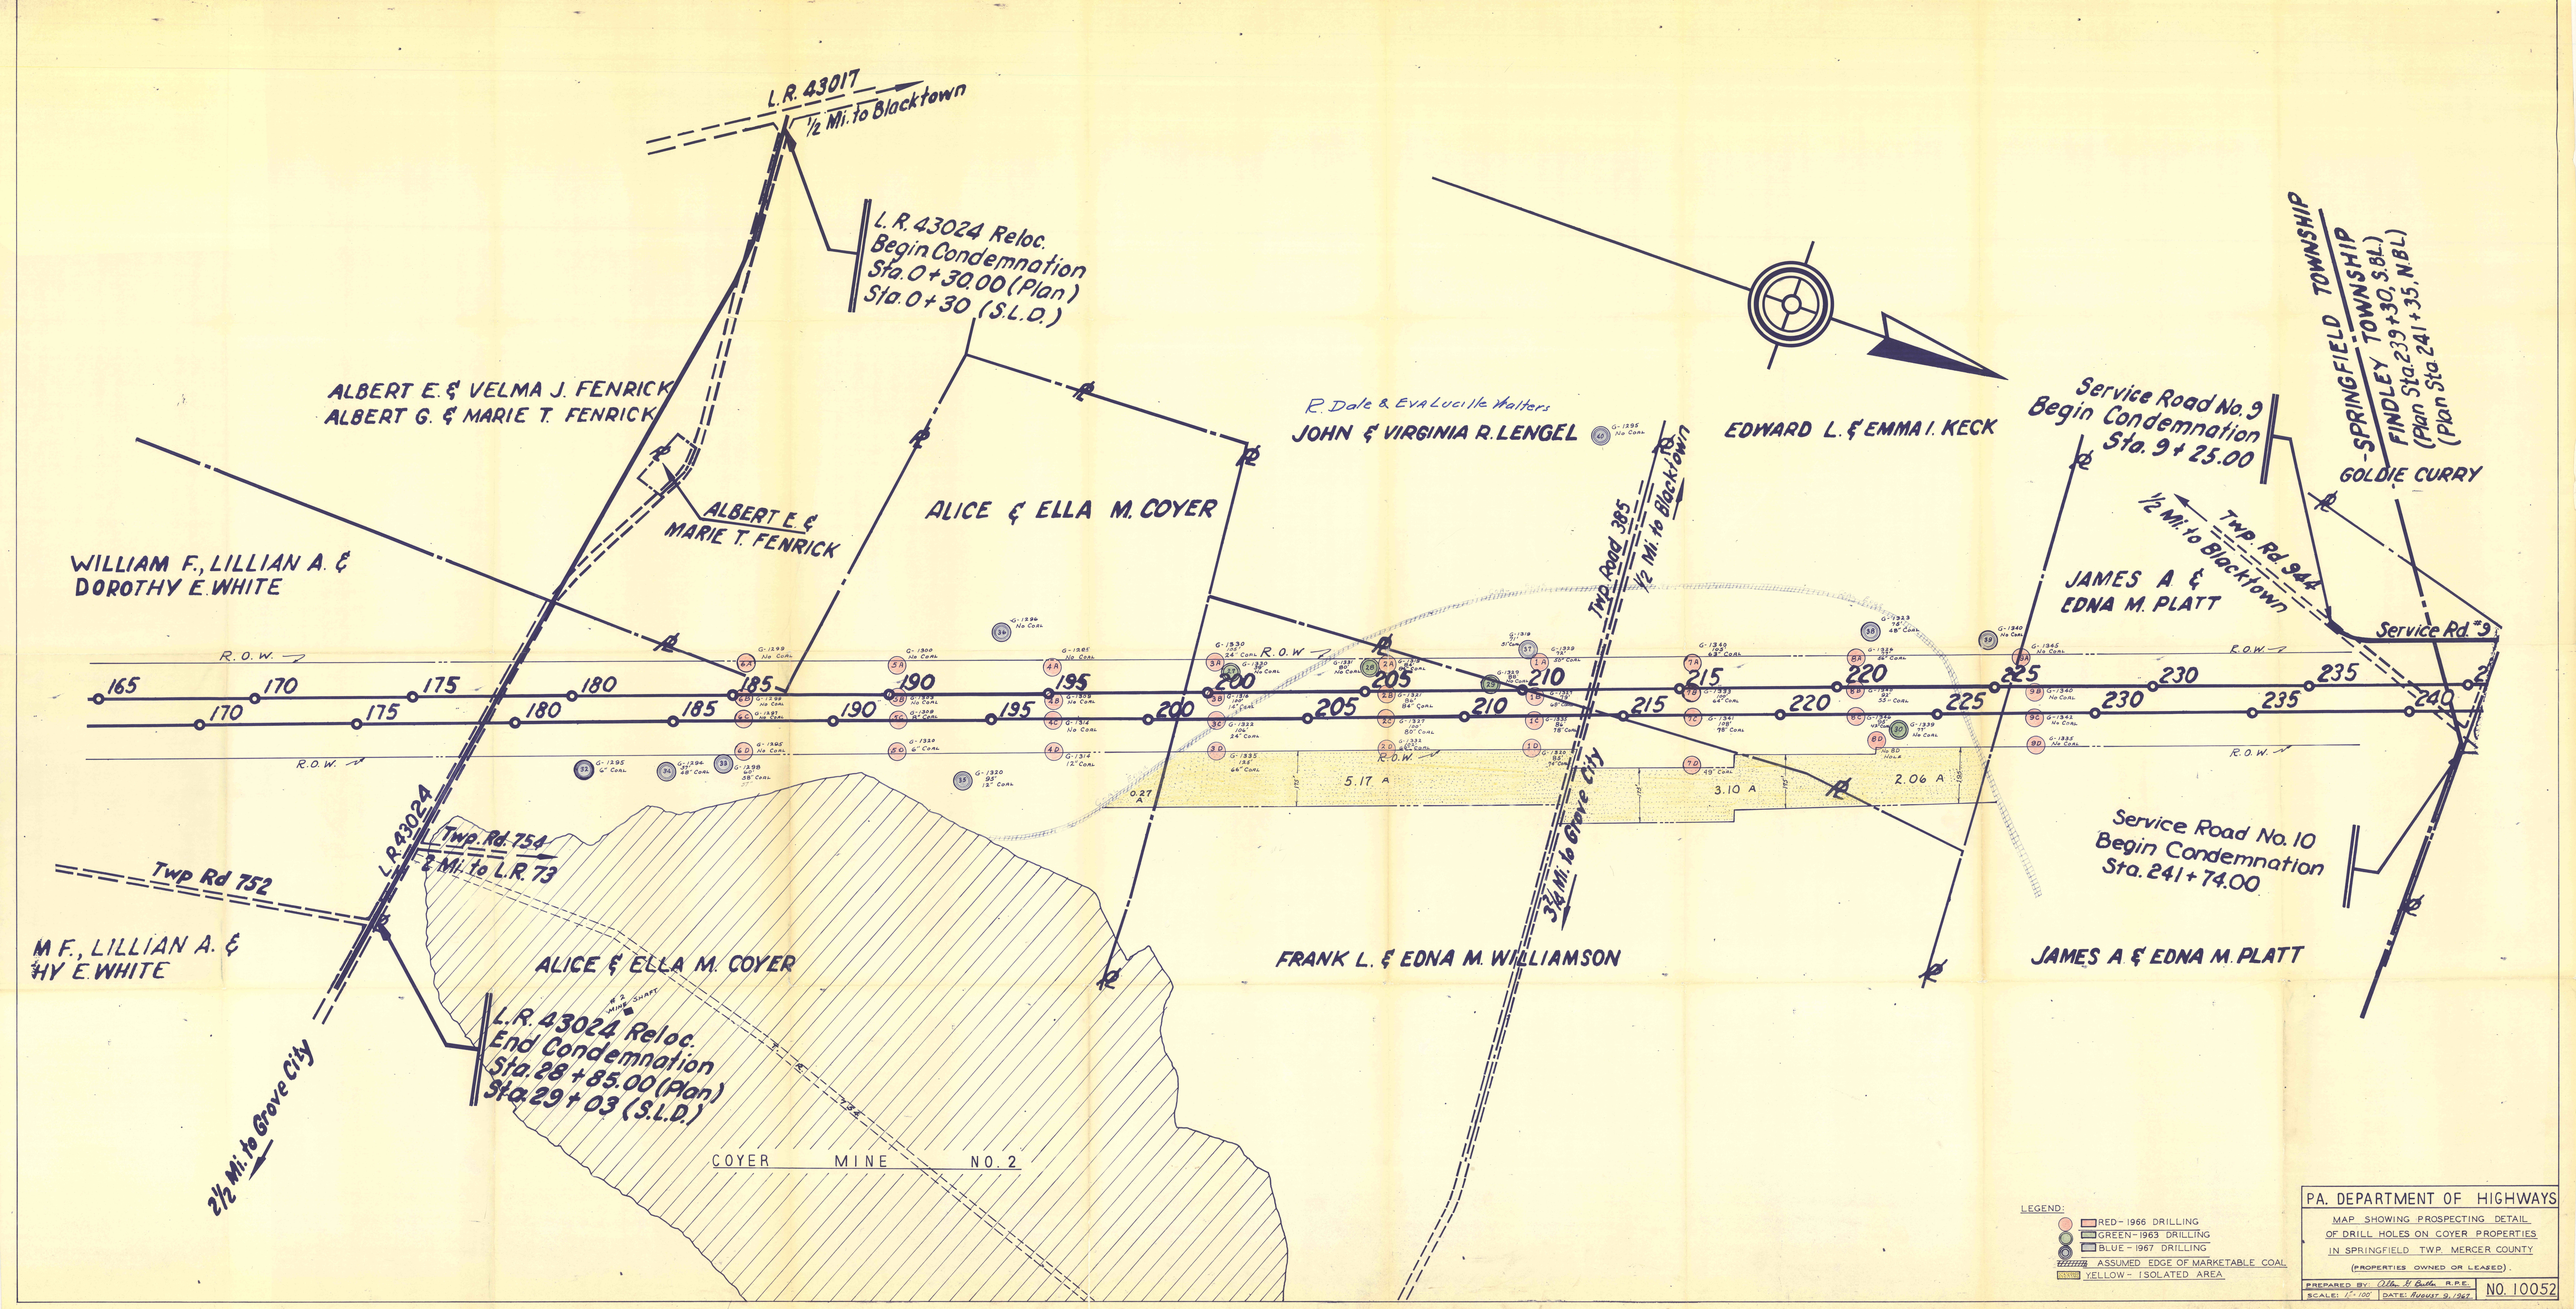
L.R. 43017
1/2 Mi. to Blacktown
L.R. 43024 Reloc.
Begin Condemnation
Sta. 0+30.00 (Plan)
Sta. 0+30 (S.L.D.)
ALBERT E. & VELMA J. FENRICK
ALBERT G. & MARIE T. FENRICK
ALBERT E. & MARIE T. FENRICK
ALICE & ELLA M. COYER
R. Dale & Eva Lucille Walters
JOHN & VIRGINIA R. LENGEL
EDWARD L. & EMMA I. KECK
Service Road No. 9
Begin Condemnation
Sta. 9+25.00
SPRINGFIELD TOWNSHIP
FINDLEY TOWNSHIP
(Plan Sta. 239+30, S.BL.)
(Plan Sta. 241+35, N.BL.)
GOLDIE CURRY
WILLIAM F., LILLIAN A. & DOROTHY E. WHITE
Twp. Rd. 385
1/2 Mi. to Blacktown
Twp. Rd. 944
1/2 Mi. to Blacktown
JAMES A. & EDNA M. PLATT
Service Rd. #9
R.O.W.
165
170
175
180
185
190
195
200
205
210
215
220
225
230
235
240
0.27 A
5.17 A
3.10 A
2.06 A
Service Road No. 10
Begin Condemnation
Sta. 241+74.00
Twp Rd 752
L.R. 43024
Twp. Rd. 754
1/2 Mi. to L.R. 73
M F., LILLIAN A. & HY E. WHITE
ALICE & ELLA M. COYER
FRANK L. & EDNA M. WILLIAMSON
JAMES A. & EDNA M. PLATT
3 1/4 Mi. to Grove City
2 1/2 Mi. to Grove City
L.R. 43024 Reloc.
End Condemnation
Sta. 28+85.00 (Plan)
Sta. 29+03 (S.L.D.)
COYER MINE NO. 2
LEGEND:
RED - 1966 DRILLING
GREEN - 1963 DRILLING
BLUE - 1967 DRILLING
ASSUMED EDGE OF MARKETABLE COAL
YELLOW - ISOLATED AREA
PA. DEPARTMENT OF HIGHWAYS
MAP SHOWING PROSPECTING DETAIL
OF DRILL HOLES ON COYER PROPERTIES
IN SPRINGFIELD TWP. MERCER COUNTY
(PROPERTIES OWNED OR LEASED).
PREPARED BY: Allen H. Butler R.P.E.
SCALE: 1" = 100'
DATE: August 9, 1967
NO. 10052