
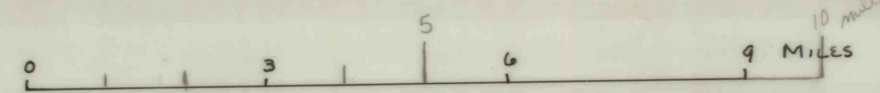


T 18 merged
 S 18 x moved south
 S 14 " "
 S 19 " "
 A 21 " "
 A 18, 19 & 20 " north

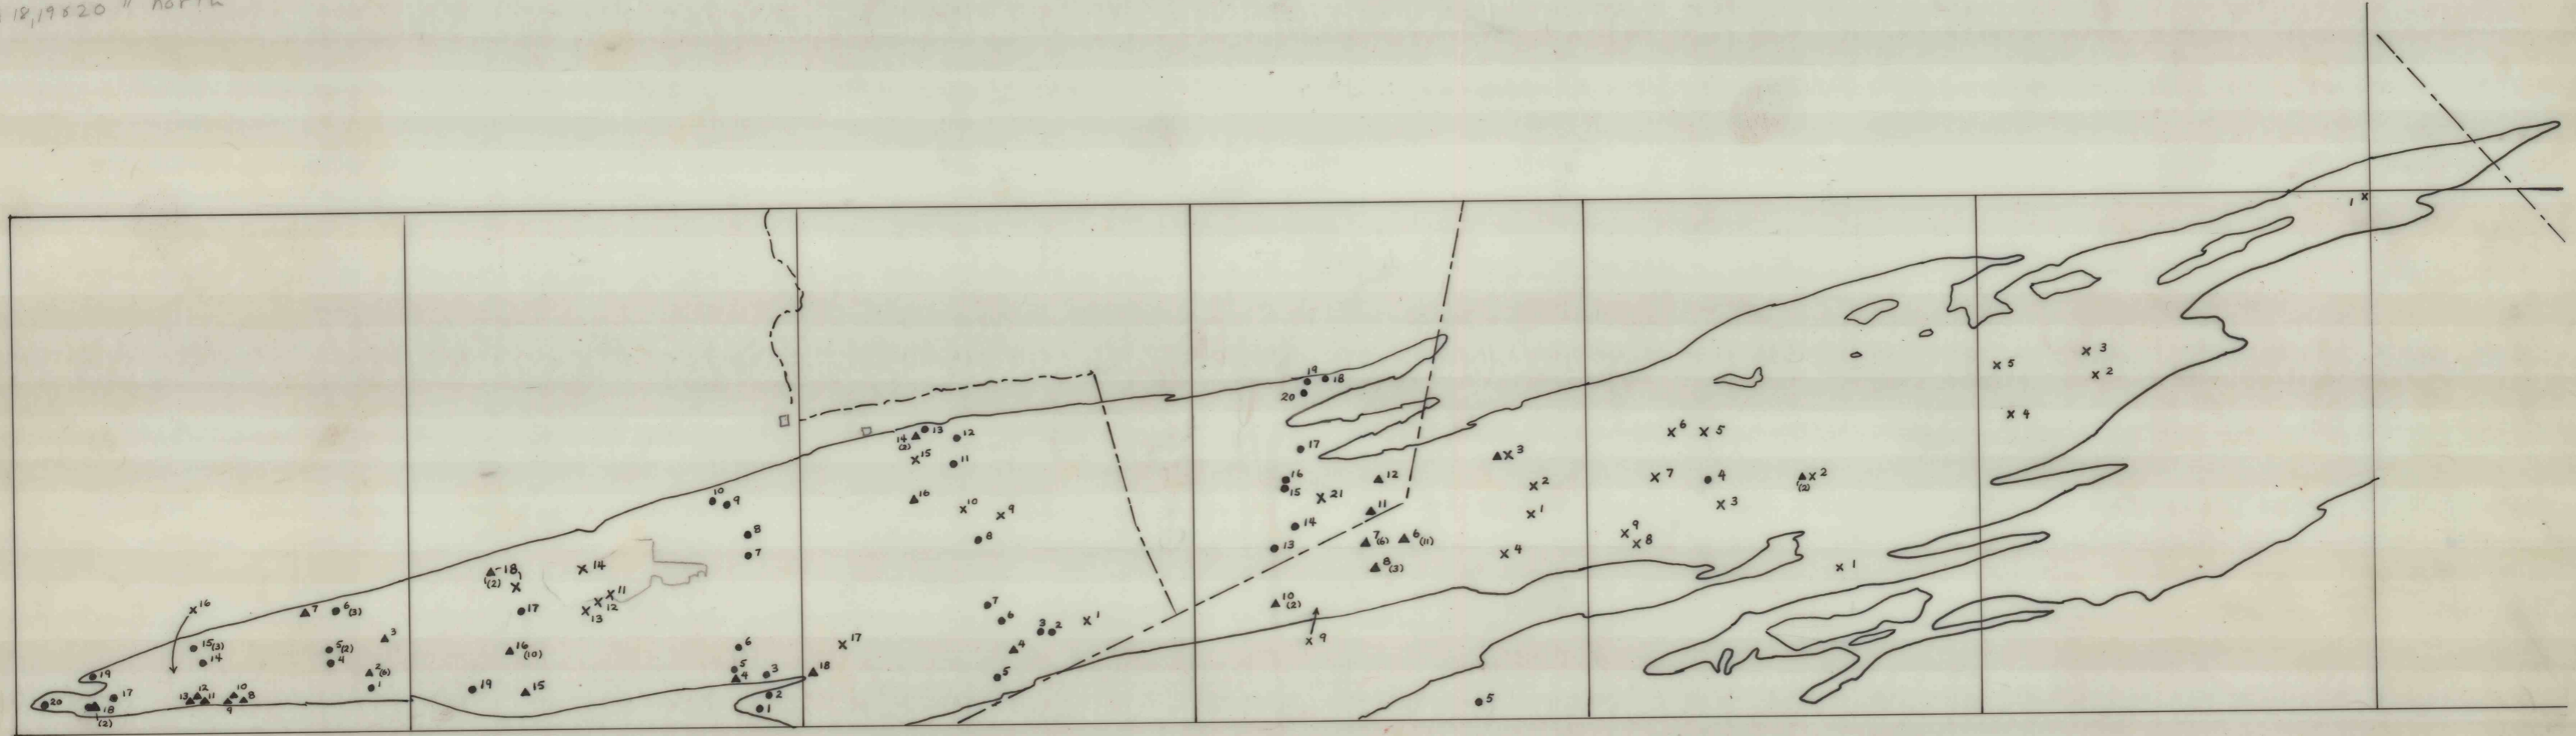

▲ - mine
 ● - surface
 X - tipple or delivered