


COMPOSITE STRATIGRAPHIC SECTION OF EXPOSED ROCKS

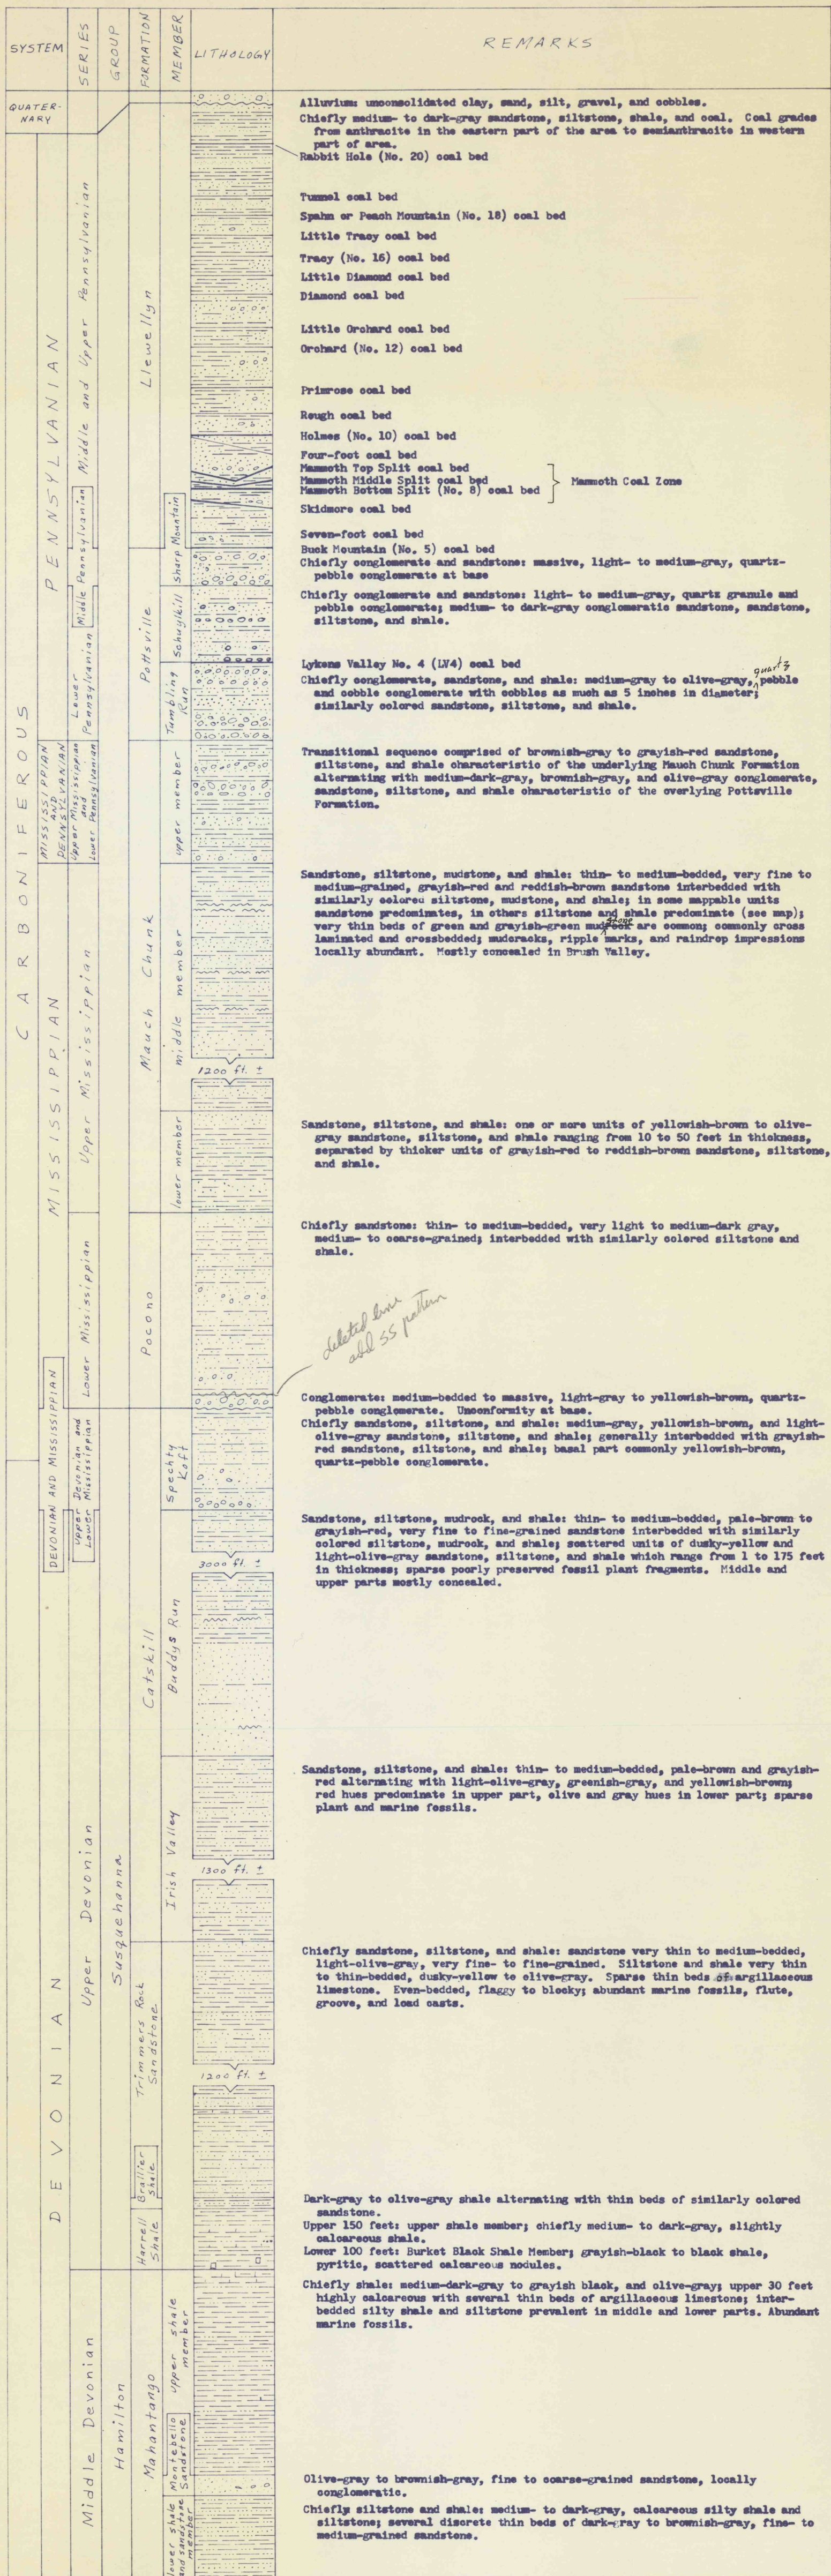

VERTICAL SCALE 1 INCH = 400 FEET