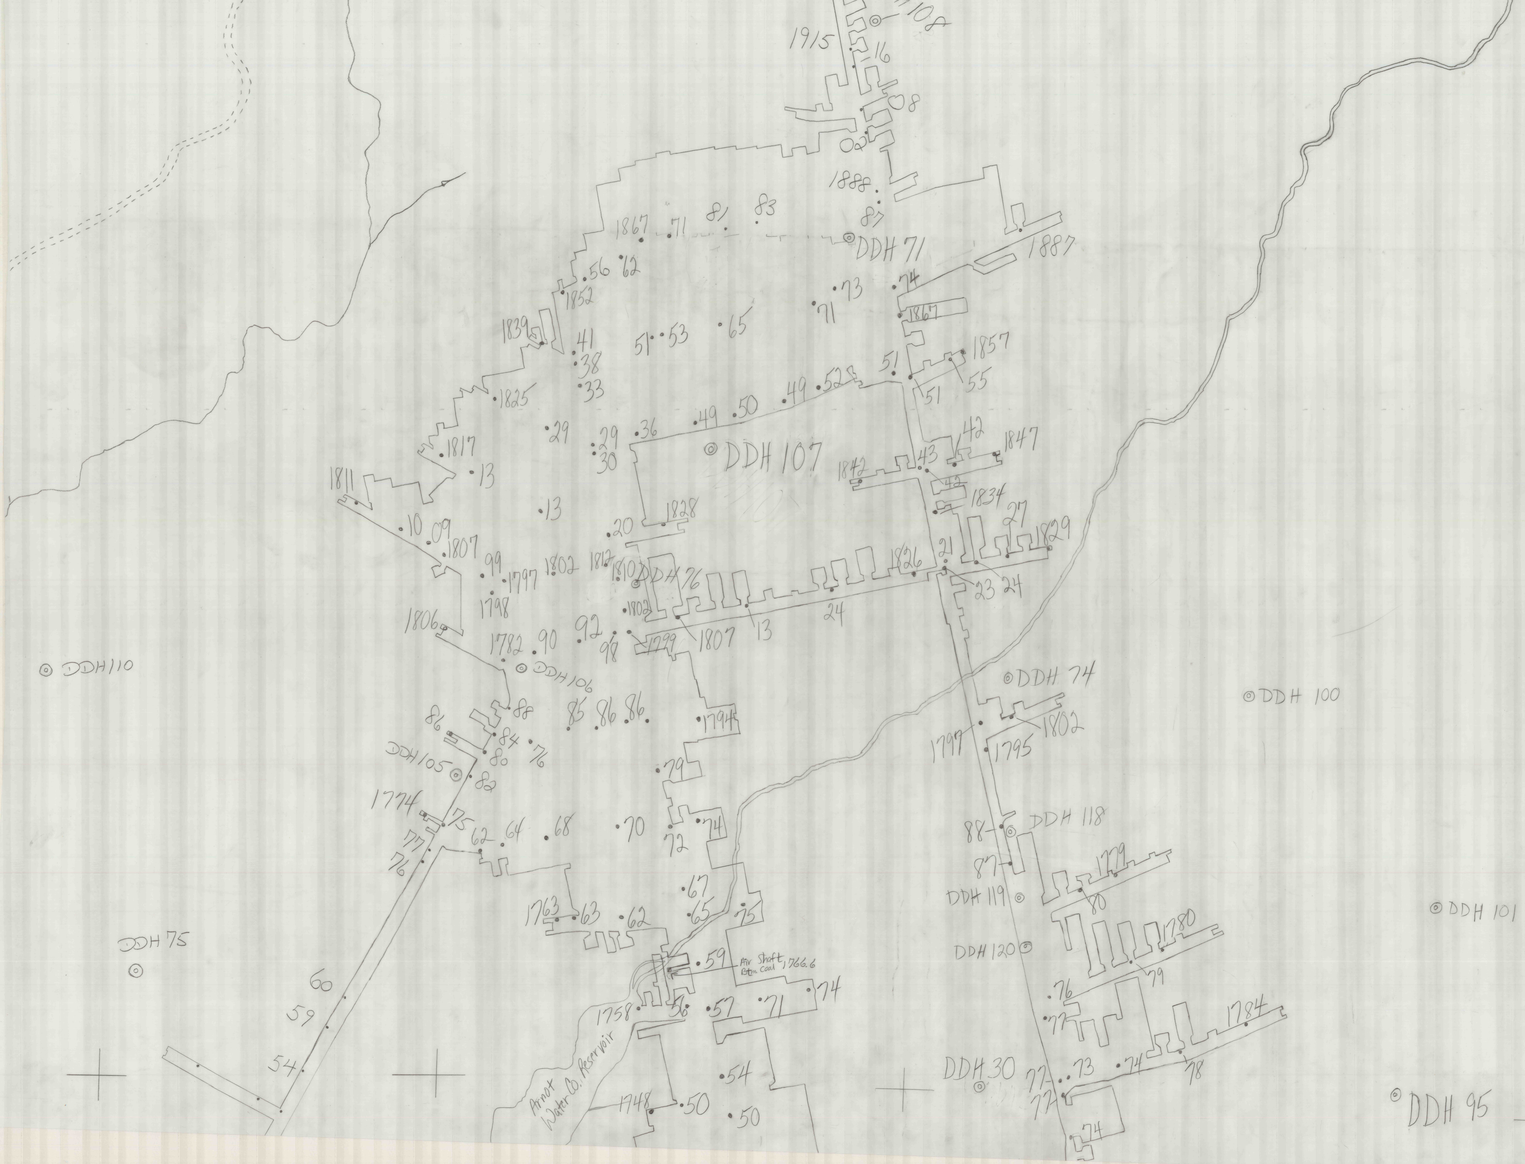

Blossburg Coal Company
Mine No. 1, Bloss coal

(NGVD 29)

Note: Mine elevations corrected to USGS mean sea level by adding 81.47 ft (Bureau Kintz, Surveyor, correction factor); elevations normalized on floor of mine.

Sheet 2 of 2