

Approx location  
Kellar drift

old pits

building

#1  
983.7

#2  
983.6

#5  
1000.8

#6

shaft

999.0

999.5

998.0

997.6

1000.3

991.2

994.9

Fault

SLIP


Headline

998.0

974.2

shaft

Scale (?)

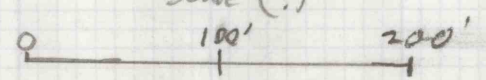

buried Pt