


DDH 25

DDH 24
Sur 1569.0
Bot coal 1457
Bot SC 1435.7
" " 1419.5
" clay 1413

Sur 1535.5
B/C 1409.3

DDH 22
Sur 1613.4
B/C 1411.0
Elev 9.8

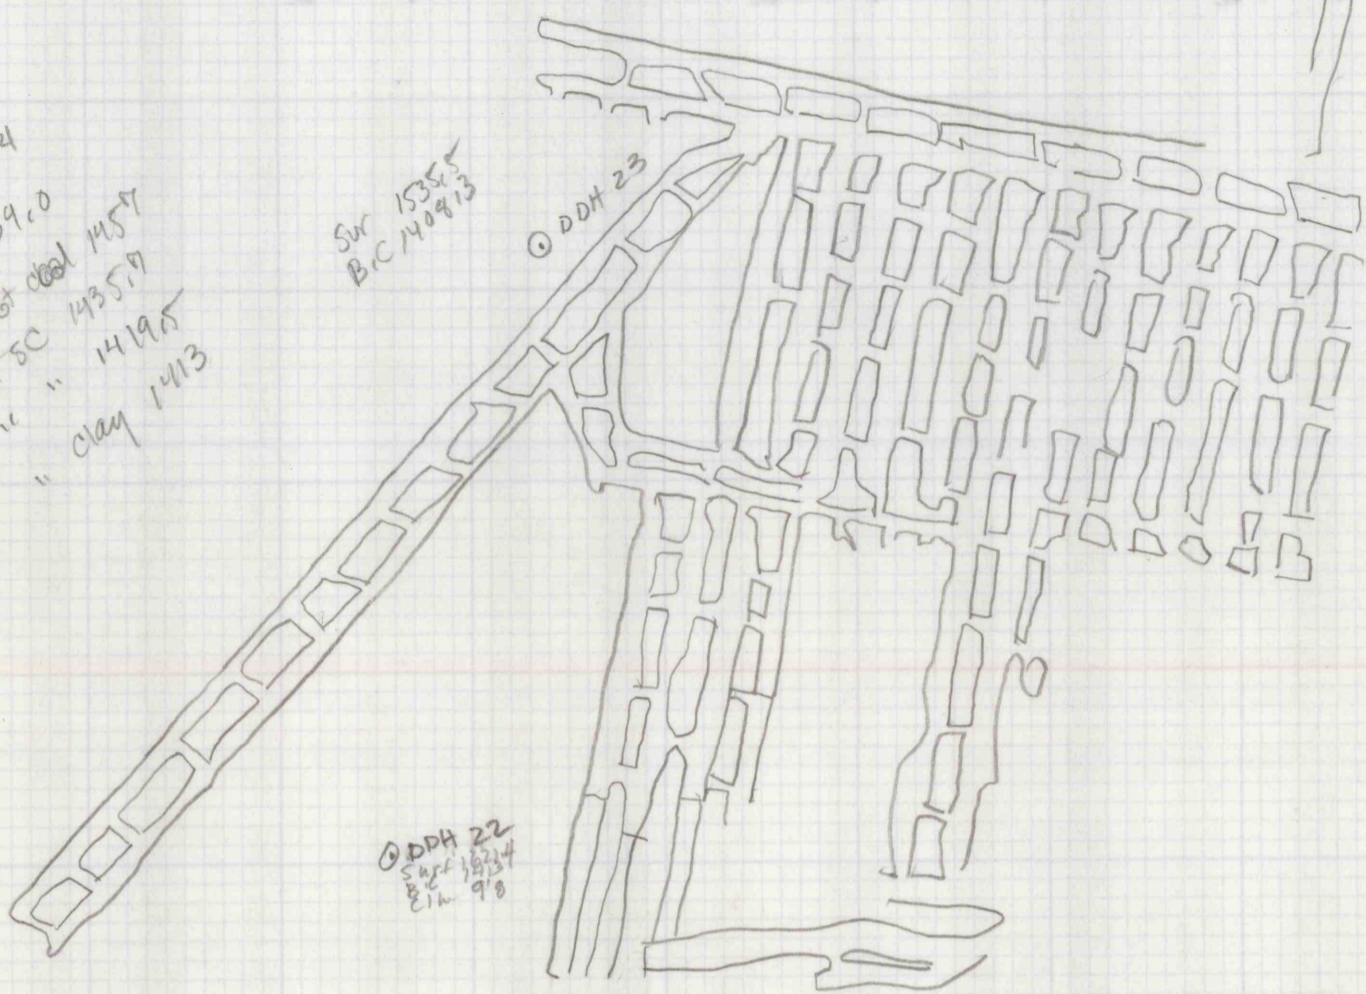

to coal mines

Tram R b

to CLAY MINES

