


5101 Hill 1170
Location Maps

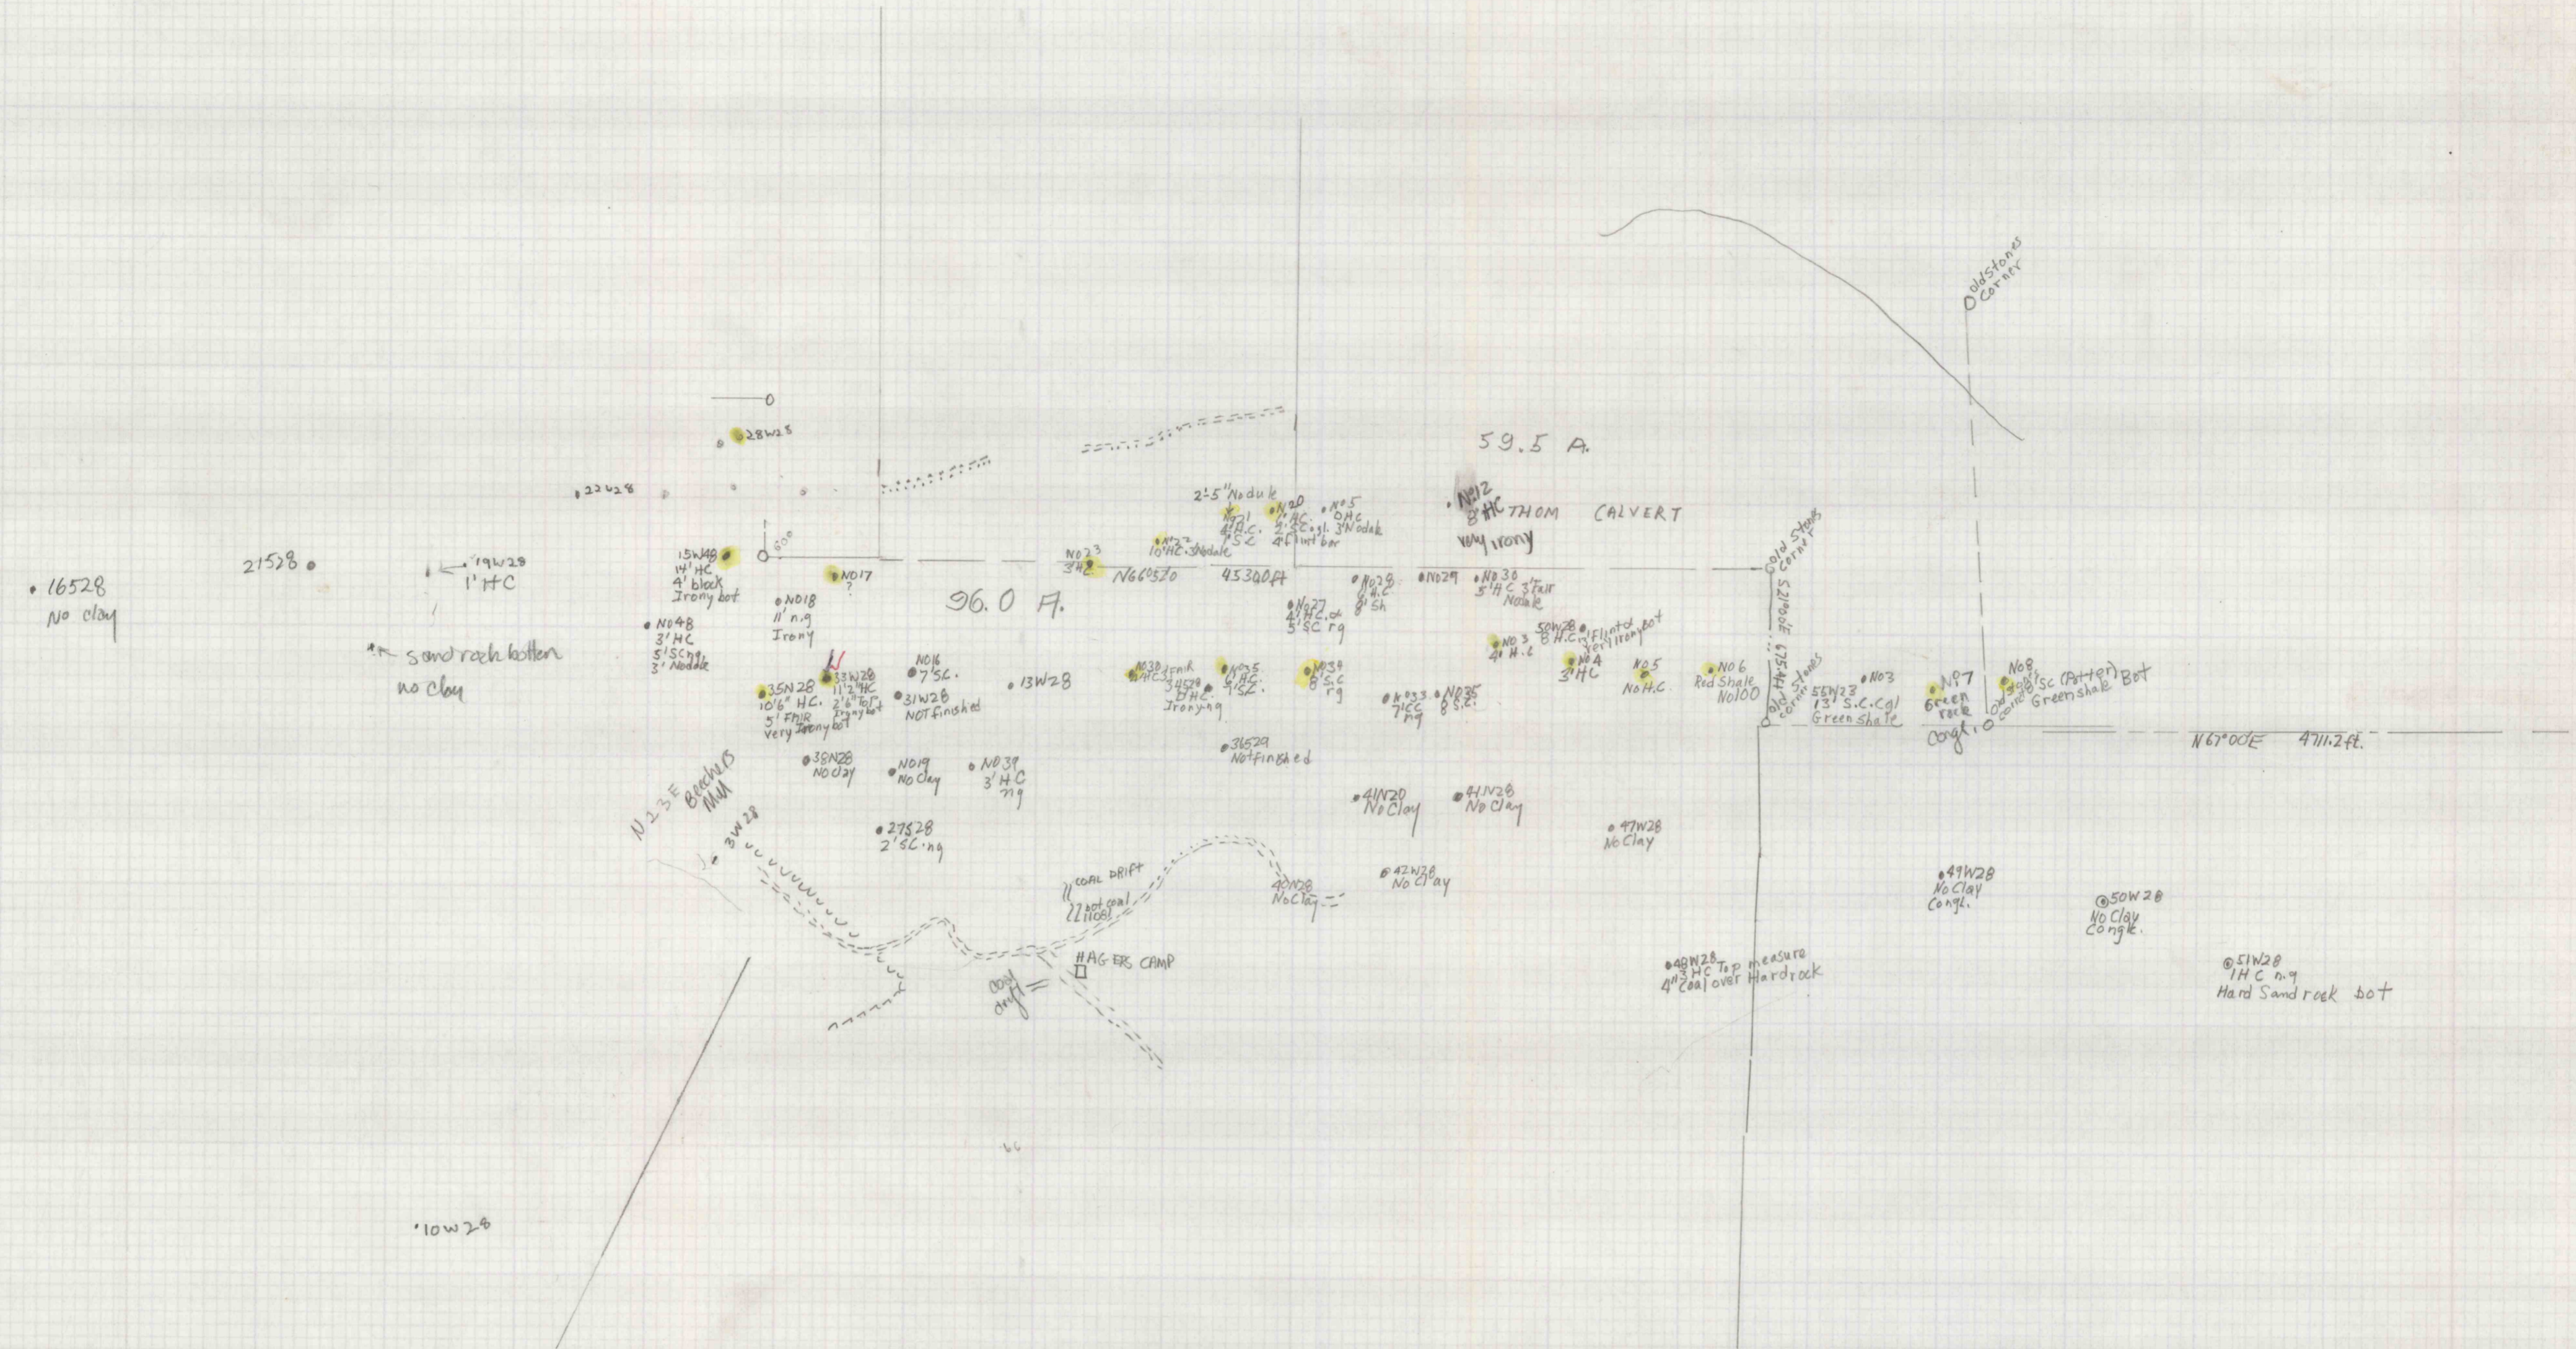

NARCO	960
SCHOLONAKER	49.3
LANSHE	47.0
CALVERT	59.5A
101M 2526.6 A	