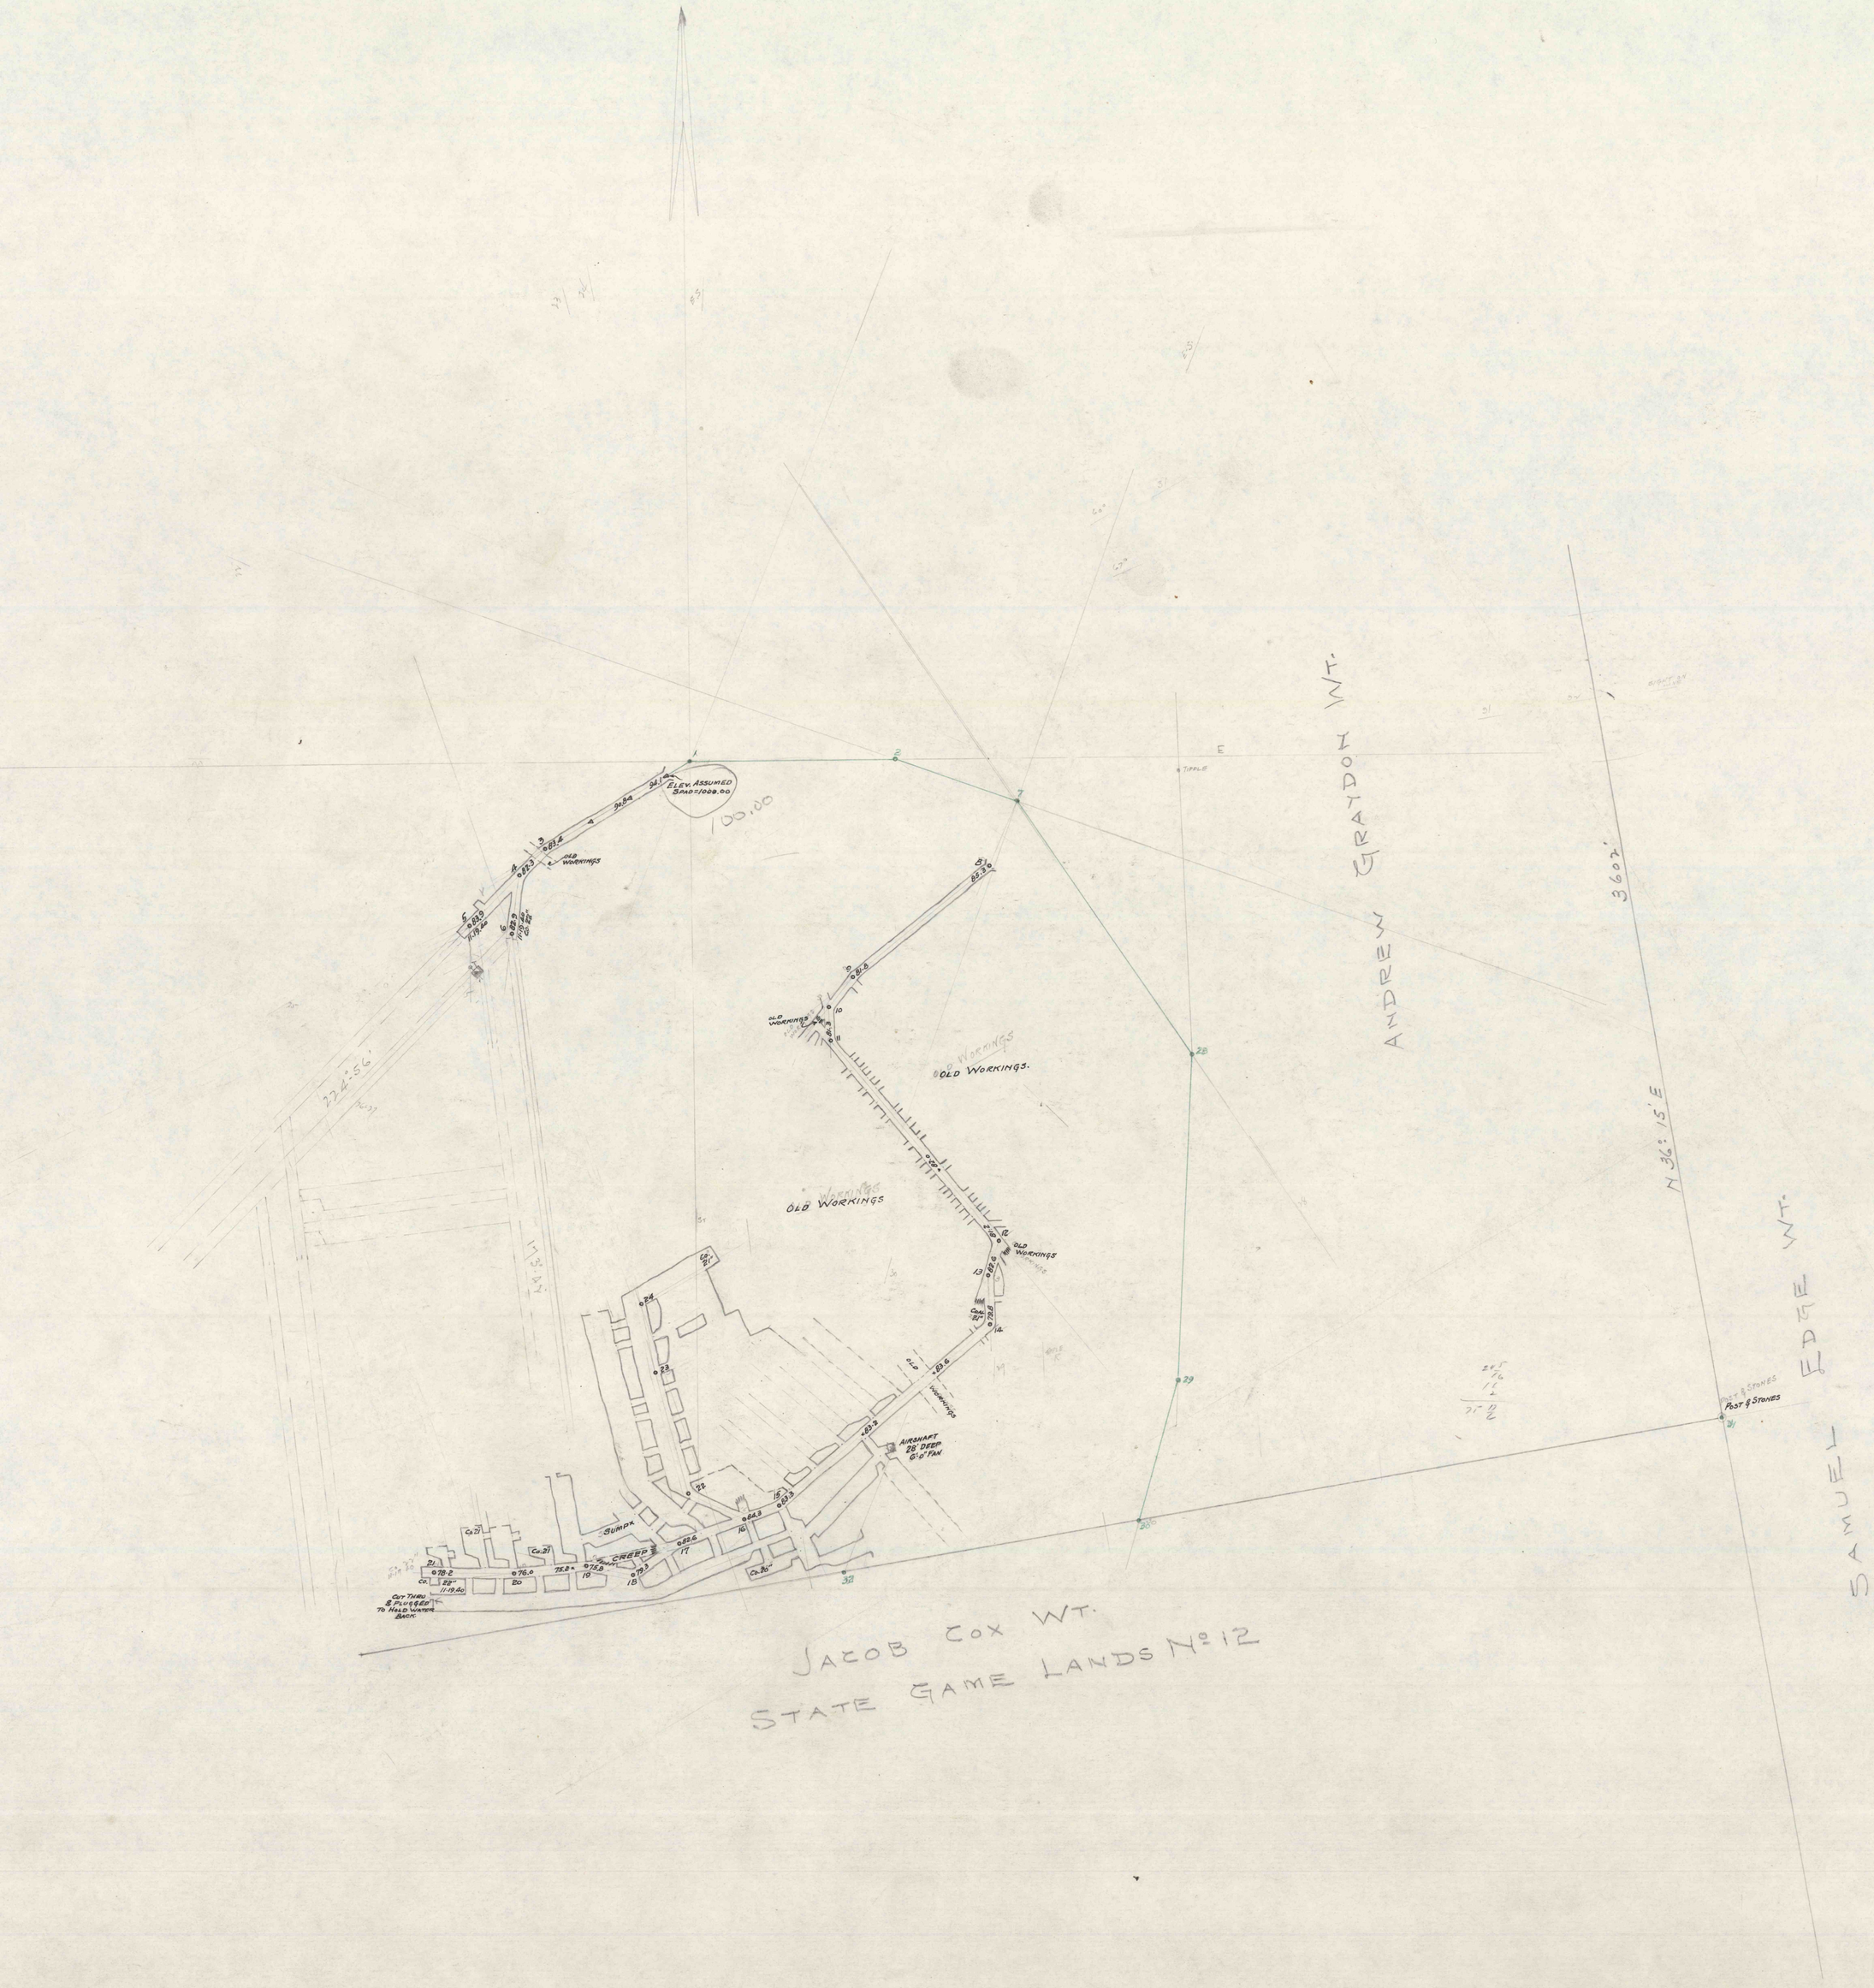

ELEV. ASSUMED SPAD=1000.00
100.00
OLD WORKINGS
OLD WORKINGS.
OLD WORKINGS
AIRSHAFT 28' DEEP 6'-0" FAN
SUMPX
CREEP
CUT THRU & PLUGGED TO HOLD WATER BACK
TIPPLE
ANDREW GRAYDON WT.
3602'
N 36° 15' E
SAMUEL EDGE WT.
POST & STONES
JACOB COX WT.
STATE GAME LANDS No 12