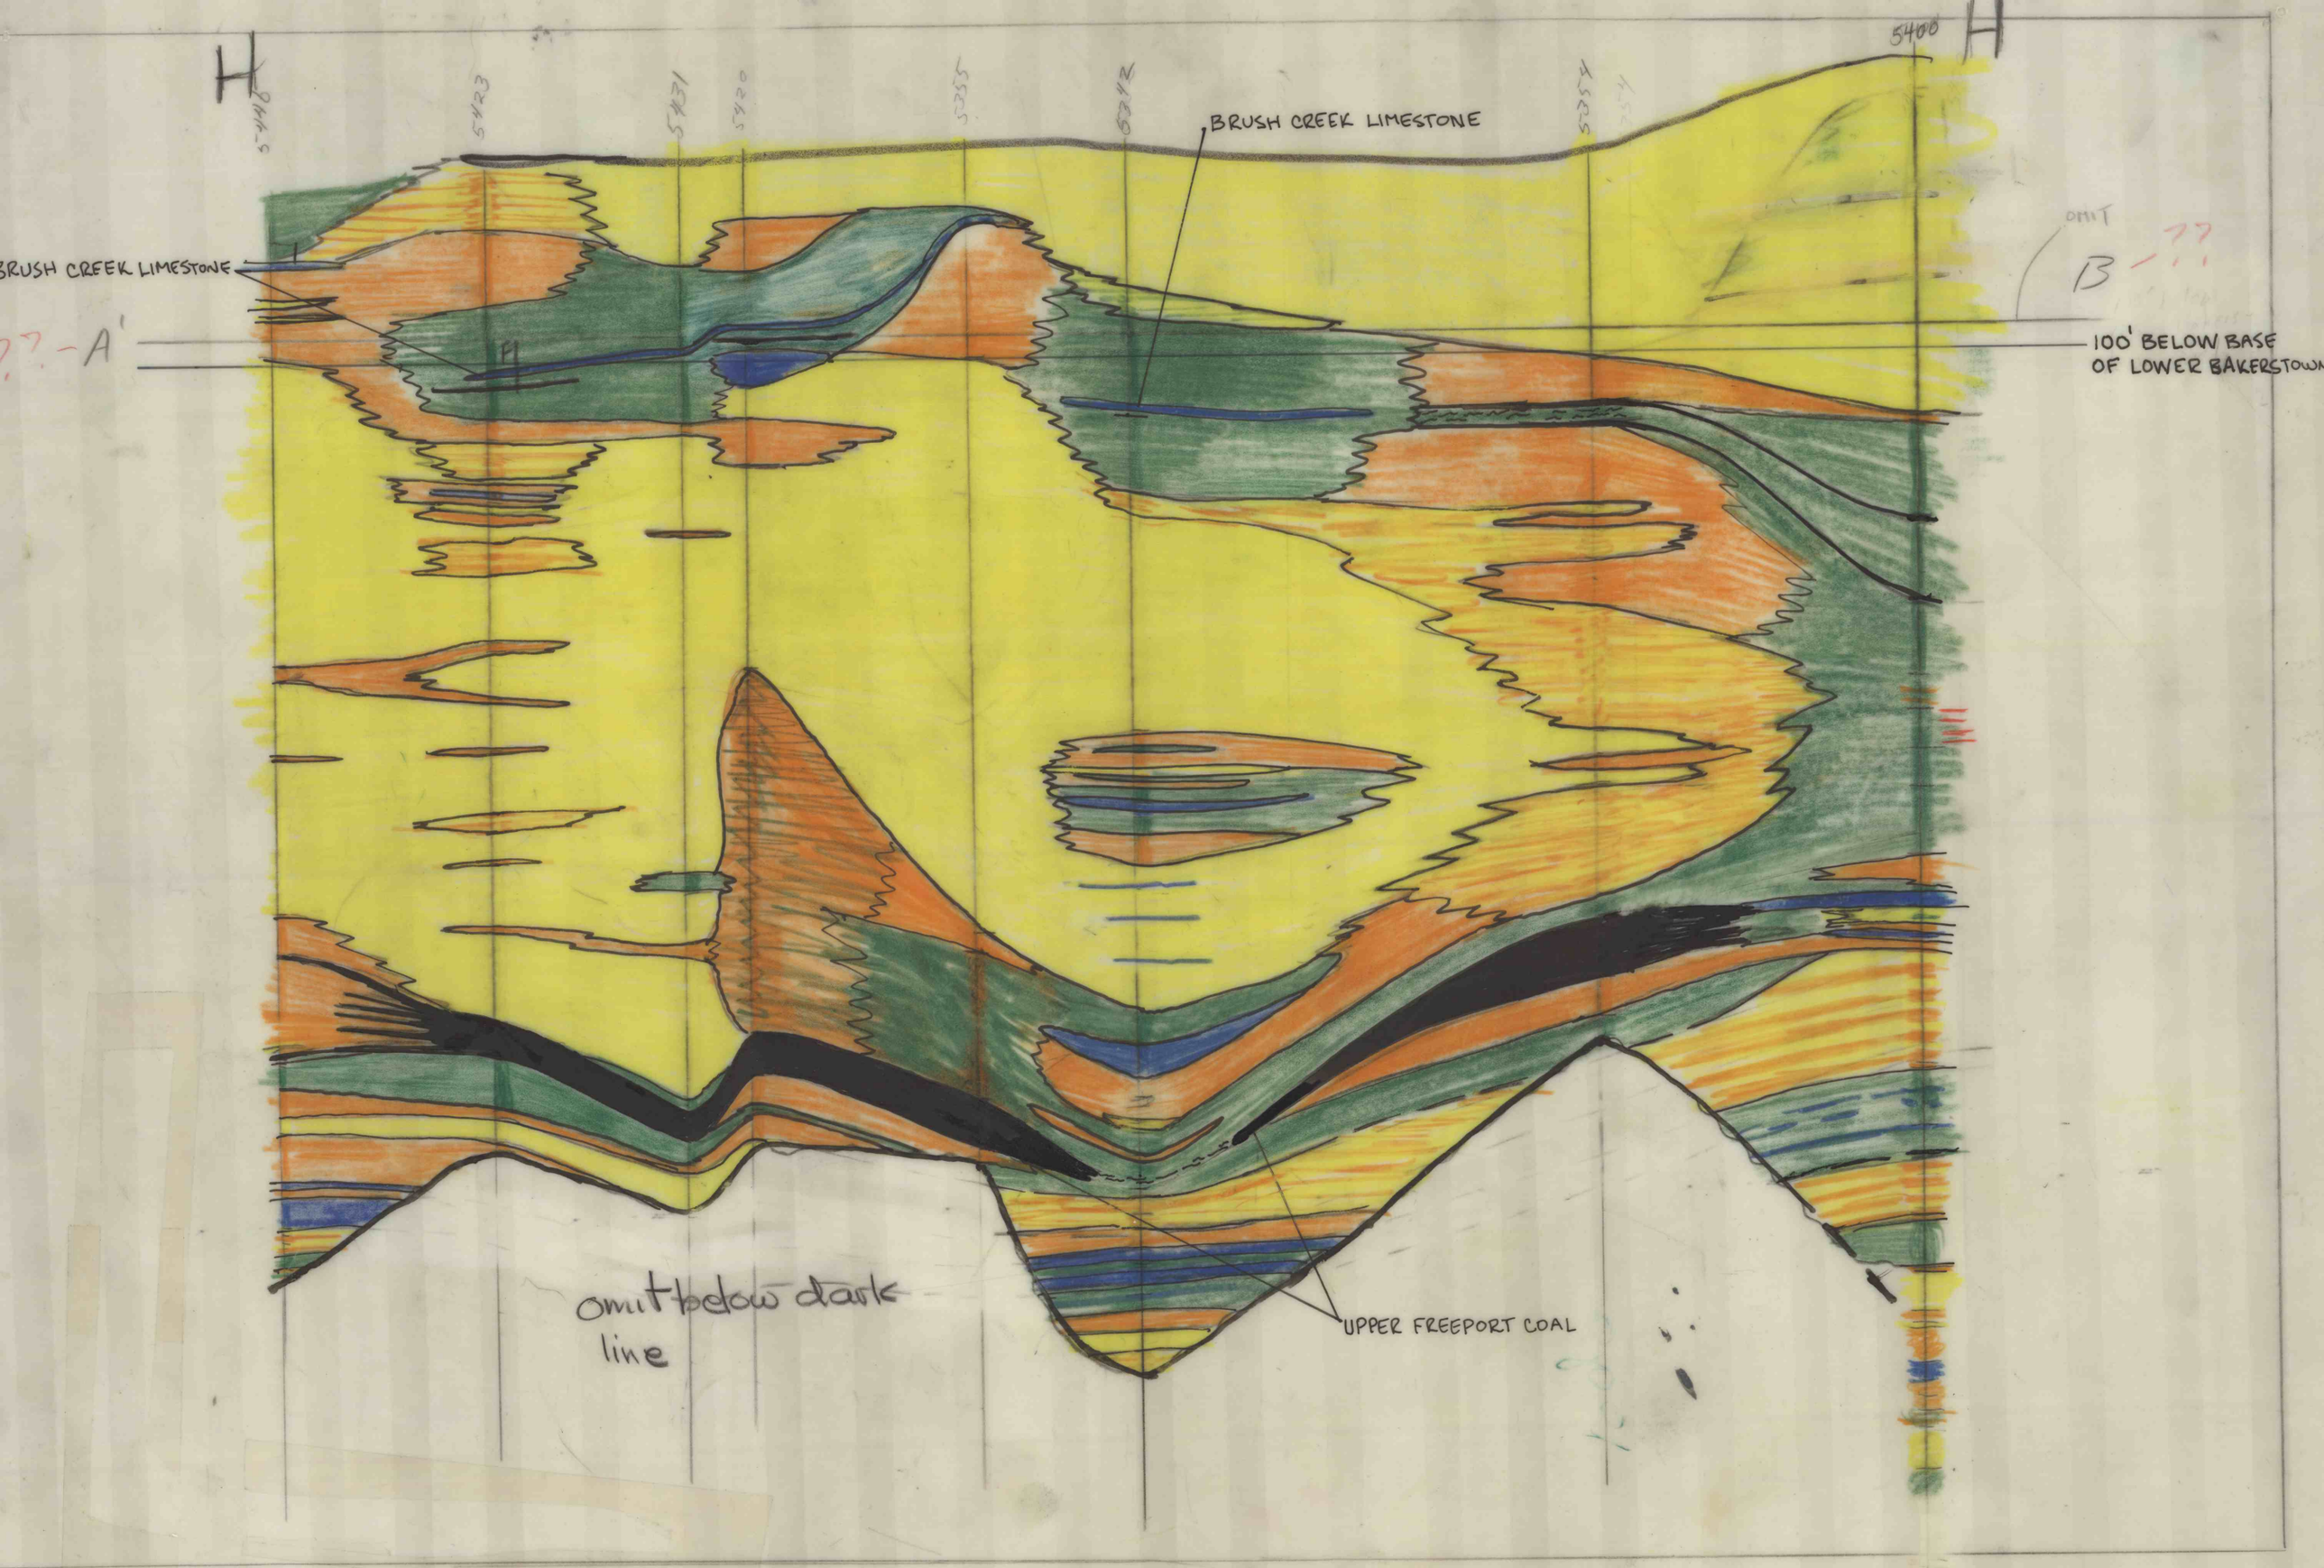

SEC H-H'

Vert. scale 1" = 20'

Horizontal 1" = 5000'

fig 3h

Shole
8-11-77