


Maveen Mine
306871
U.F. Coal

#1	#2
#4	#3

#1

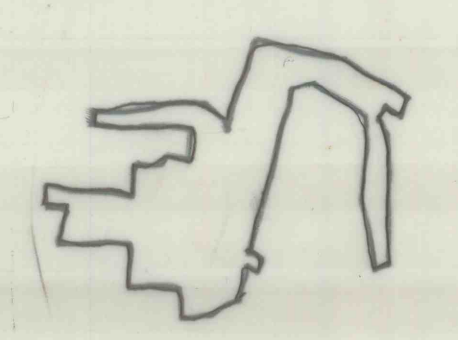


Bowen Mine

960

960

960

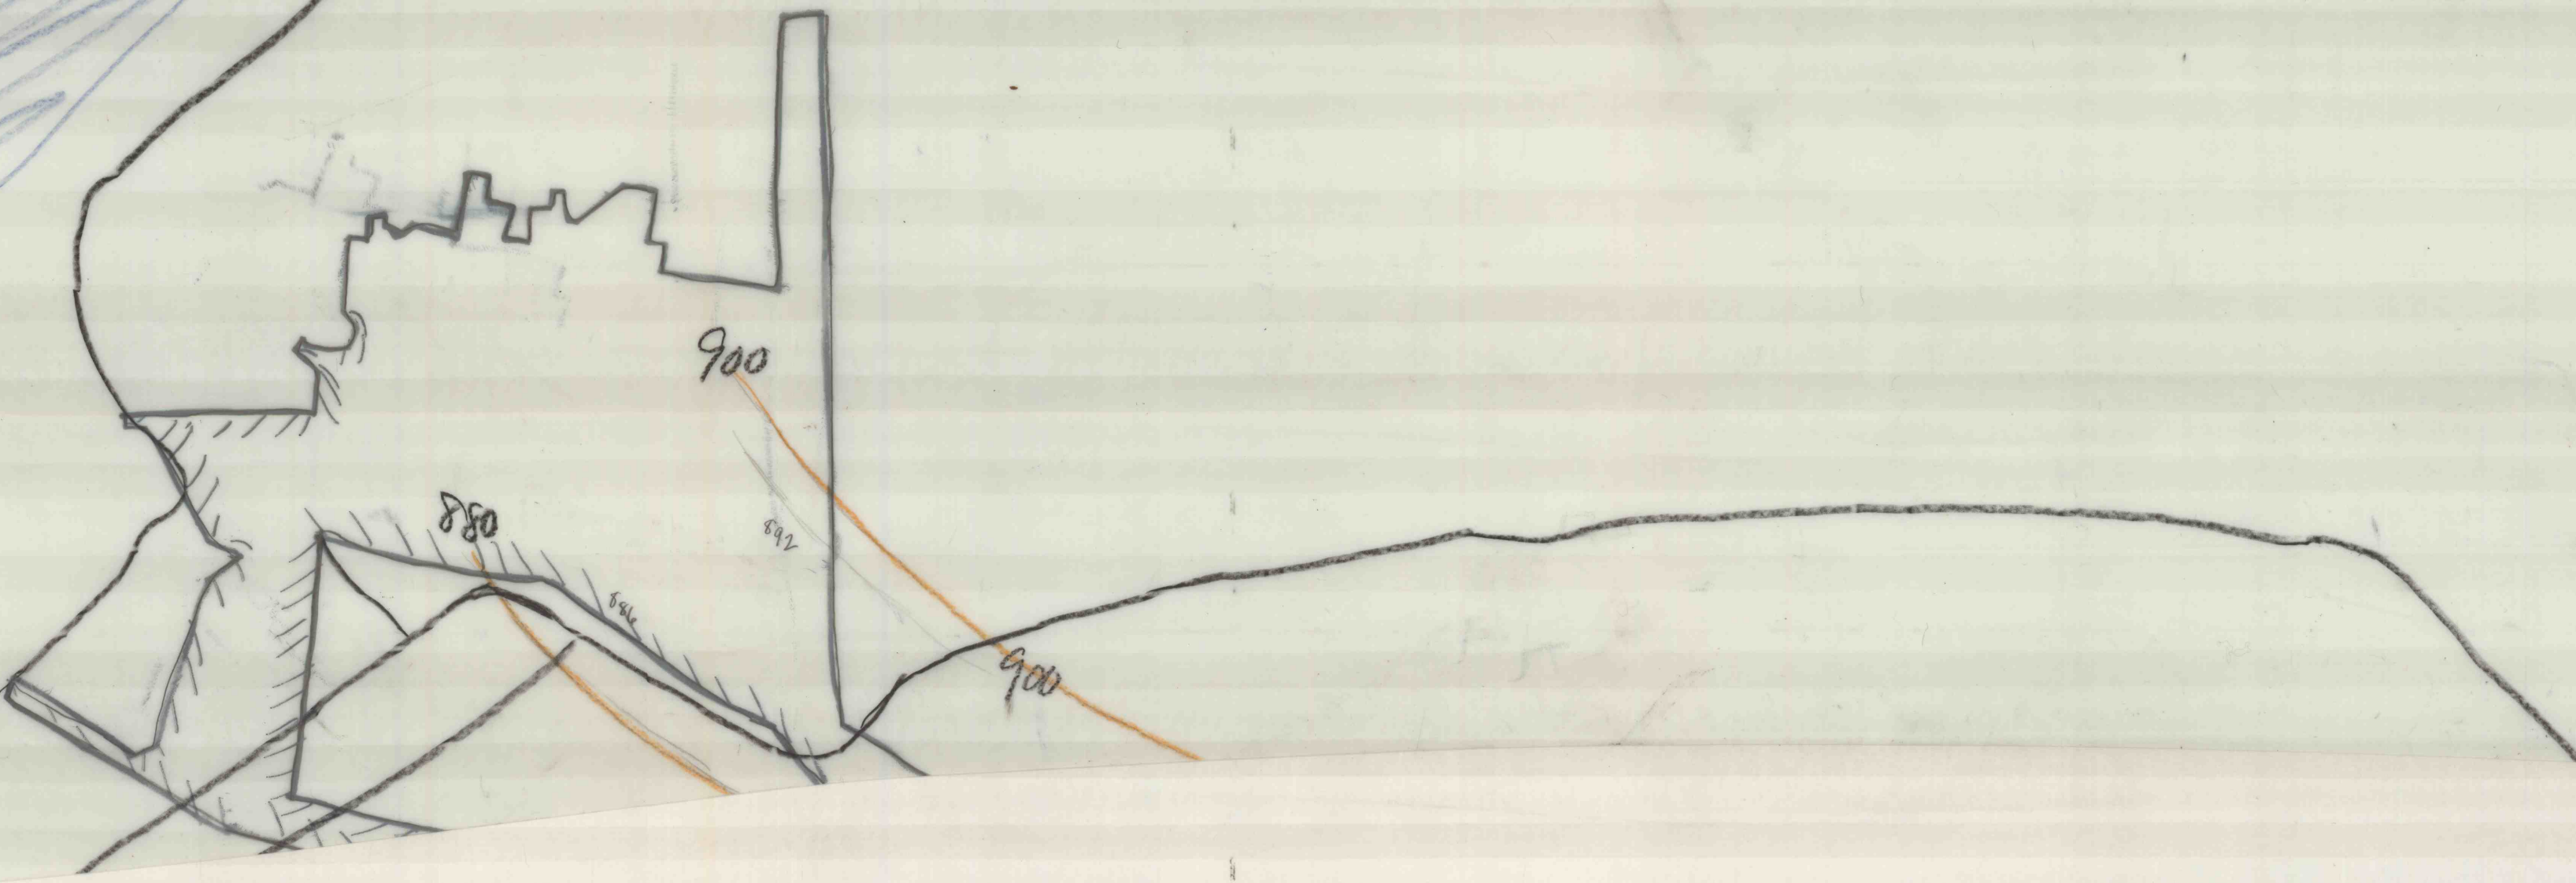

900

900

950

911

98

957

912?

948

93

97

