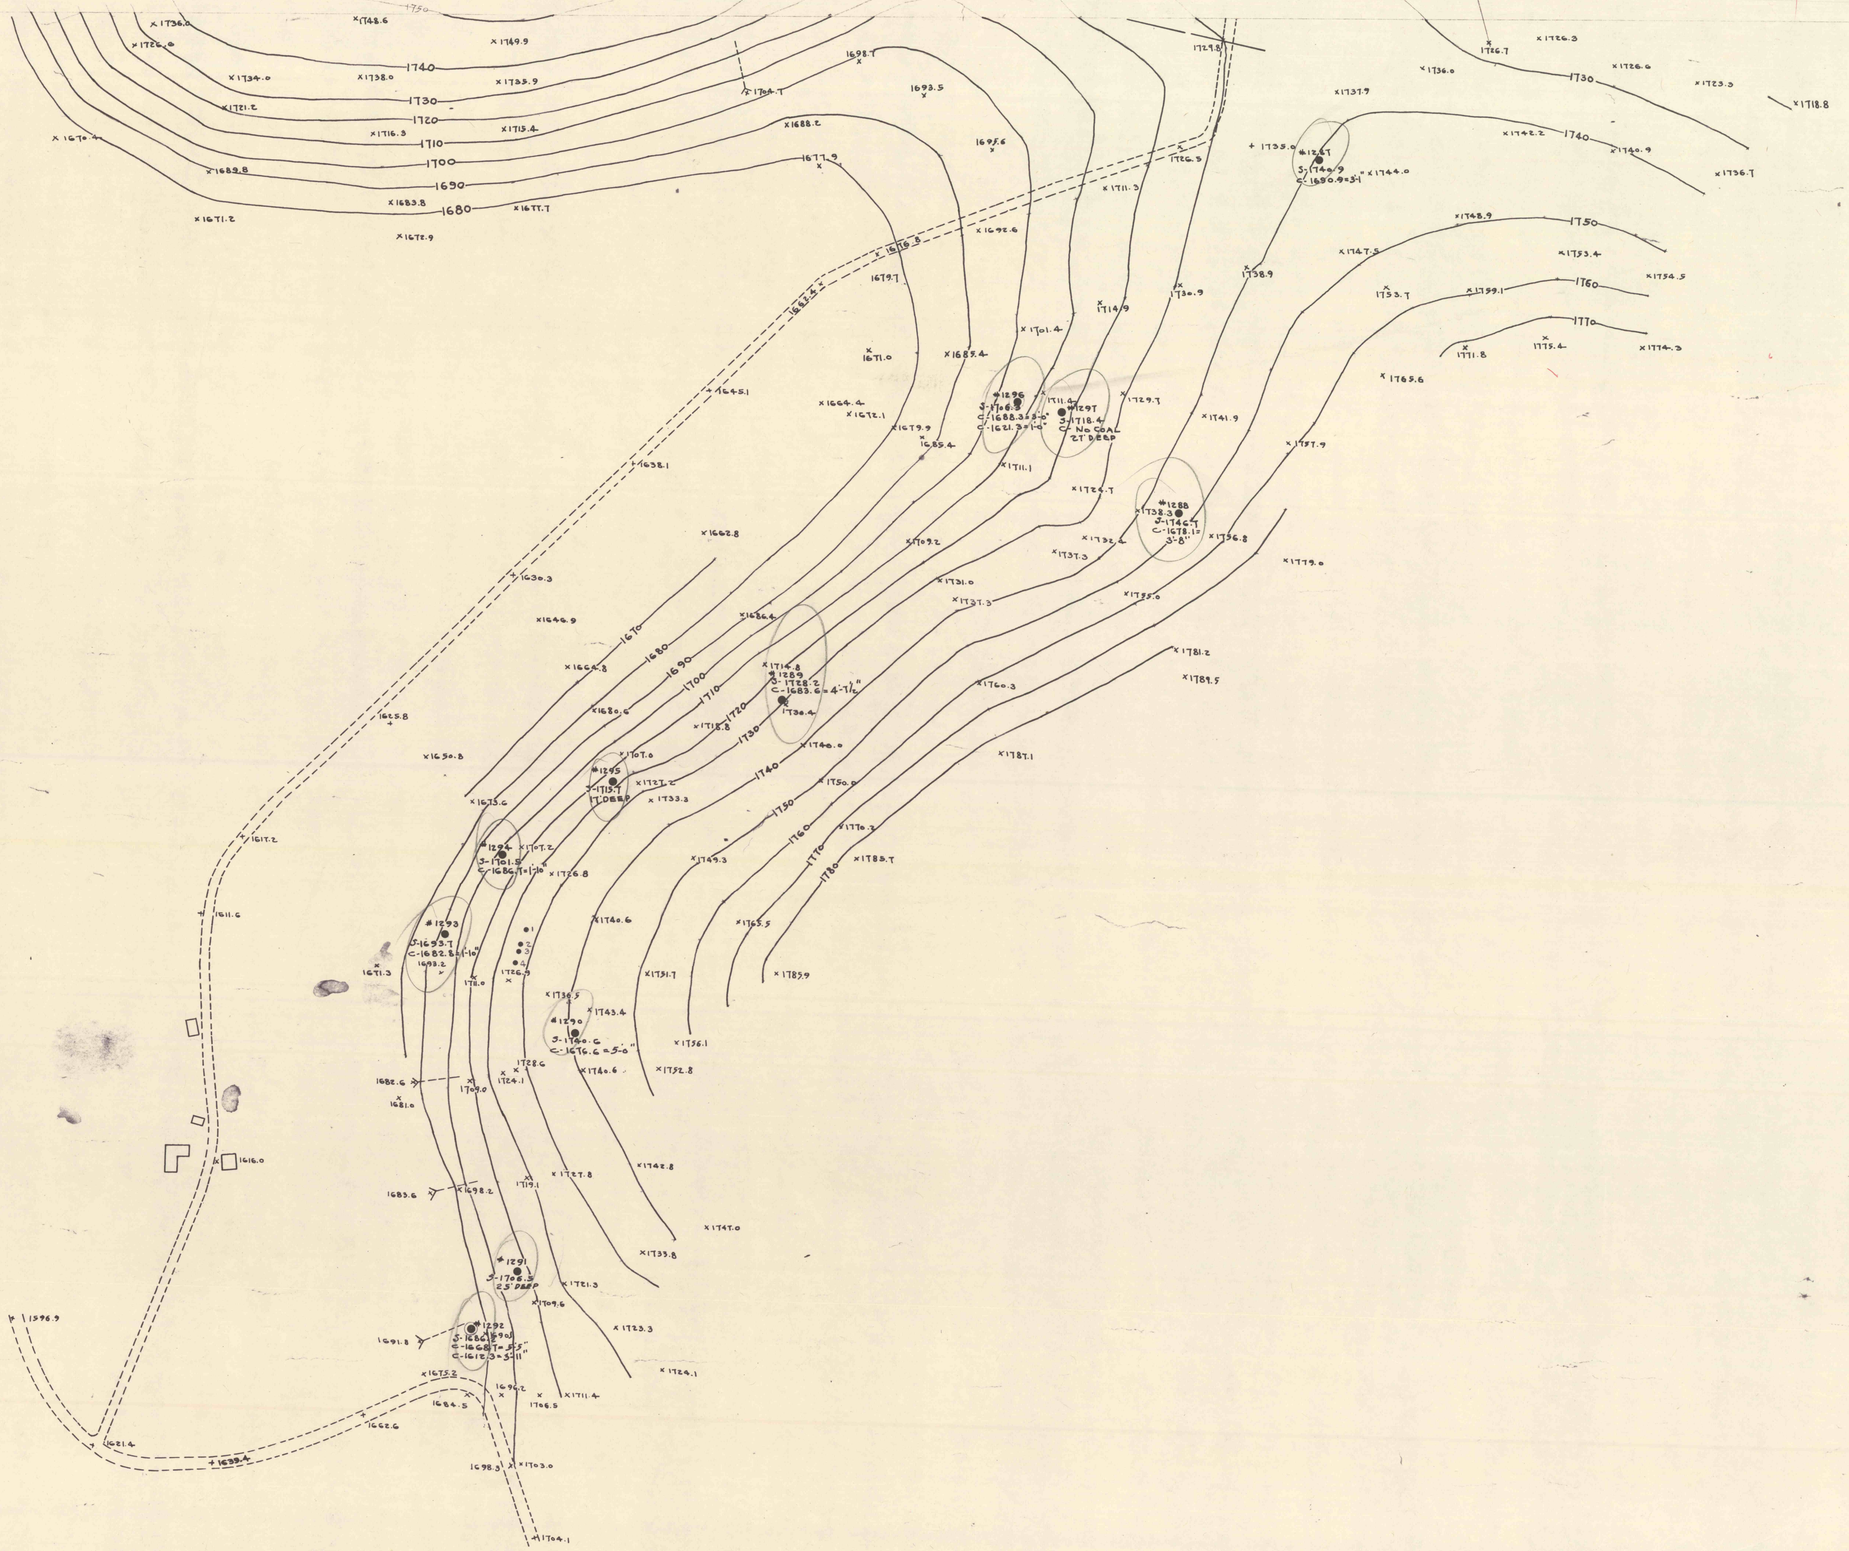
1740
1730
1720
1710
1700
1690
1680
1670
1750
1760
1770
1780
#1287
S-1740.9
C-1690.9=3'-1"
#1296
S-1706.3
C-1688.3=3'-0"
C-1621.3=1'-0"
#1297
S-1718.4
C-NO COAL
27' DEEP
#1288
S-1738.3
C-1678.1=
3'-8"
#1289
S-1728.2
C-1683.6=4'-7½"
#1295
S-1713.7
17' DEEP
#1294
S-1701.5
C-1686.7=1'-10"
#1293
S-1693.7
C-1682.8=1'-10"
#1290
S-1740.6
C-1676.6=5'-0"
#1291
S-1706.5
25' DEEP
#1292
S-1686.1
C-1668.7=5'-5"
C-1612.3=3'-11"