


W. 4,000

W. 8,000

W. 12,000

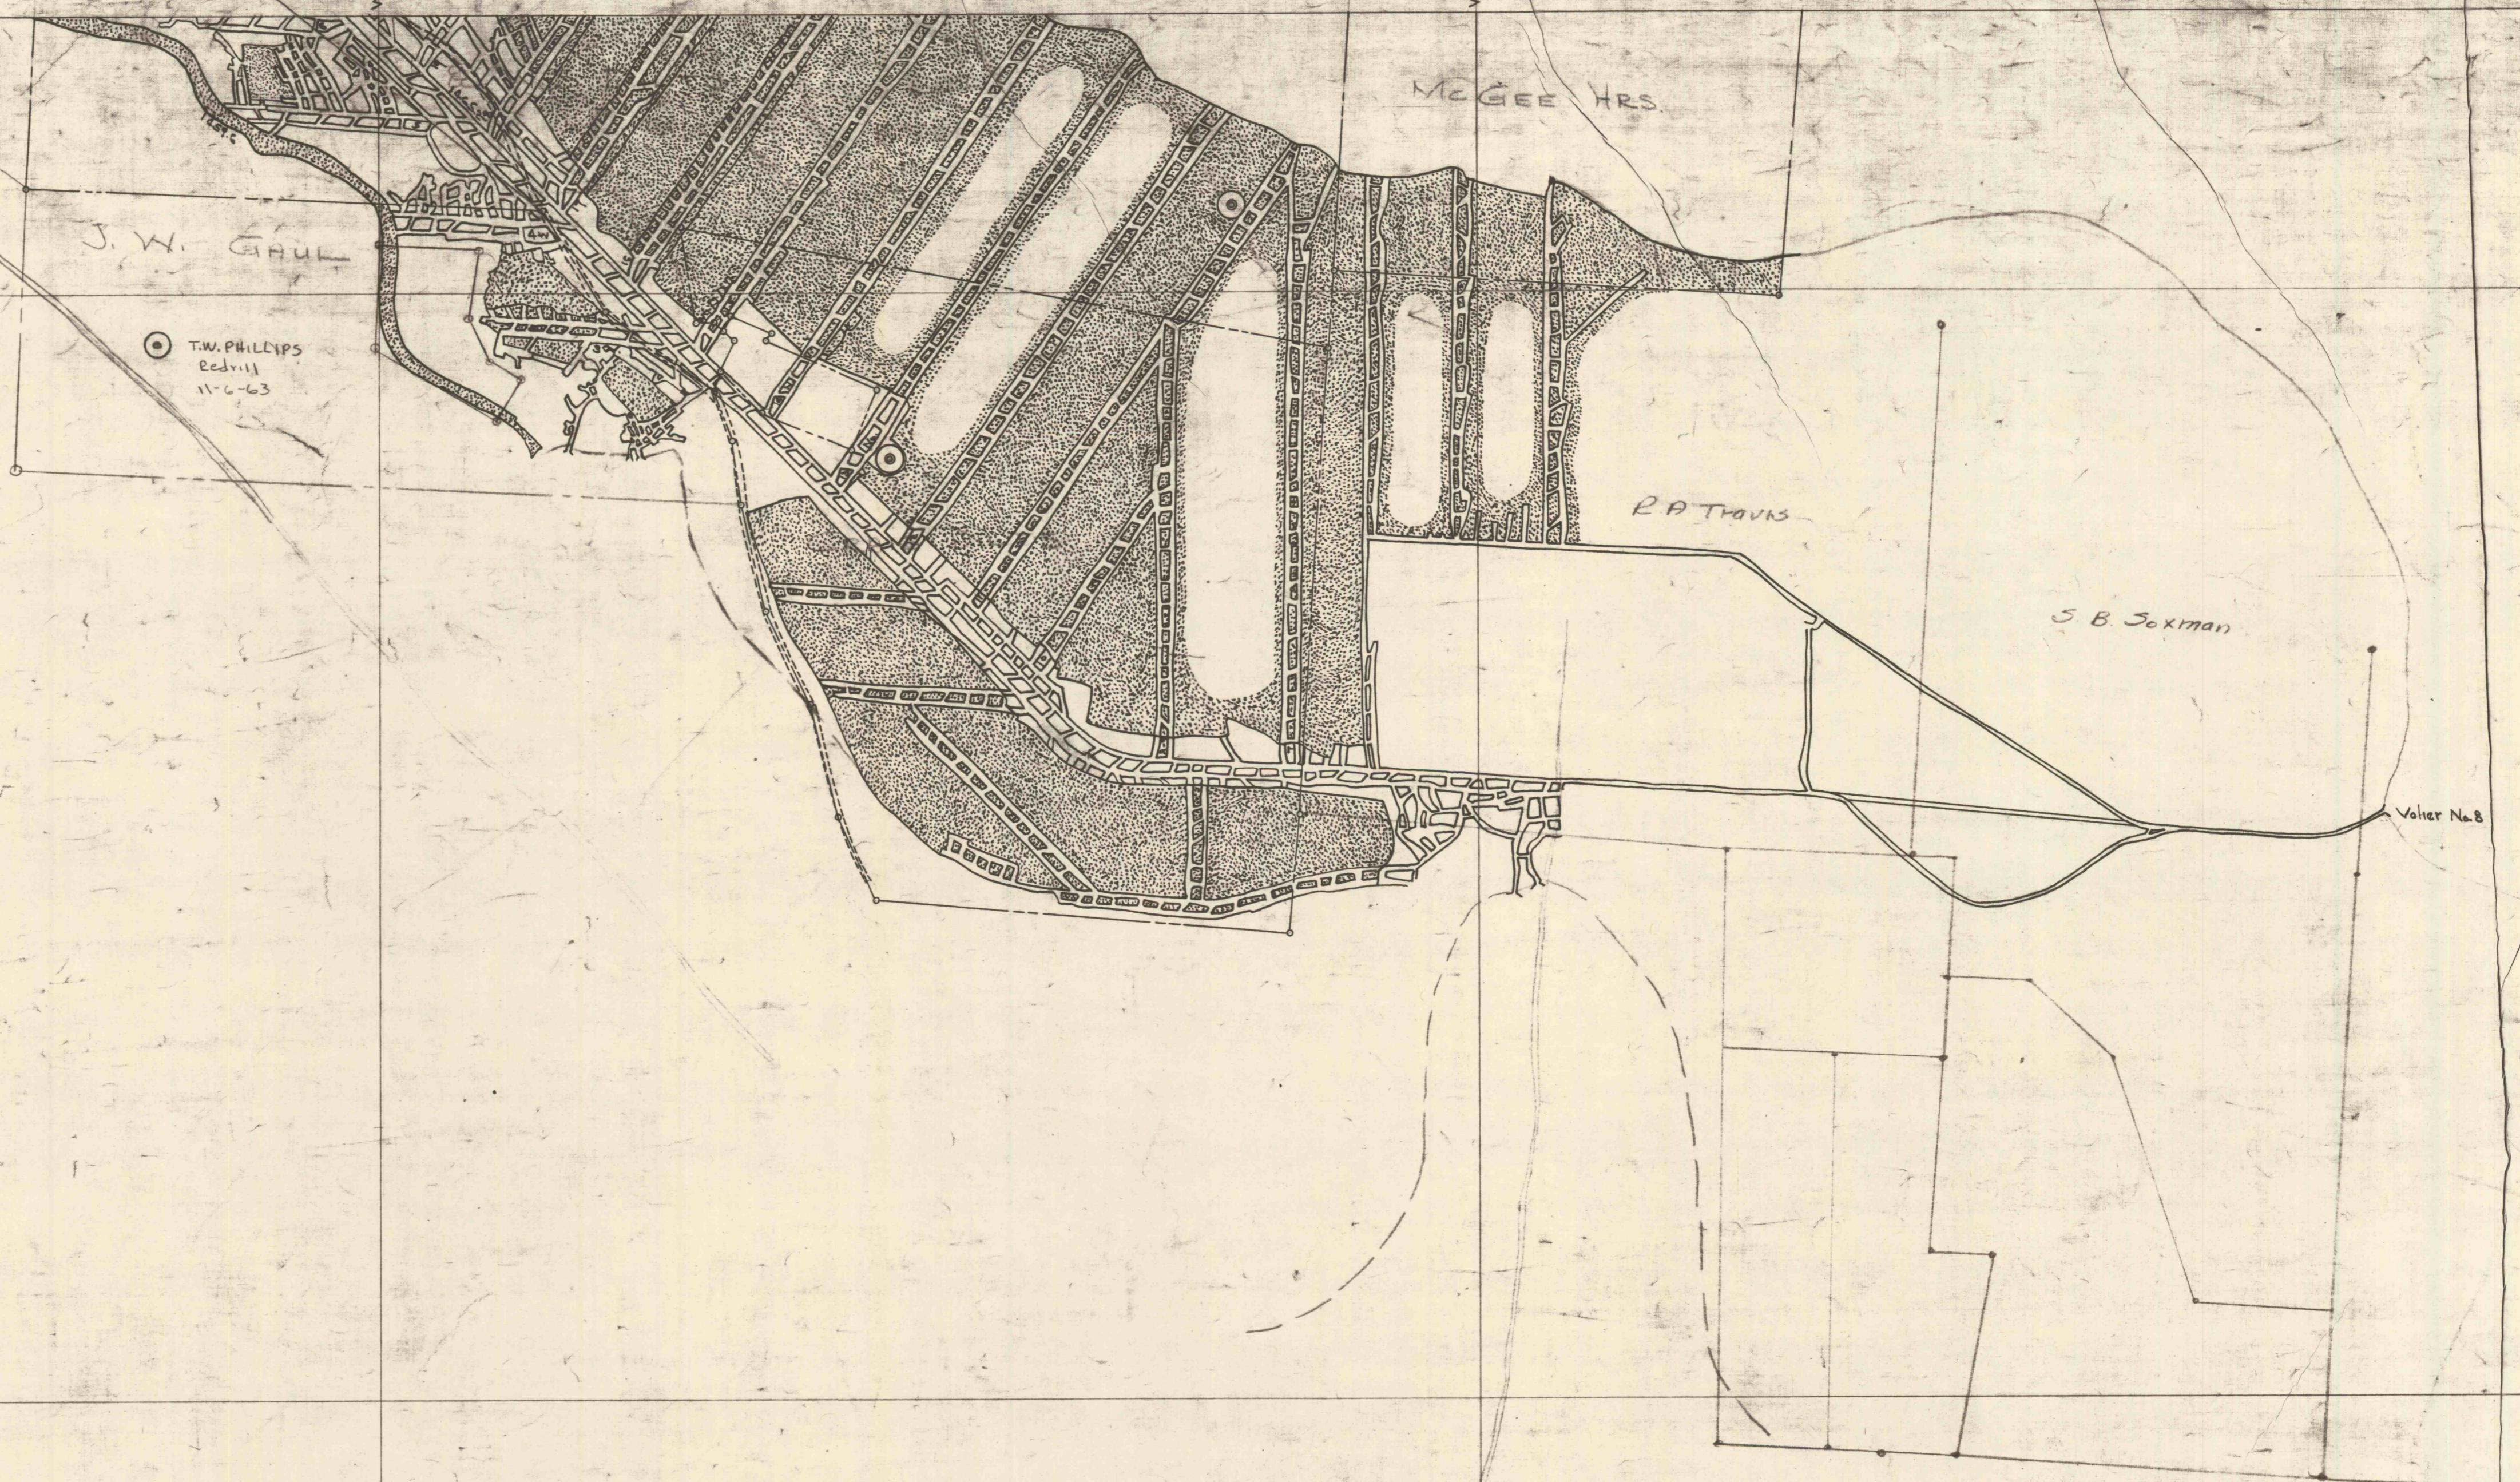

S. 8,000

S. 12,000

S. 16,000

S. 19,000