


400 Ft.

400 Ft.

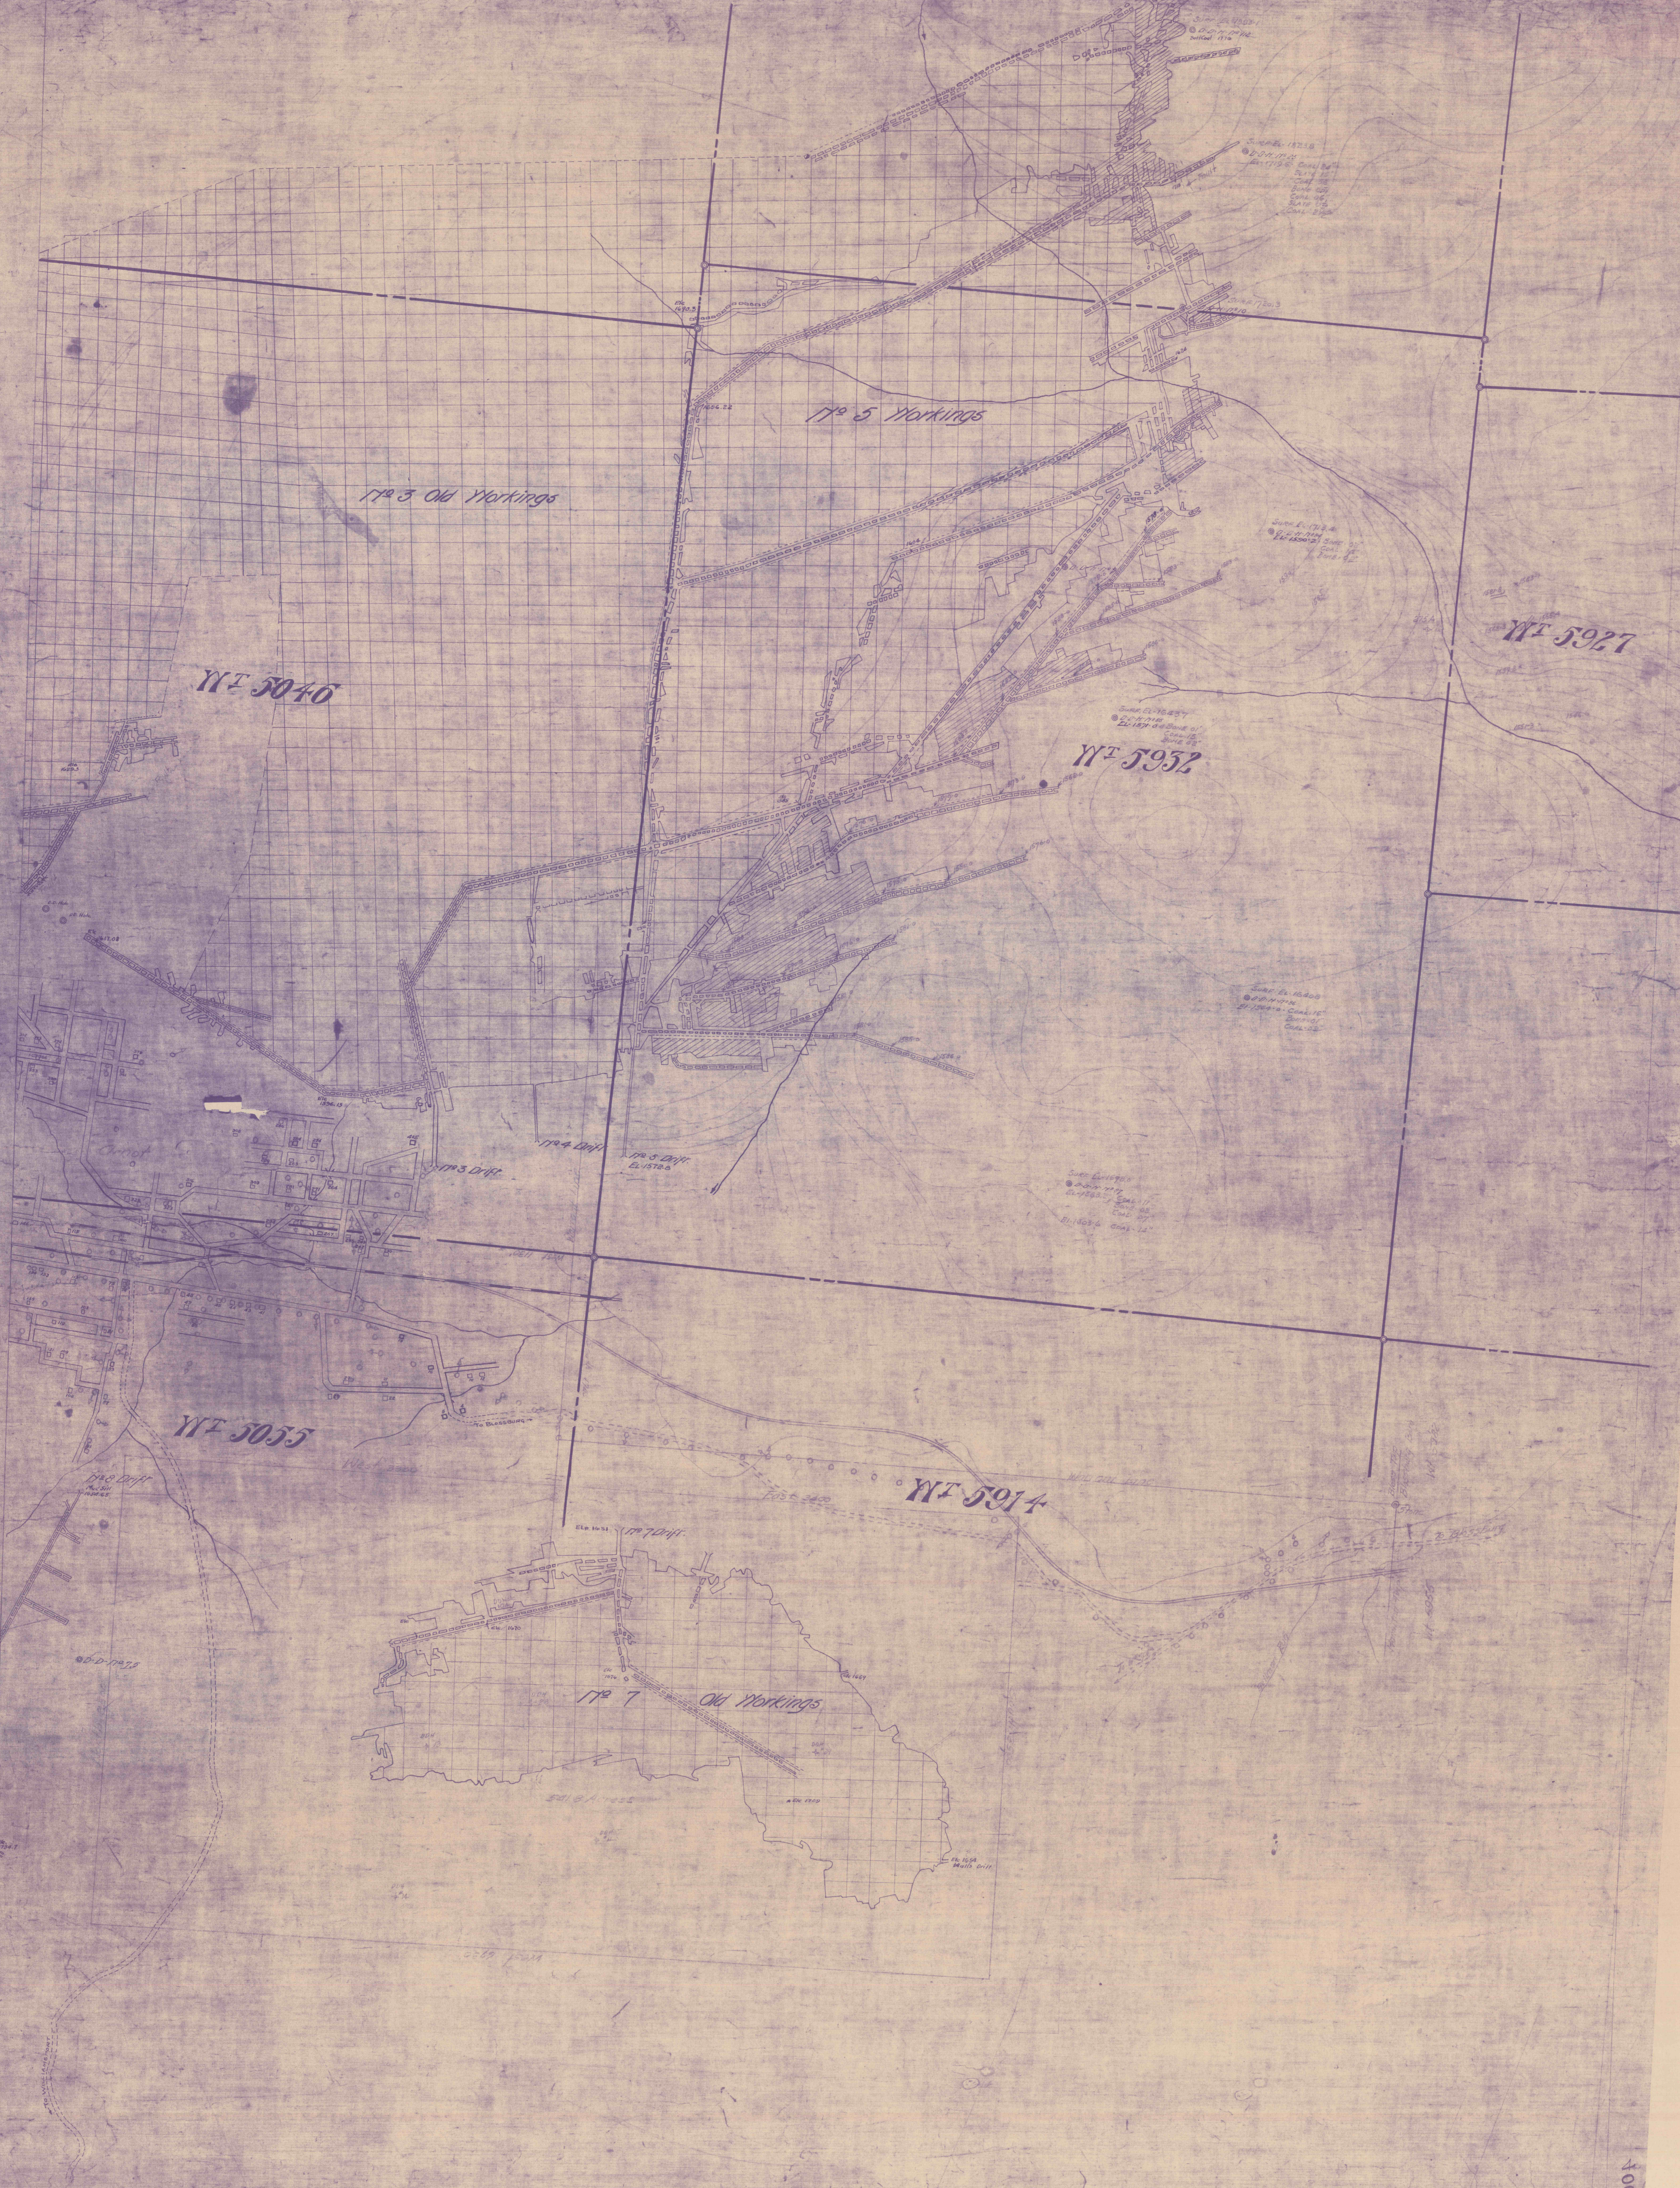

400 Ft.

400 Ft.