

- 1 Screen back base map
- 2 Add scale
- 3 Add Lat-Long ticks

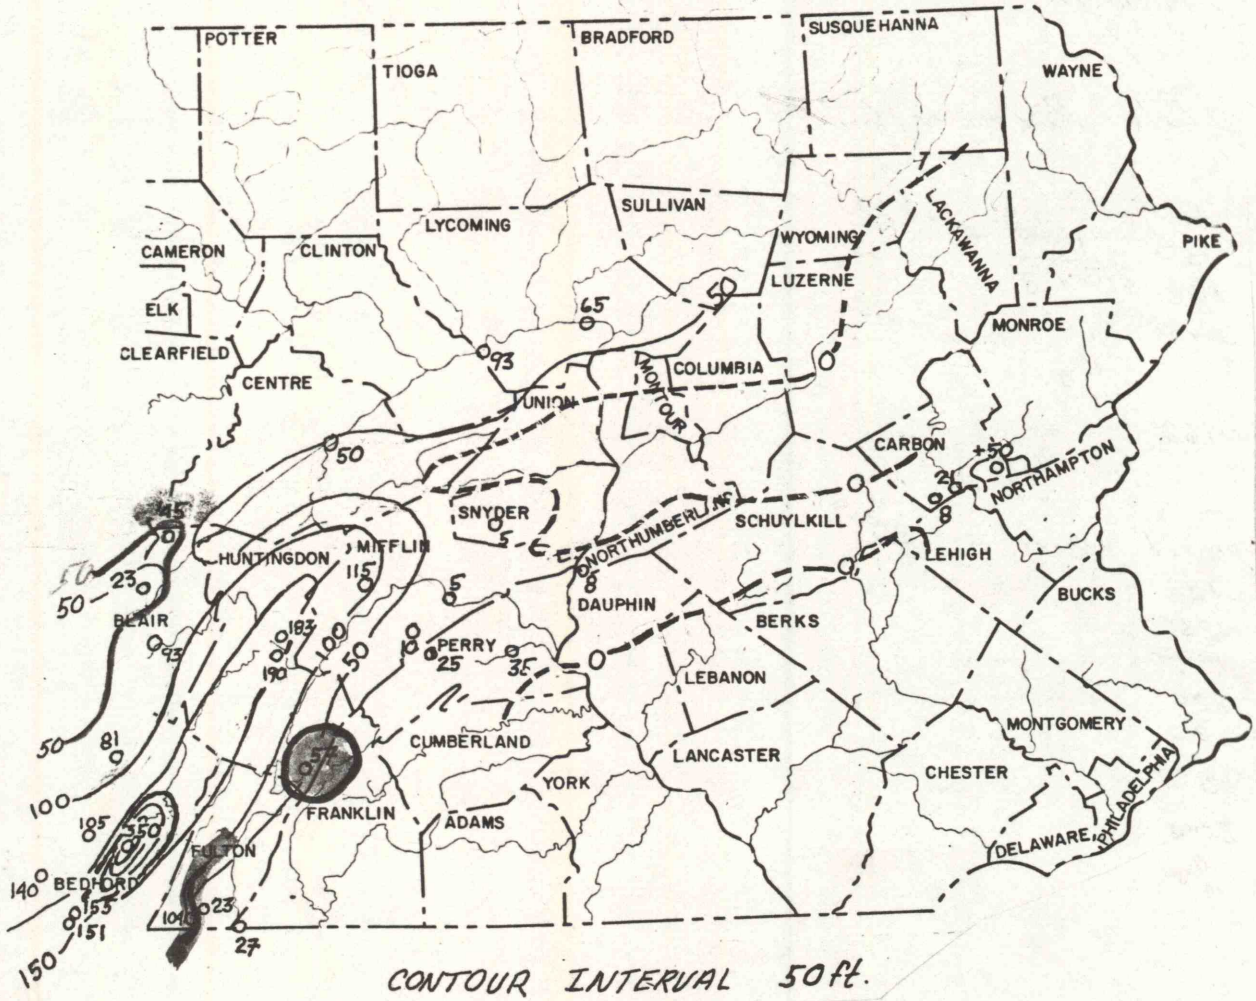


FIGURE 3. Generalized isopach^{map} of the Devonian "Oriskany" or Ridgely Member of the Old Port Formation in eastern Pennsylvania. Data compiled from Abel and Heyman (1981), ~~Contin and Hoskins (1962)~~, ~~de Witl (1974)~~, ~~Dyson (1963)~~, ~~Fettke (1919)~~, ~~Inners (1975)~~, ~~Miller (1961)~~, ~~Wells and Bucek (1980)~~, and Willard and others (1939).

Dennison and others (1979)

Epstein and others (1974)

Faill and others (in press)