
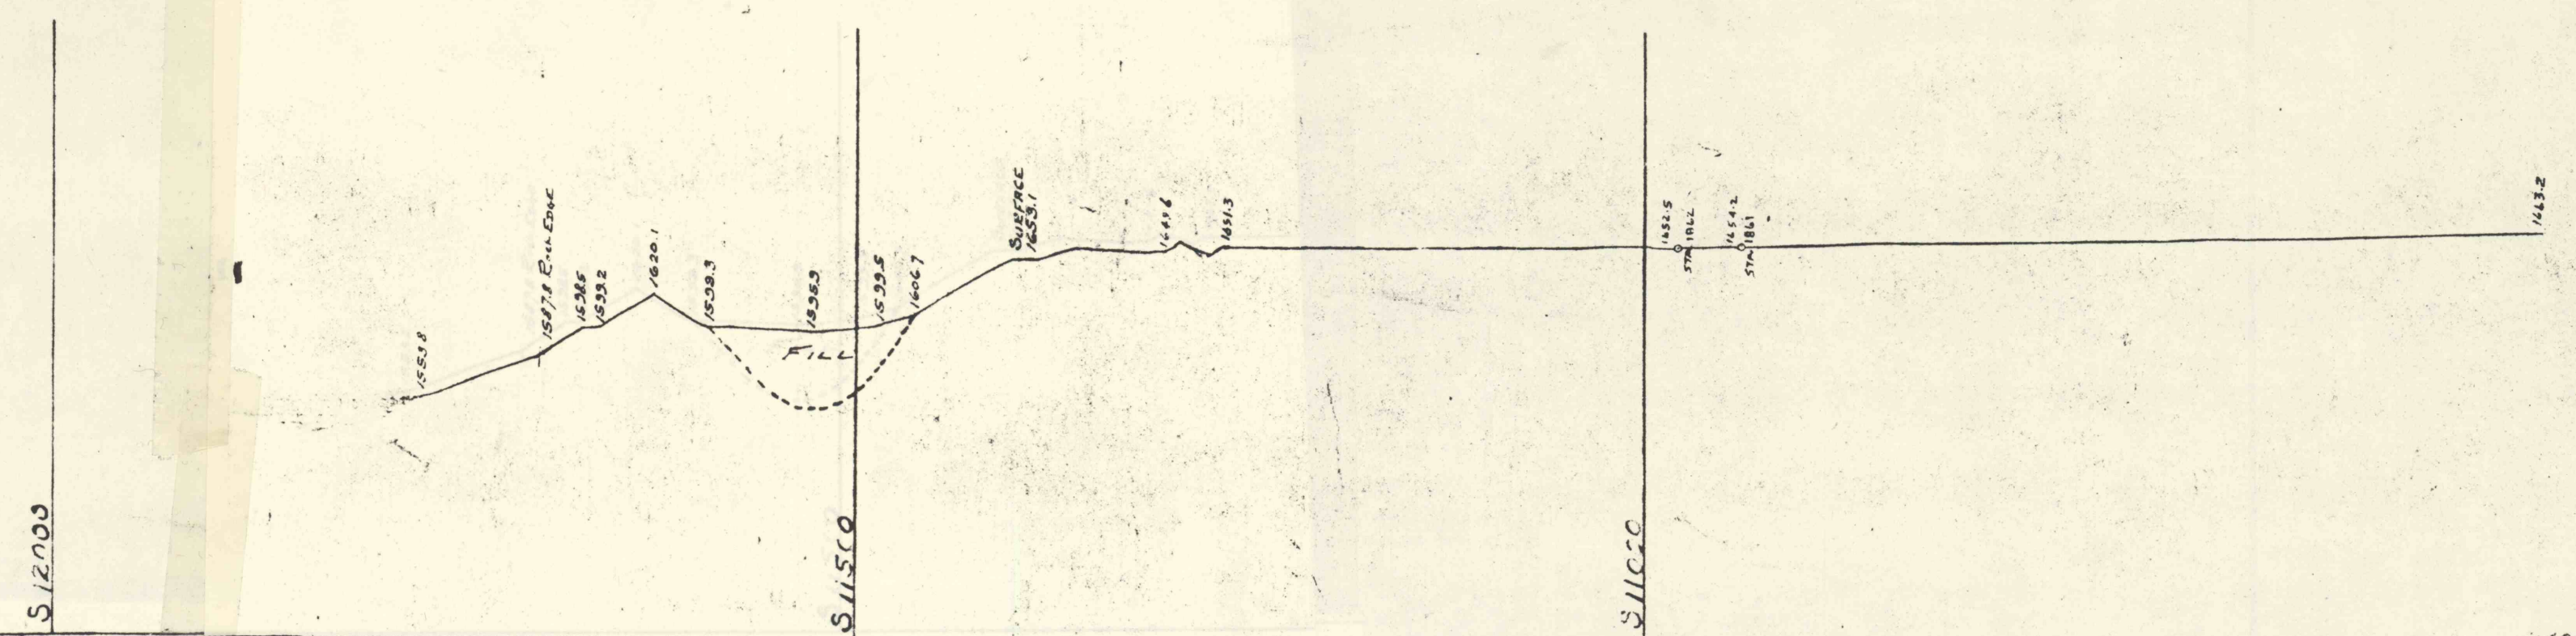




SECTION NO. 33

SCALE 1"=100'

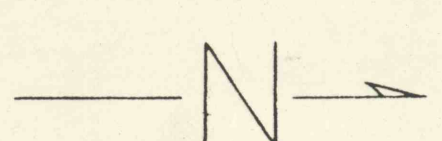



SECTION NO. 32

SCALE 1"=100'

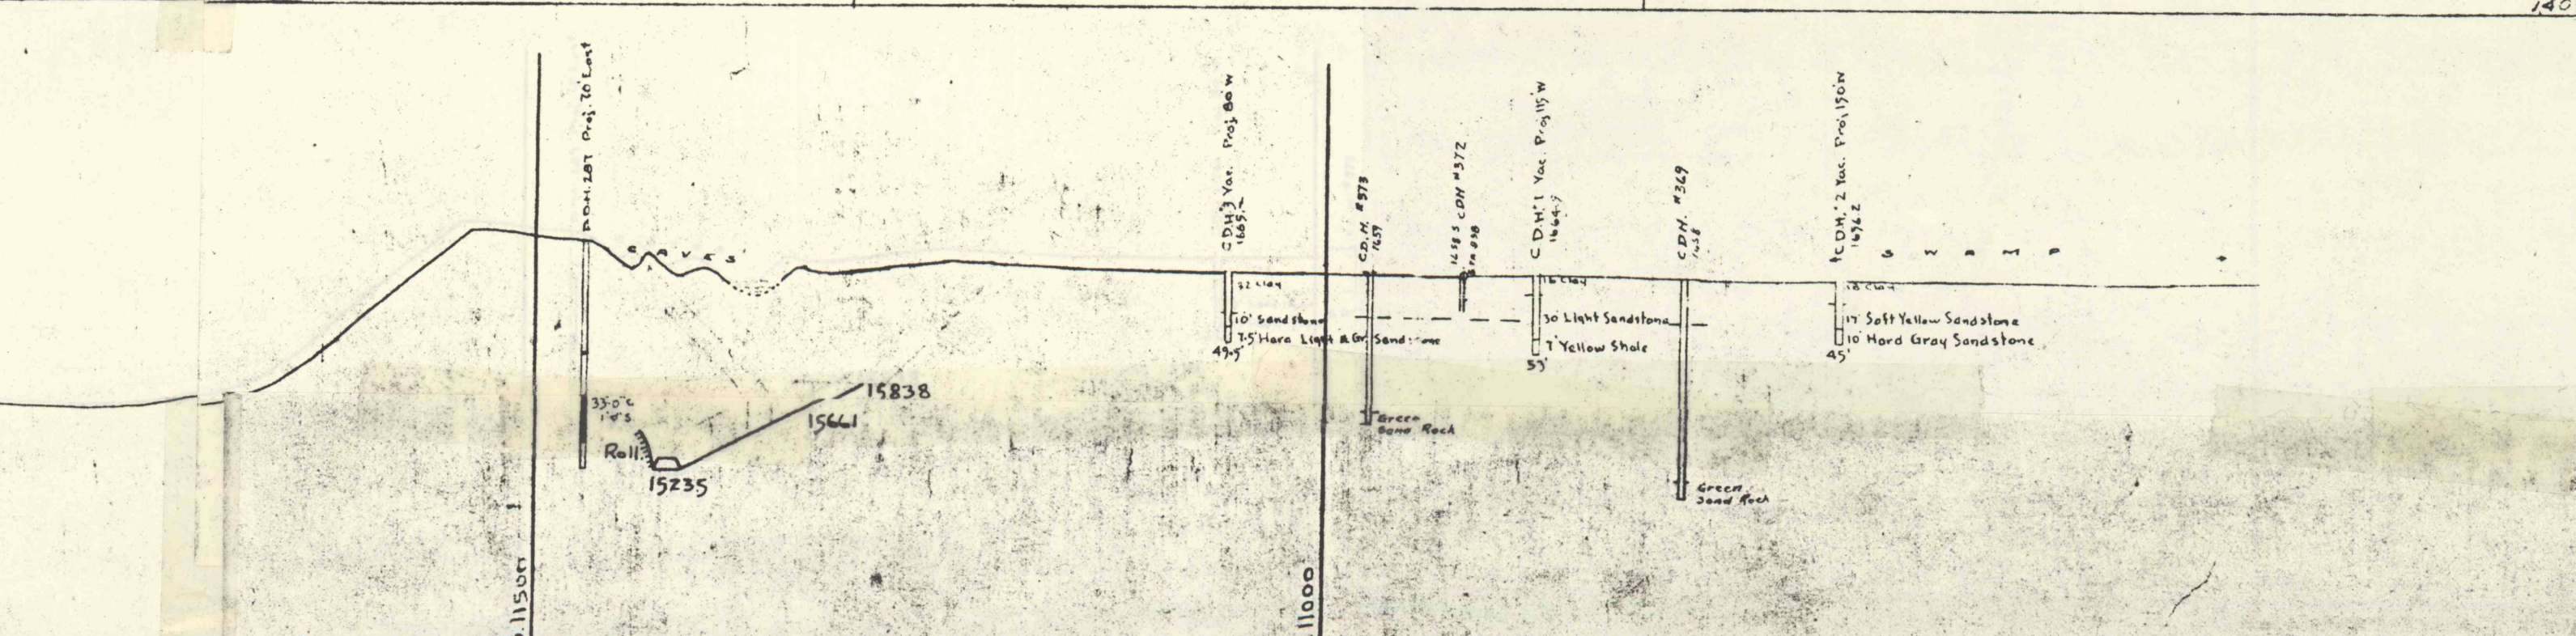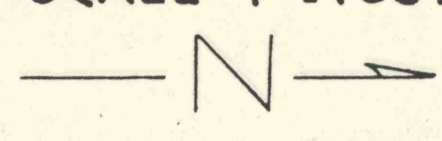



SECTION NO. 31

SCALE 1"=100'

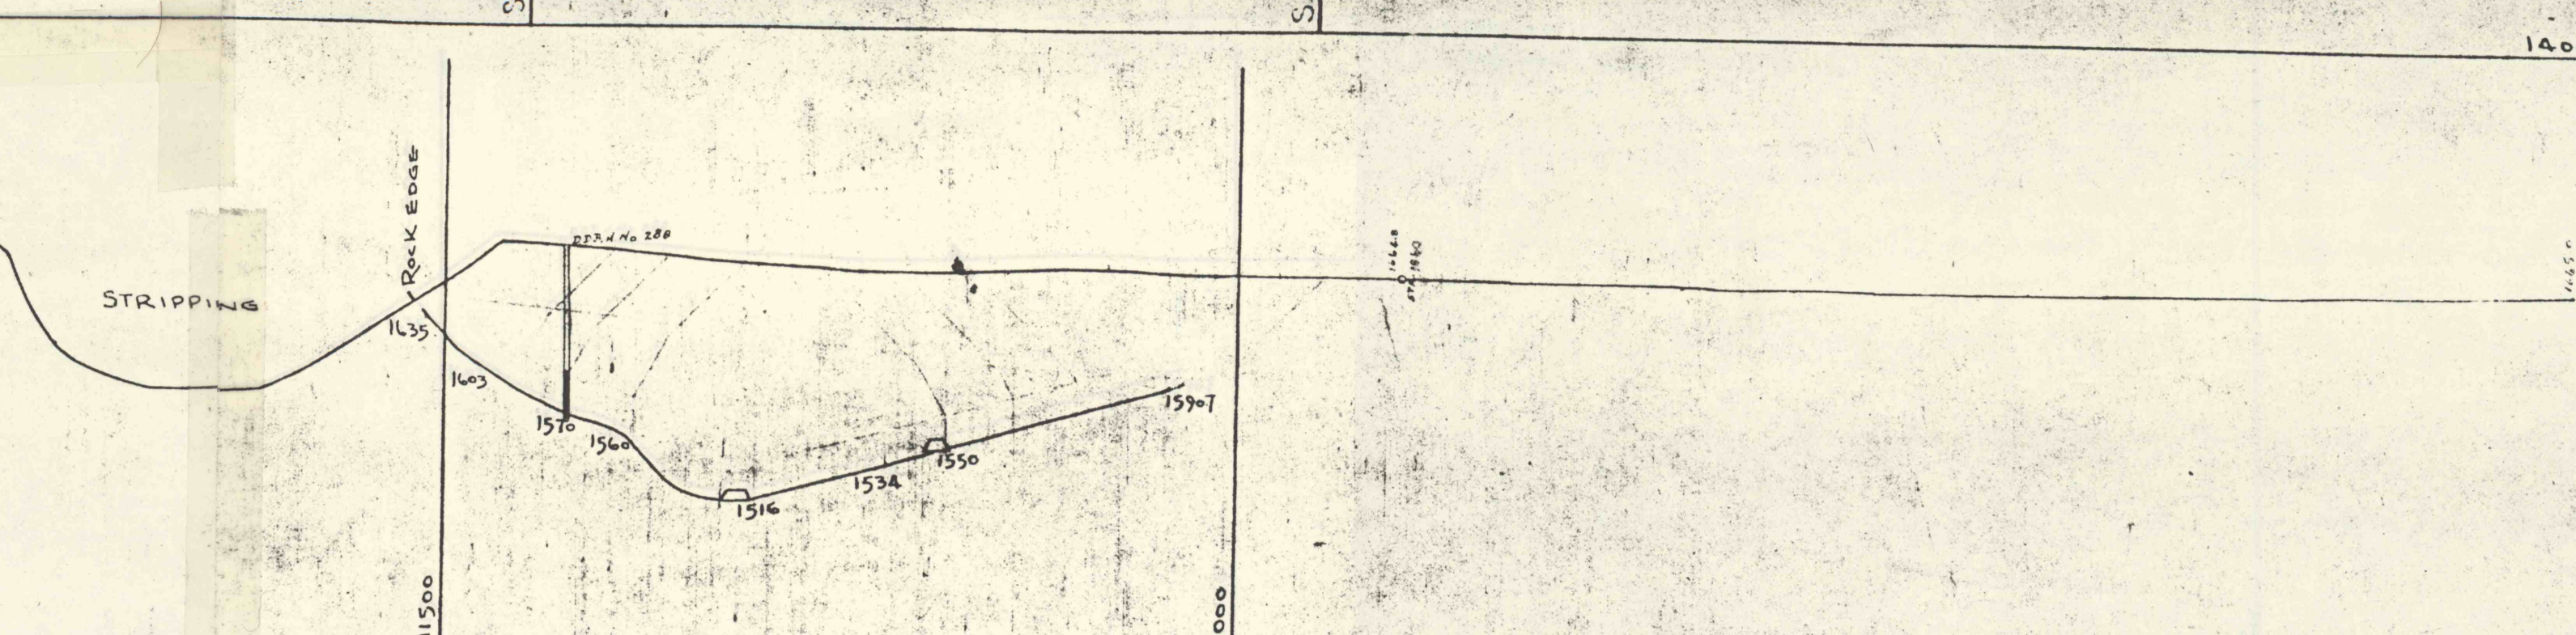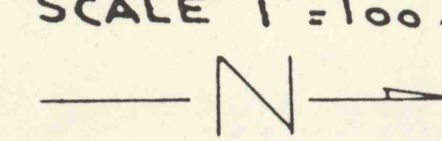



SECTION NO. 30

SCALE 1"=100'

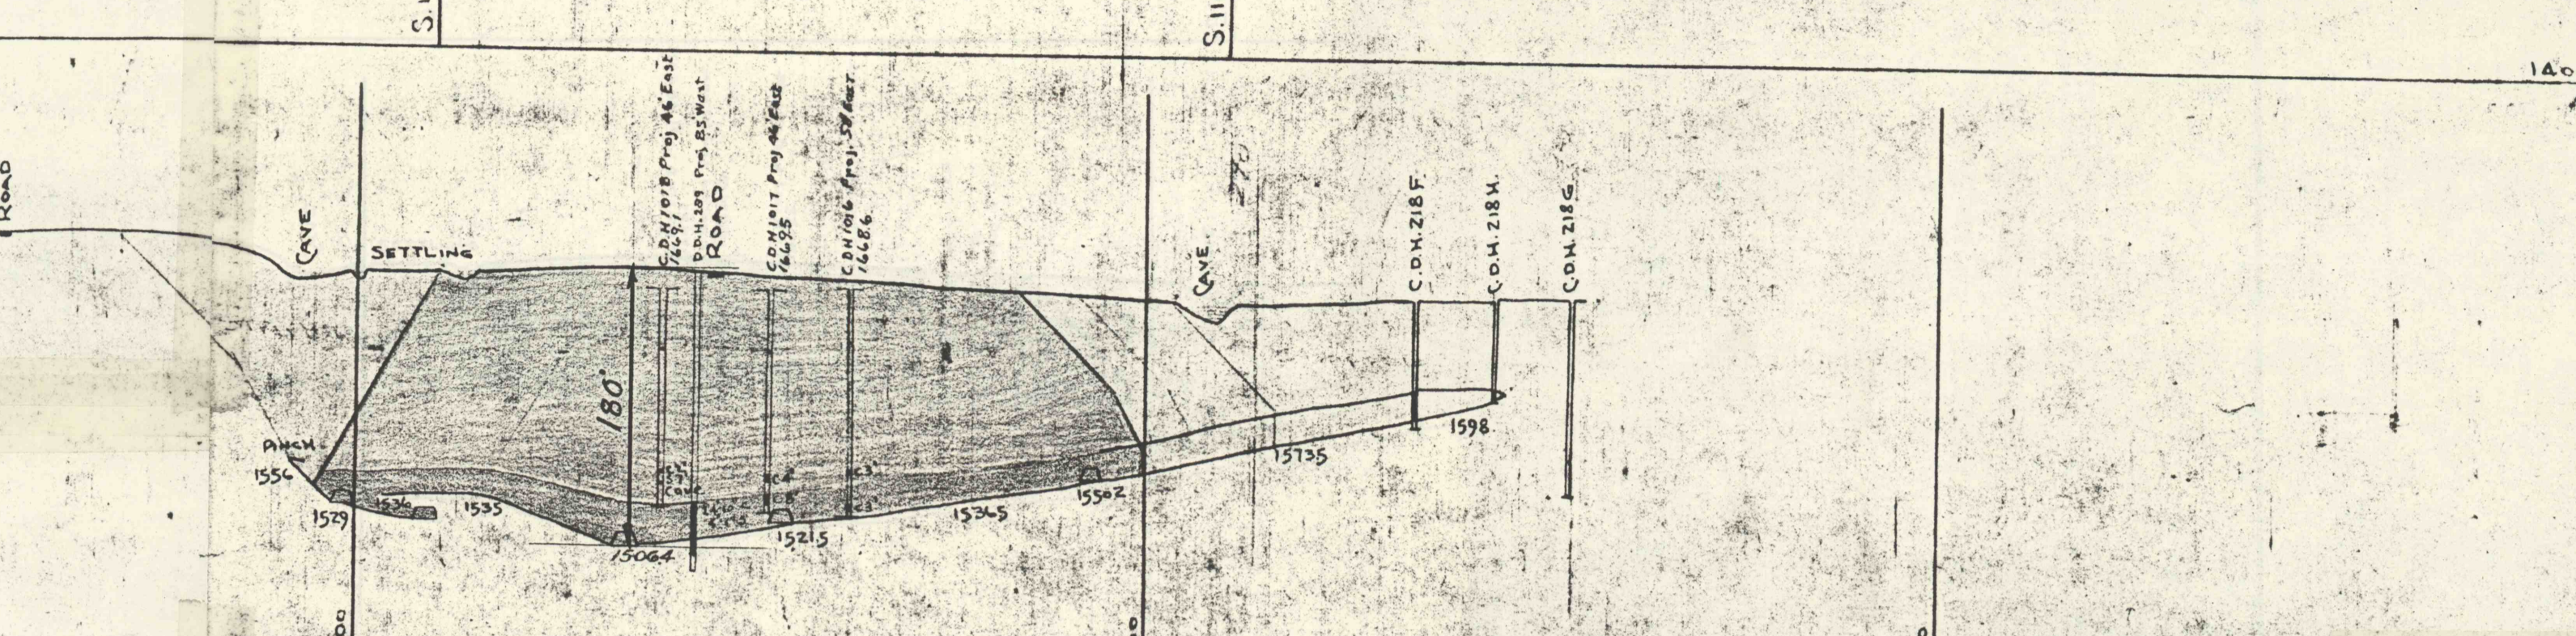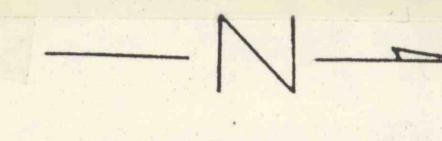



SECTION NO. 29

SCALE 1"=100'

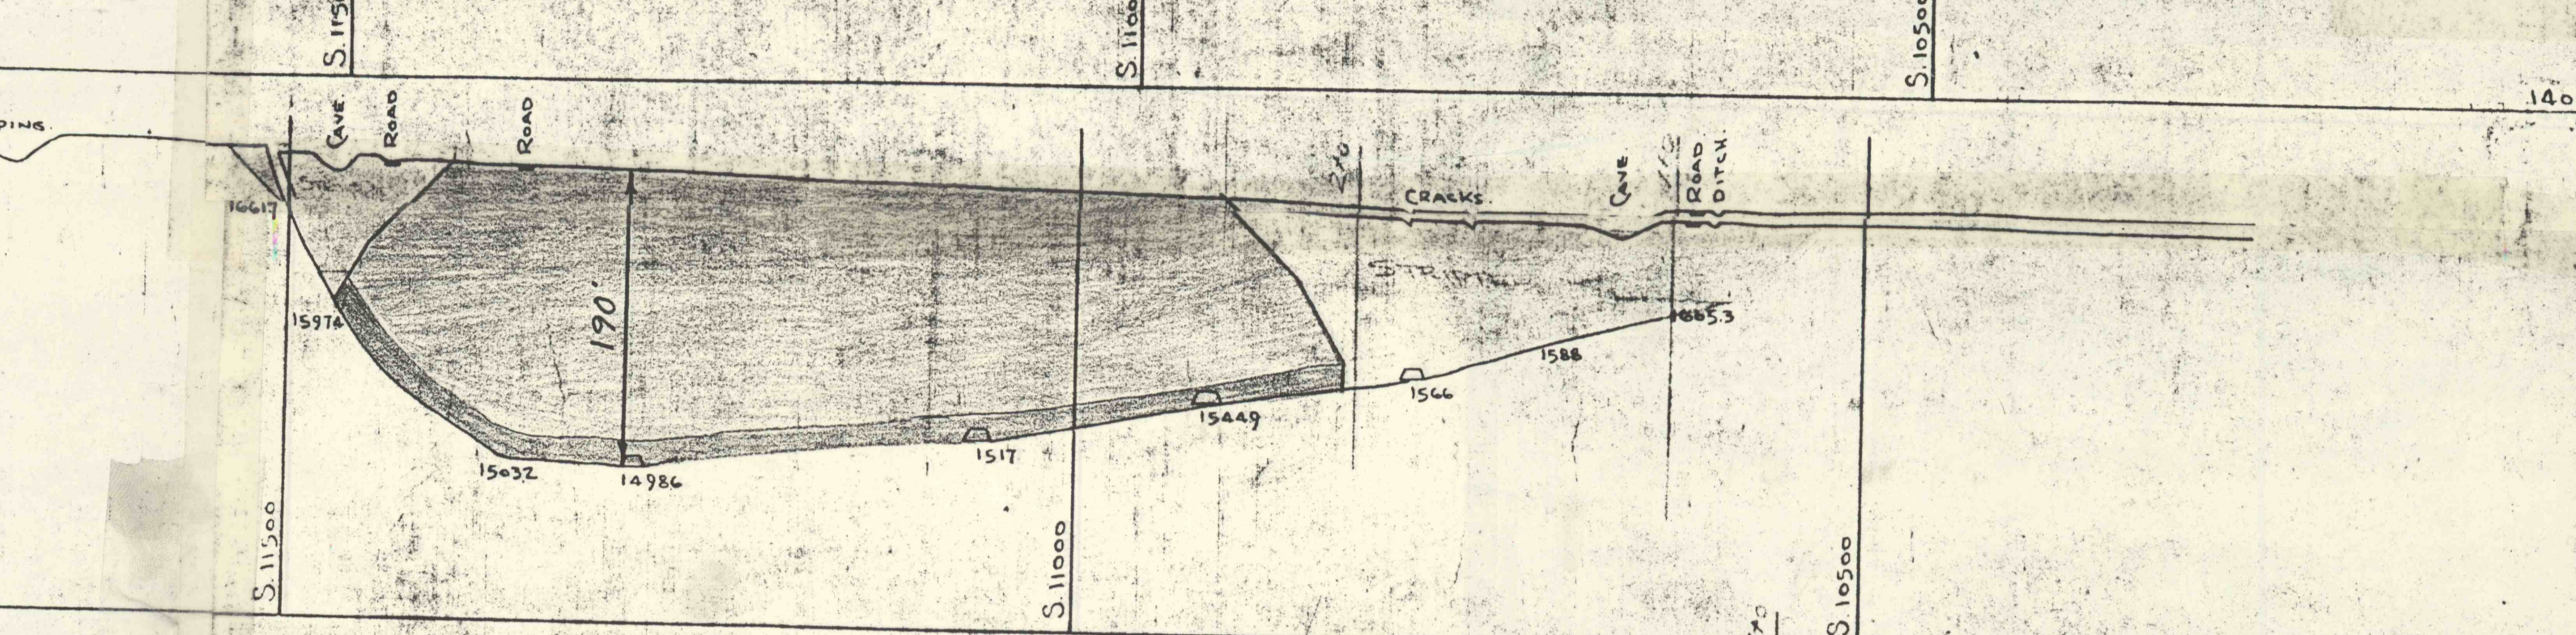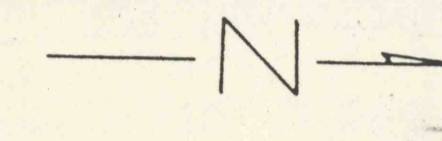



SECTION NO. 28

SCALE 1"=100'

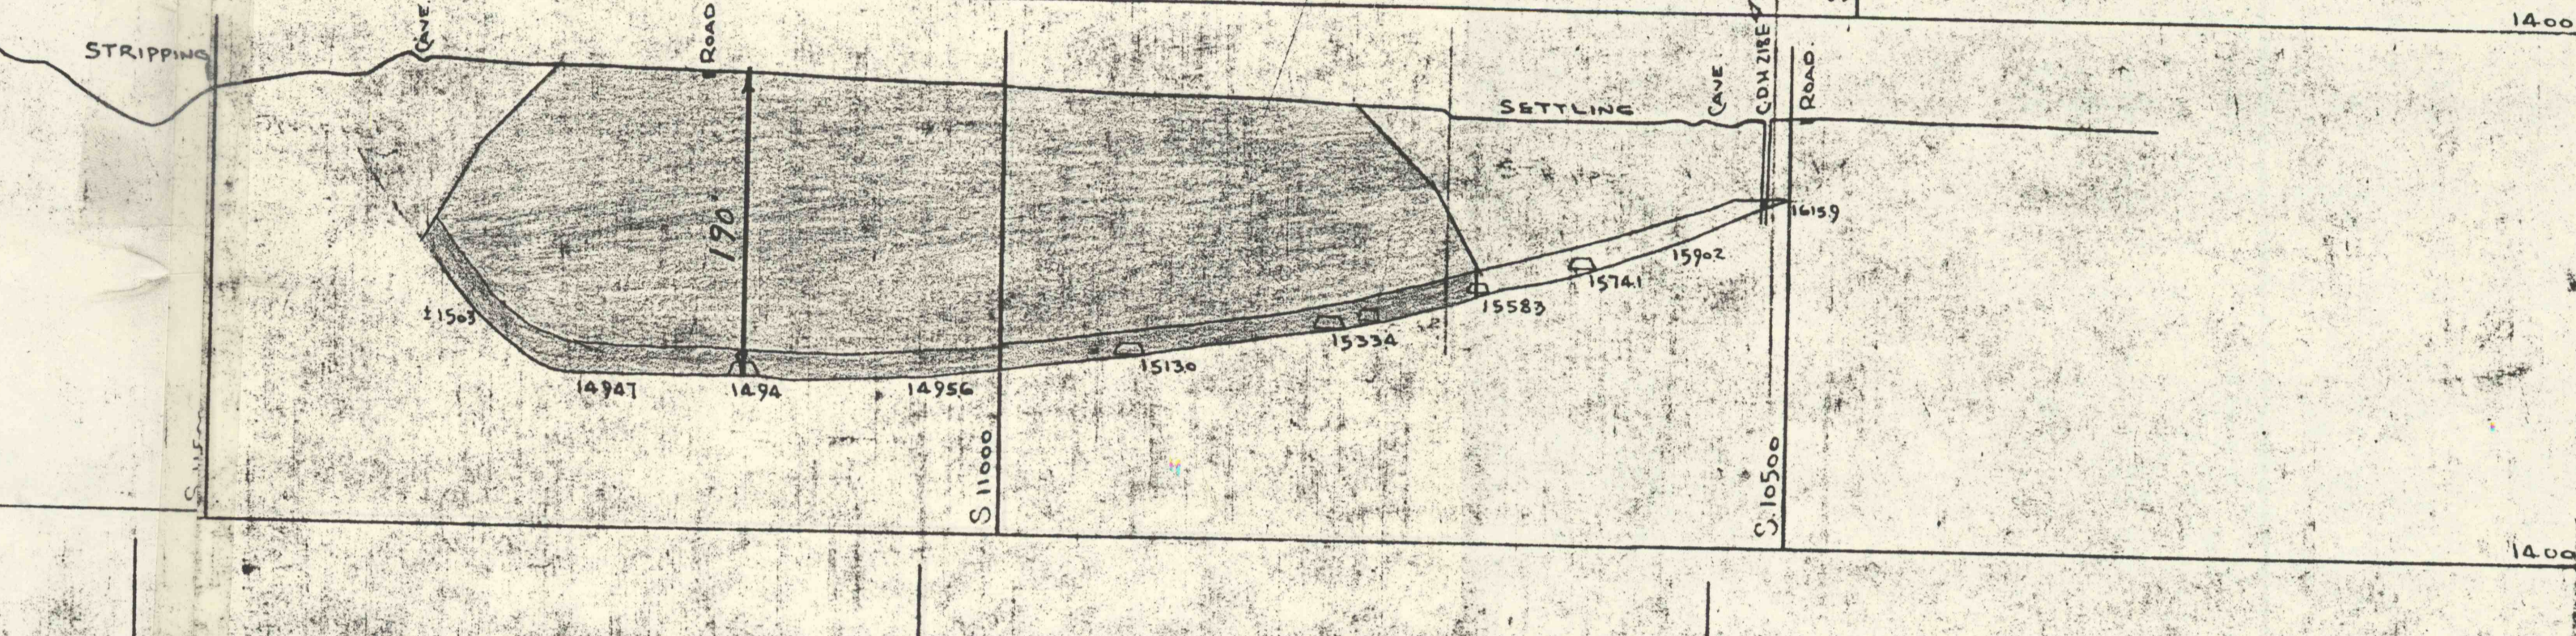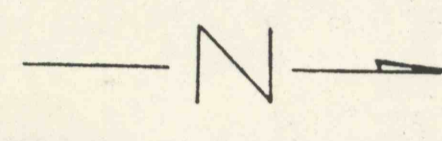



SECTION NO. 27

SCALE 1"=100'

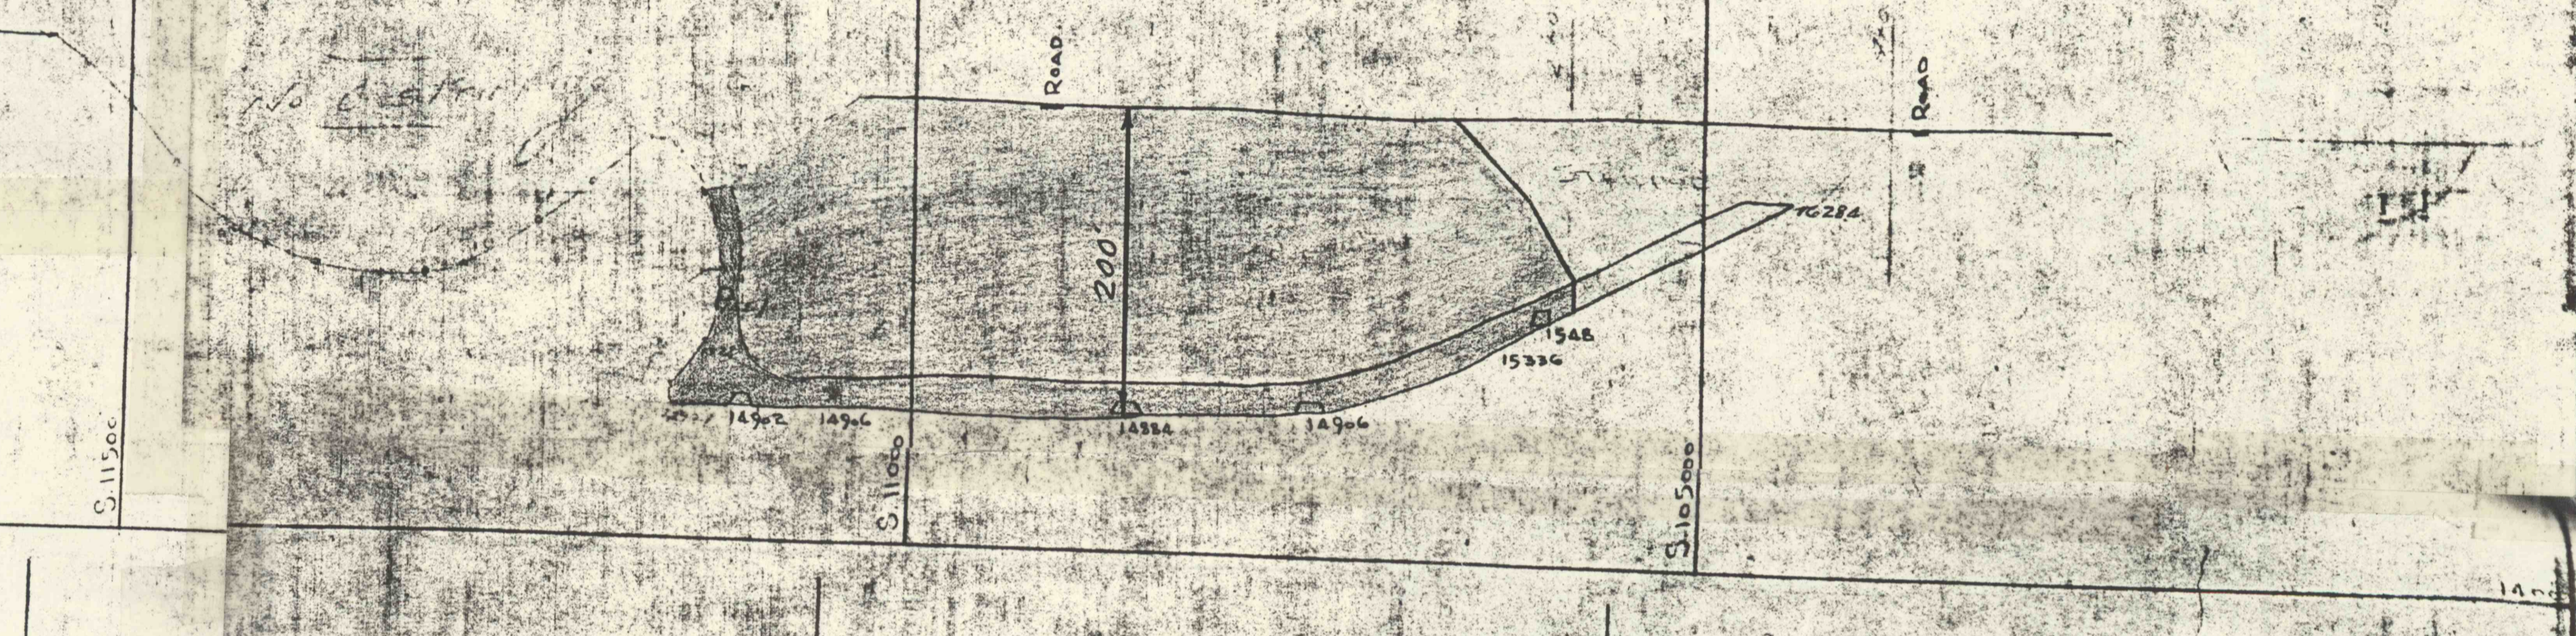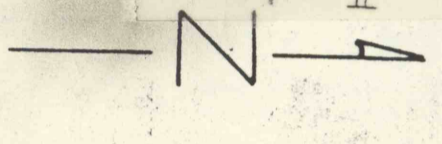



SECTION NO. 26

SCALE 1"=100'

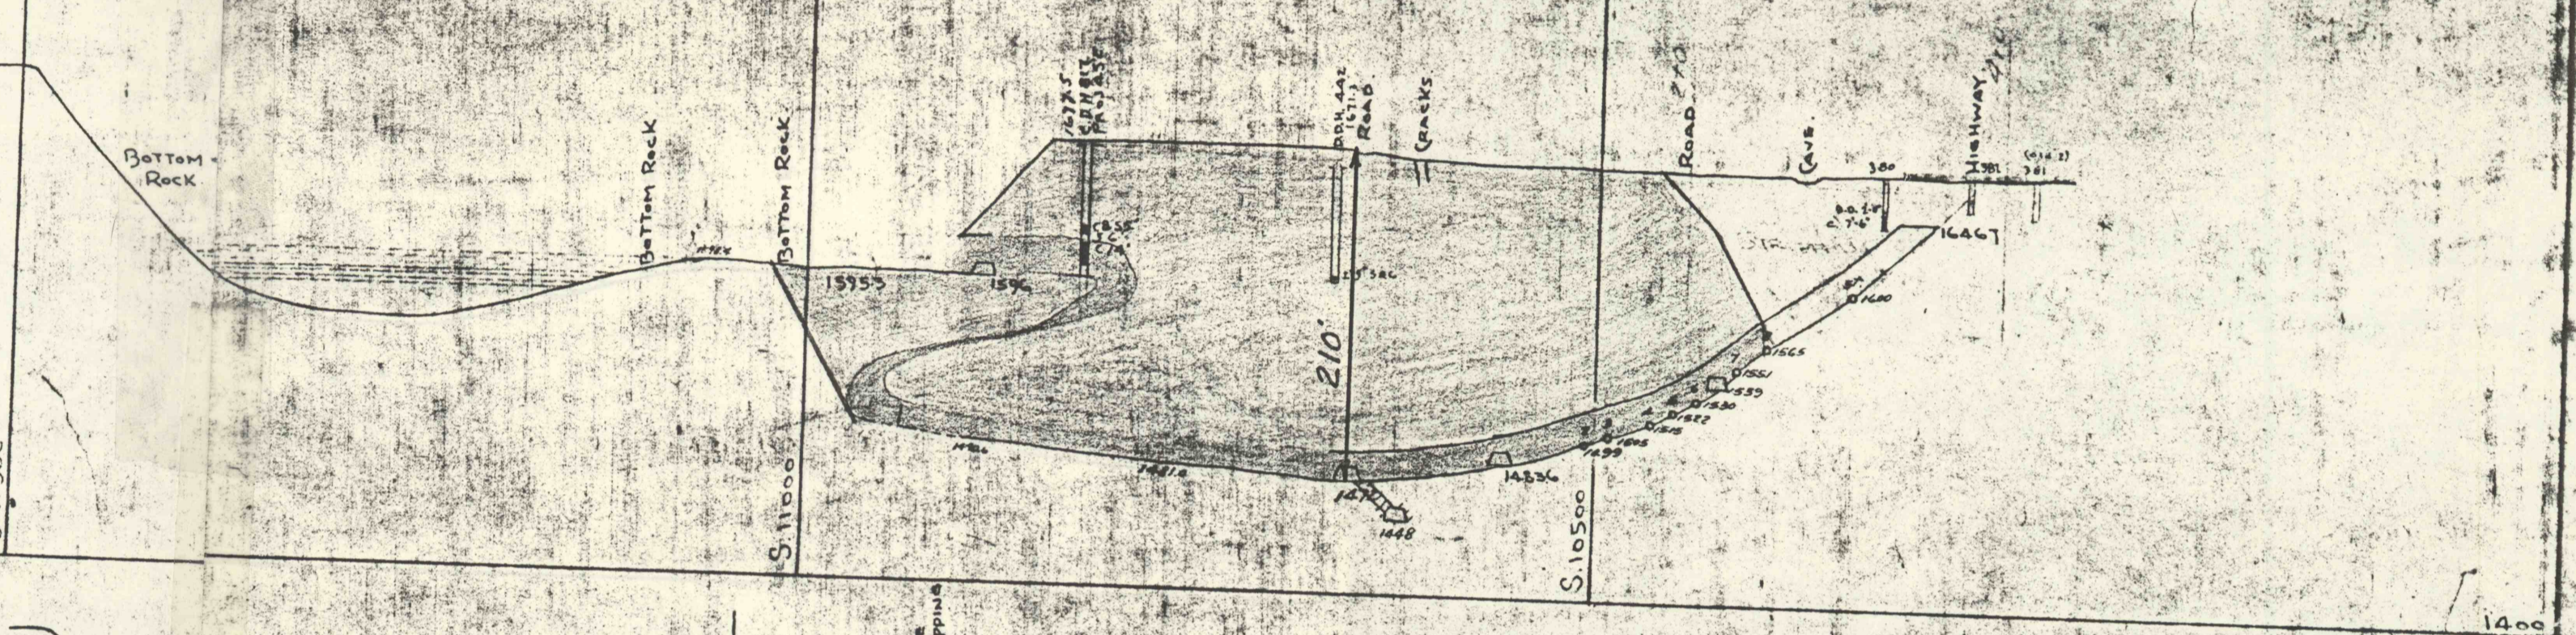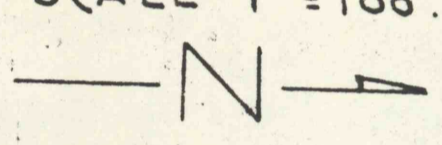


SECTION NO. 25

SCALE 1"=100'

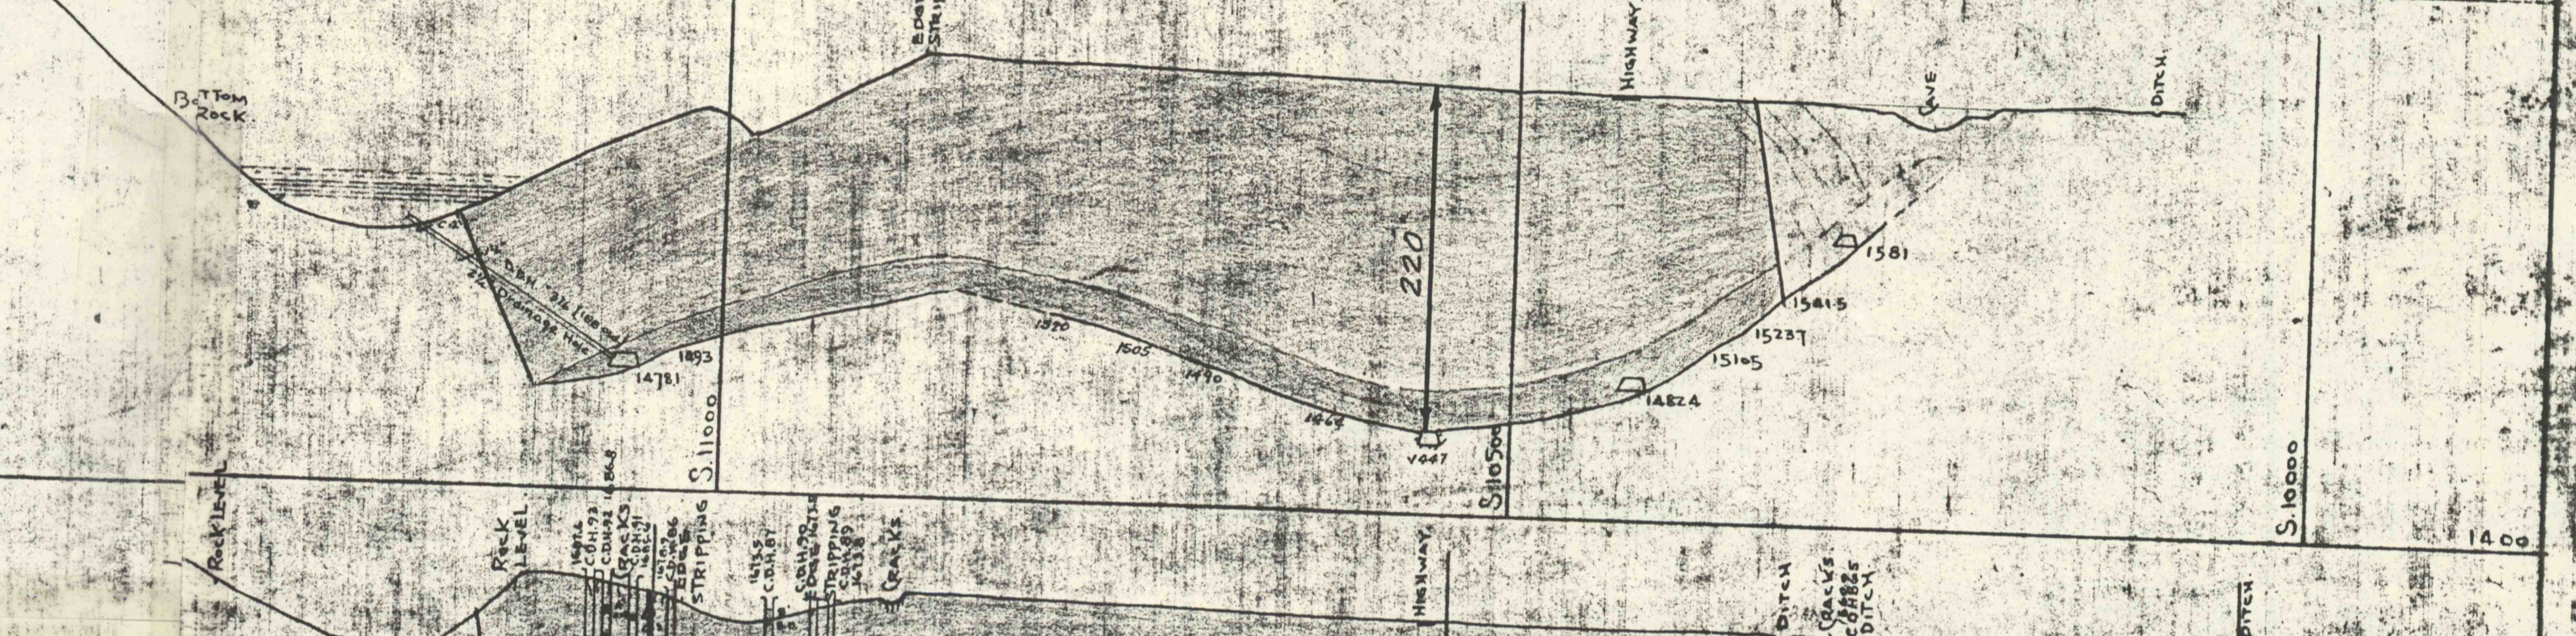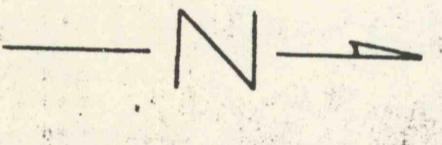



SECTION NO. 24

SCALE 1"=100'

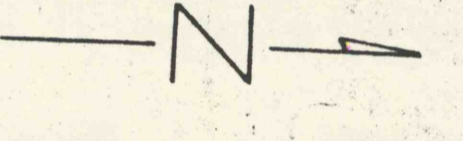



SECTION NO. 23

SCALE 1"=100'

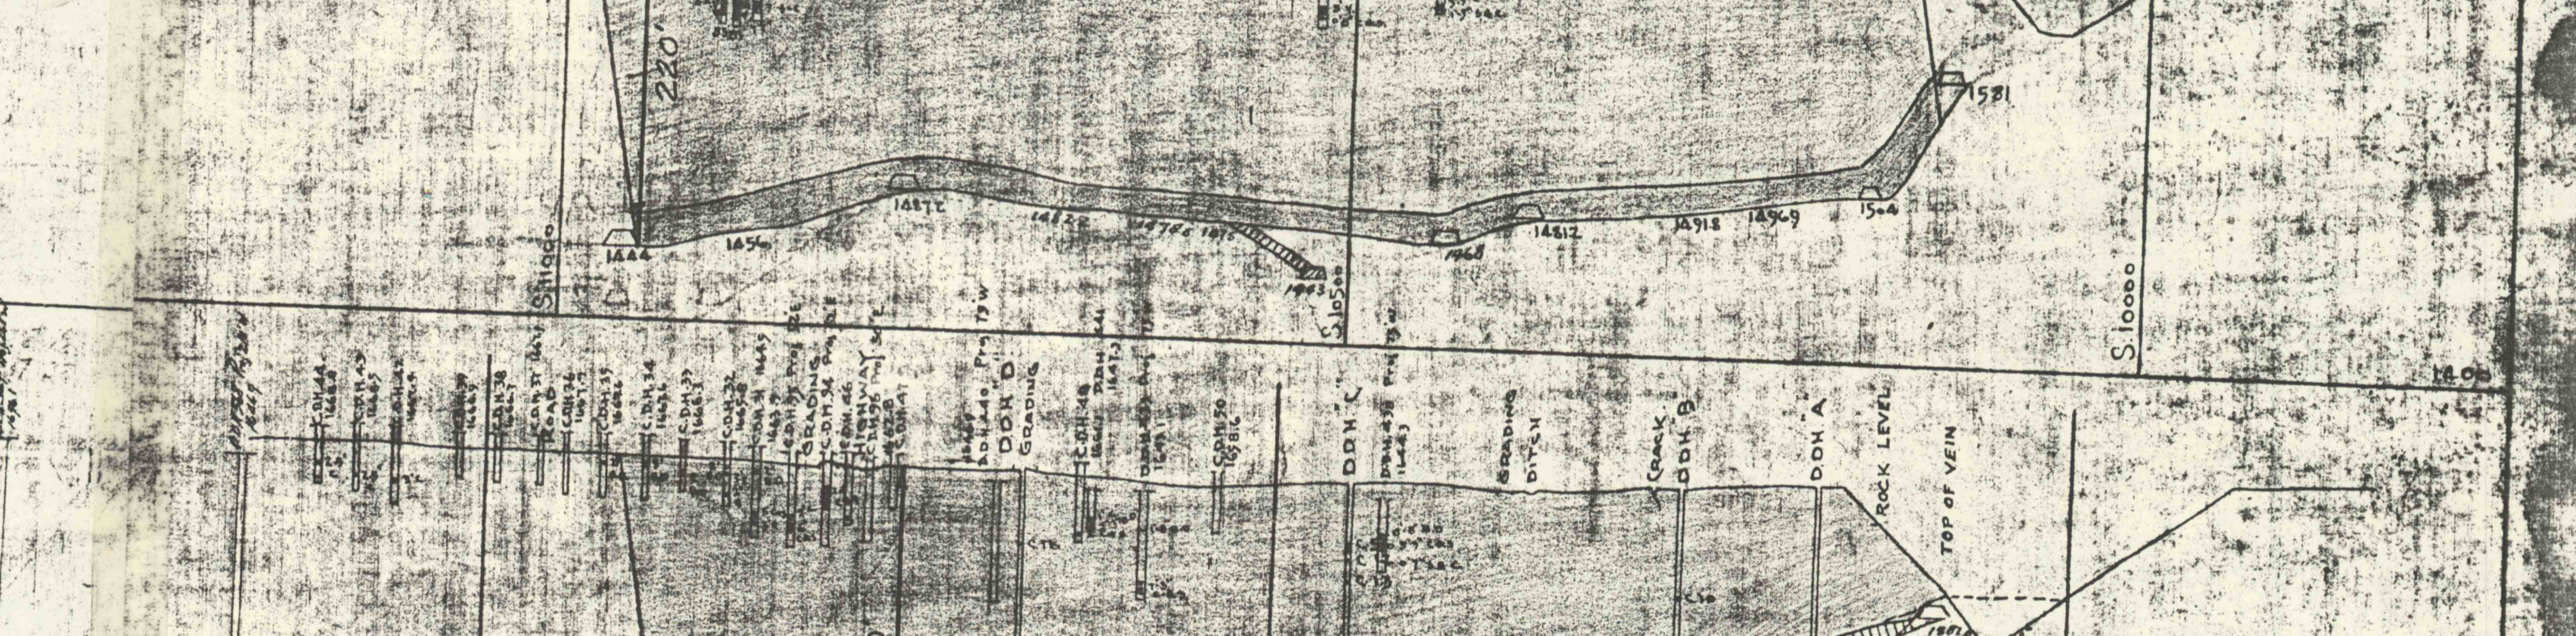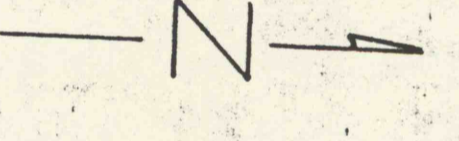



SECTION NO. 22

SCALE 1"=100'

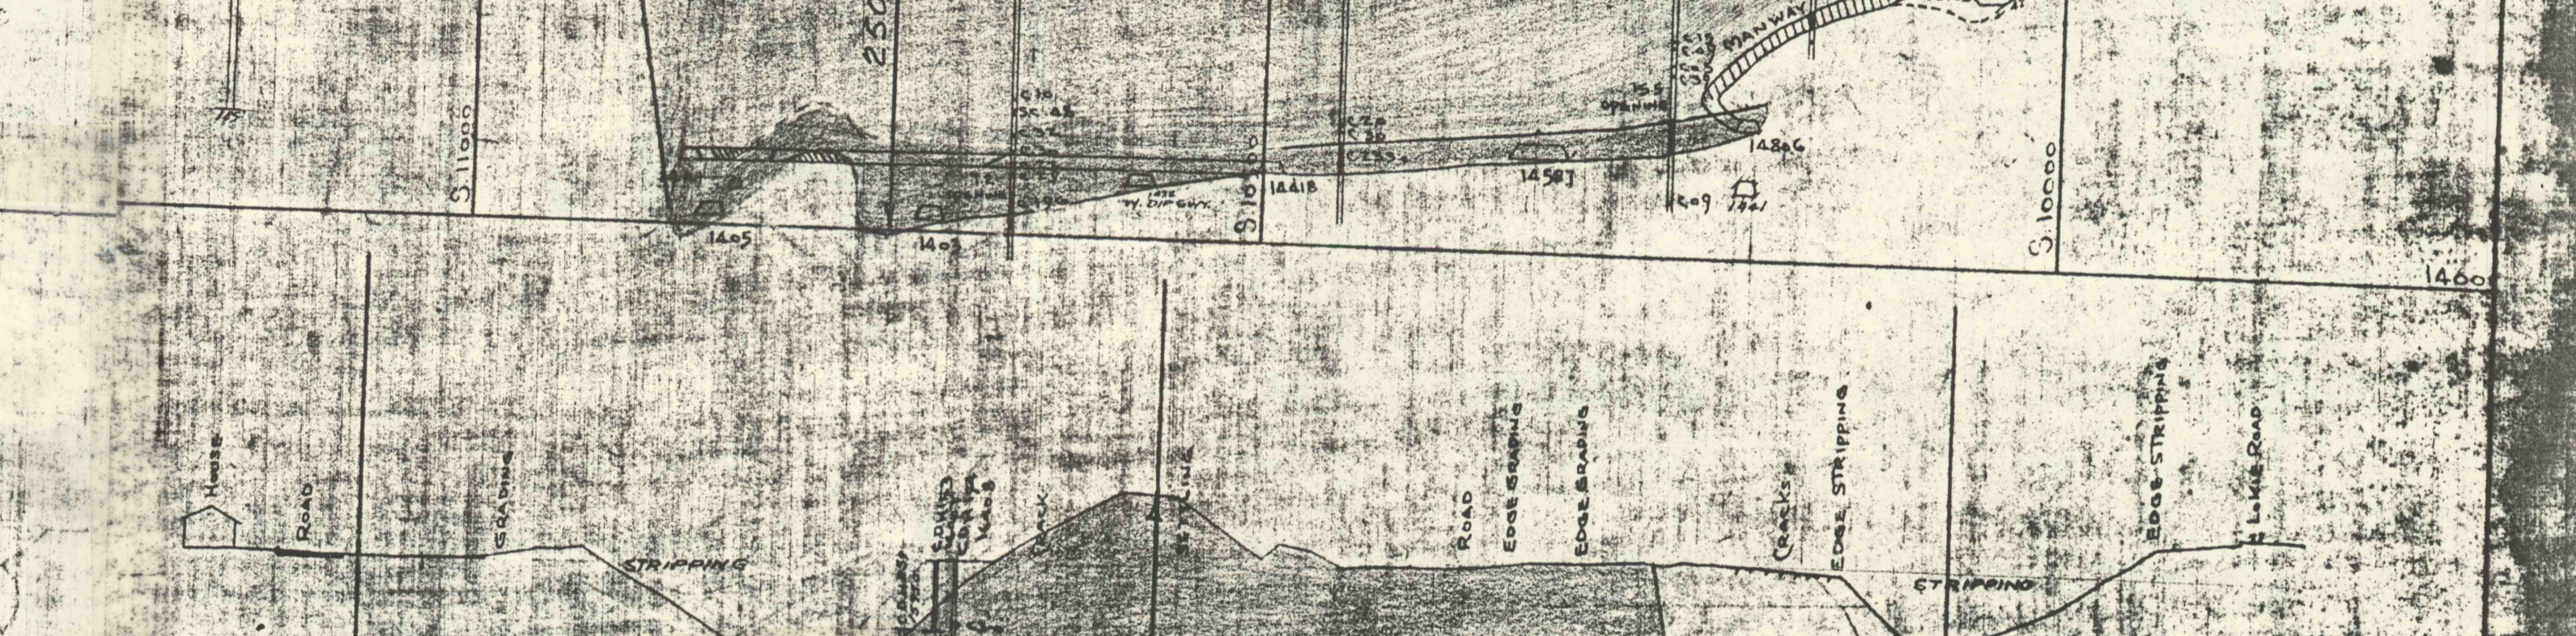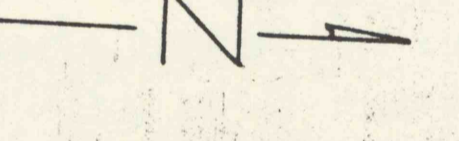



SECTION NO. 21

SCALE 1"=100'

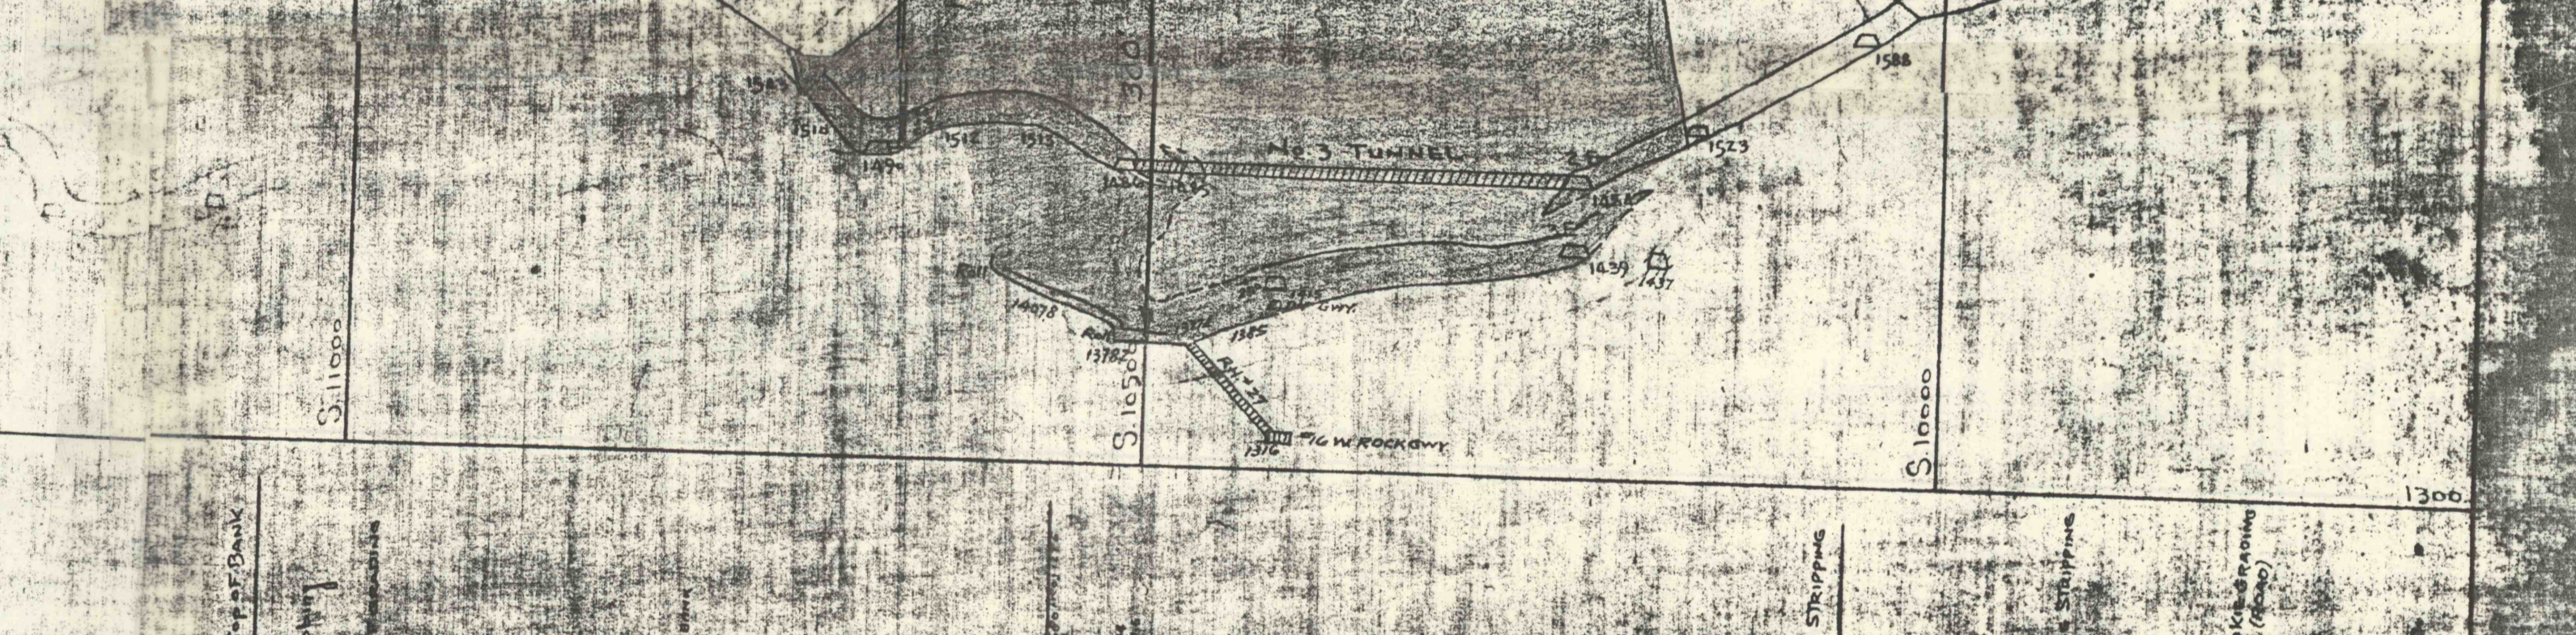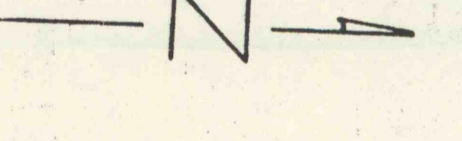



SECTION NO. 20

SCALE 1"=100'

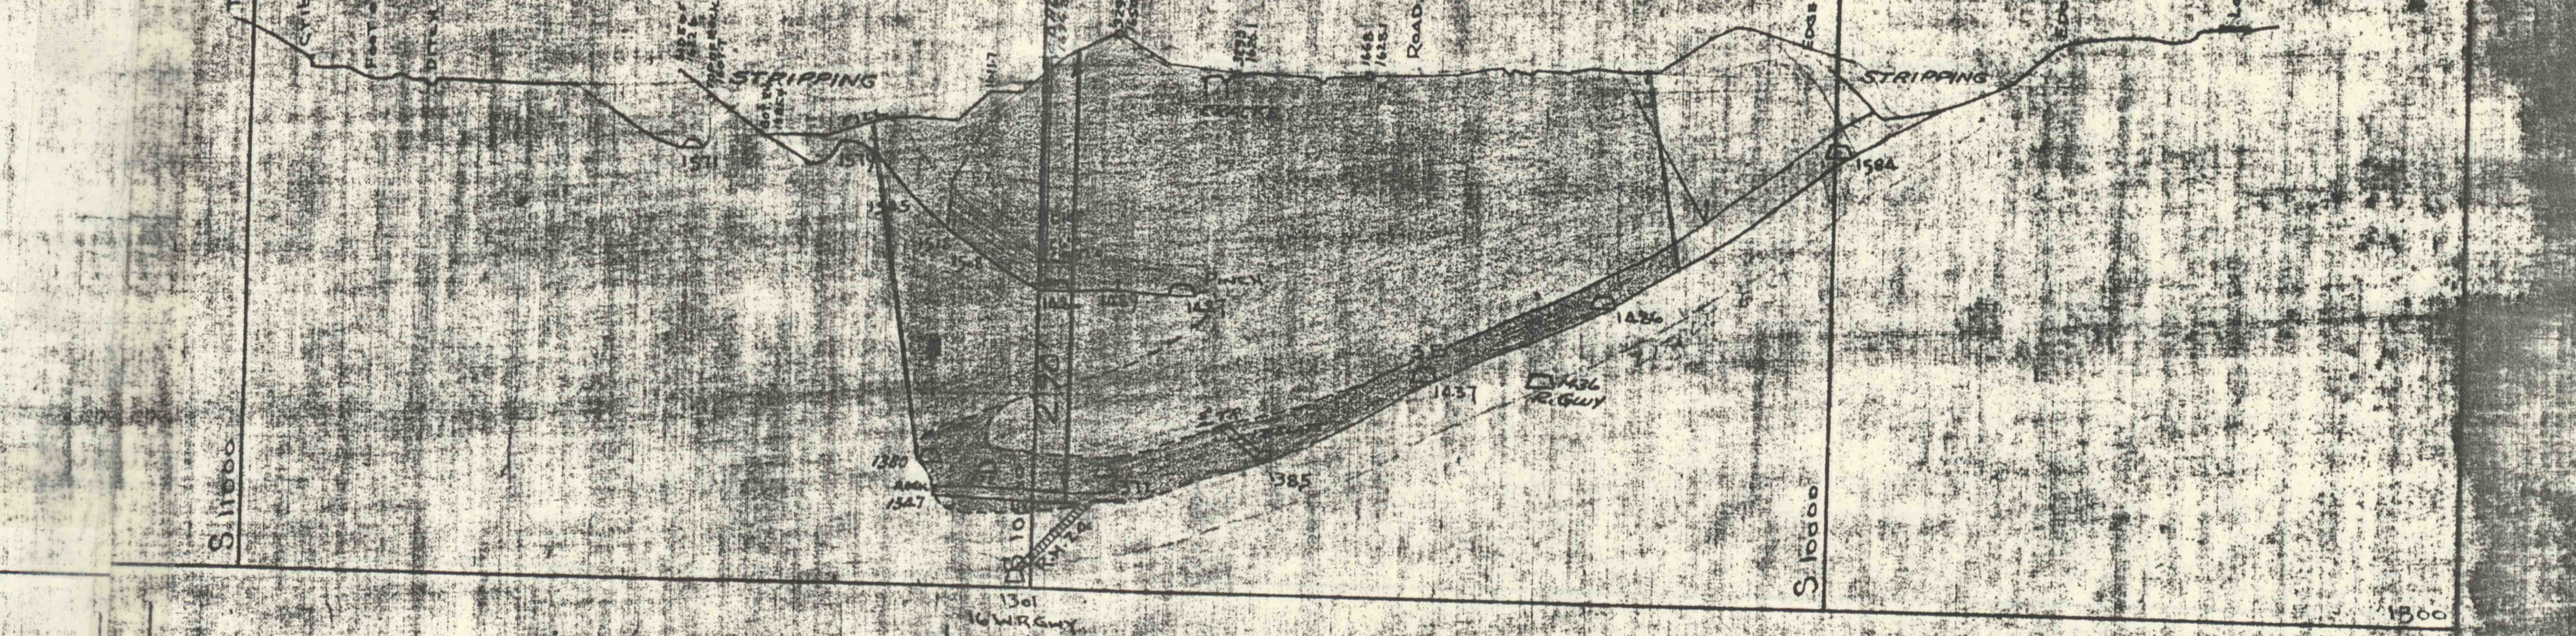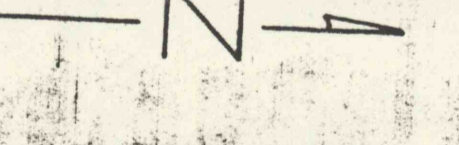



SECTION NO. 19

SCALE 1"=100'

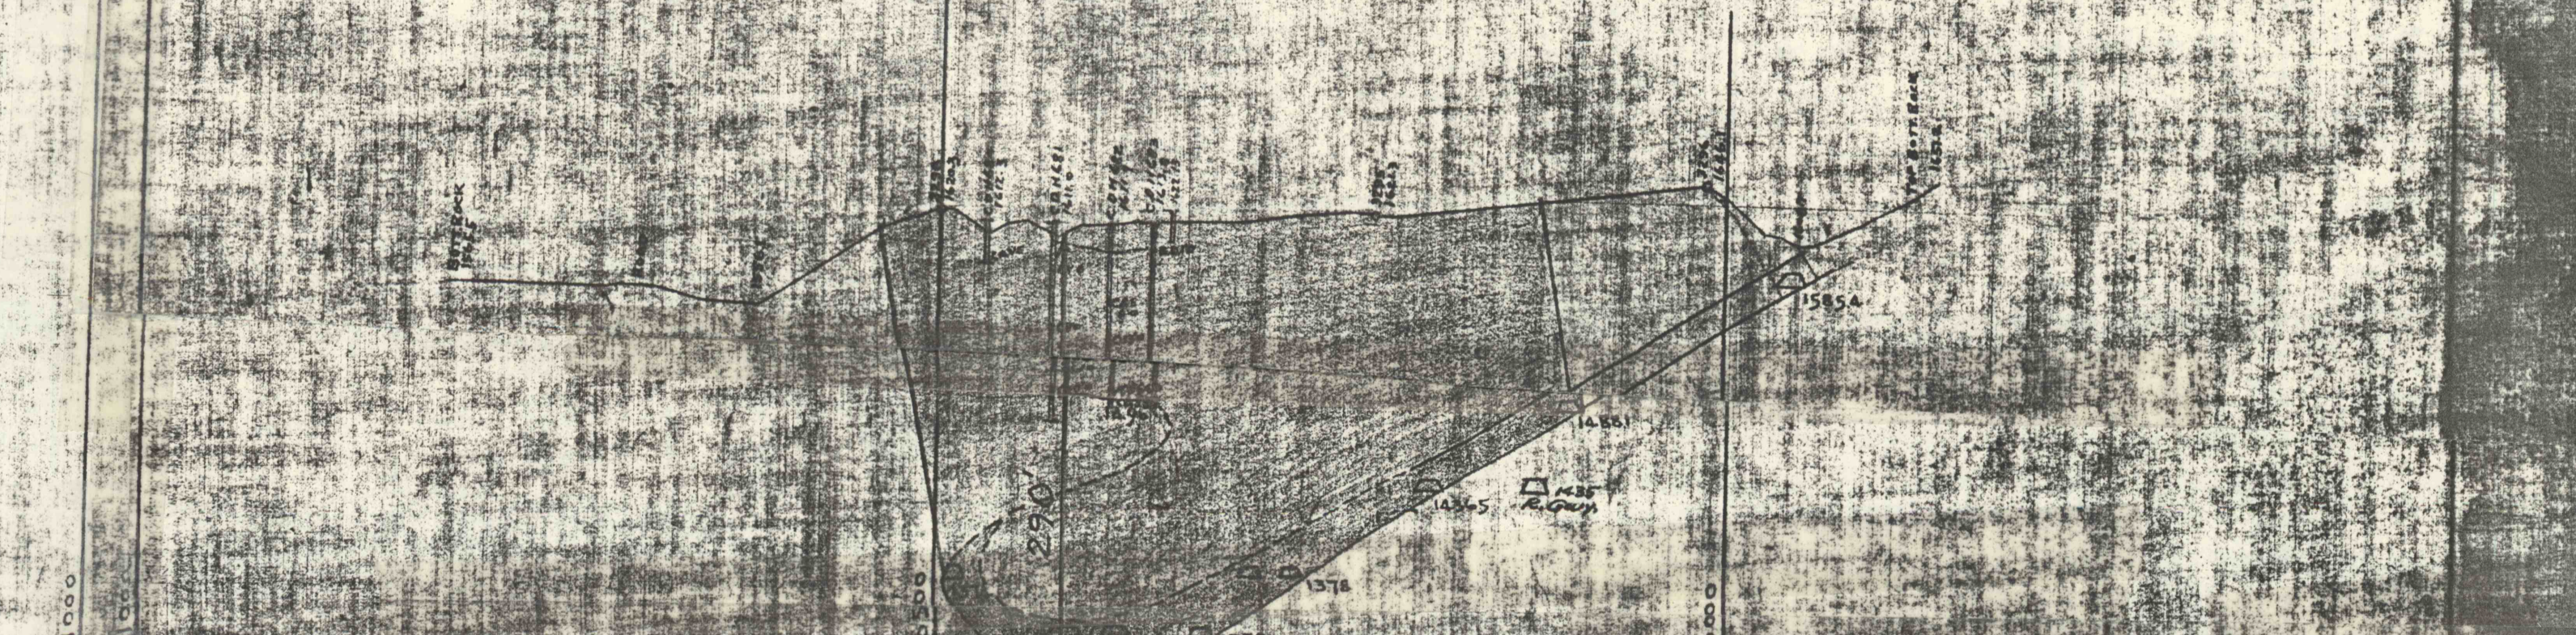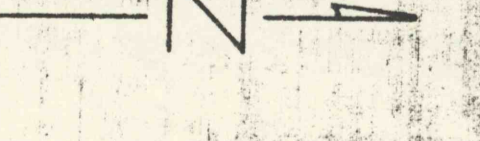



SECTION NO. 18

SCALE 1"=100'

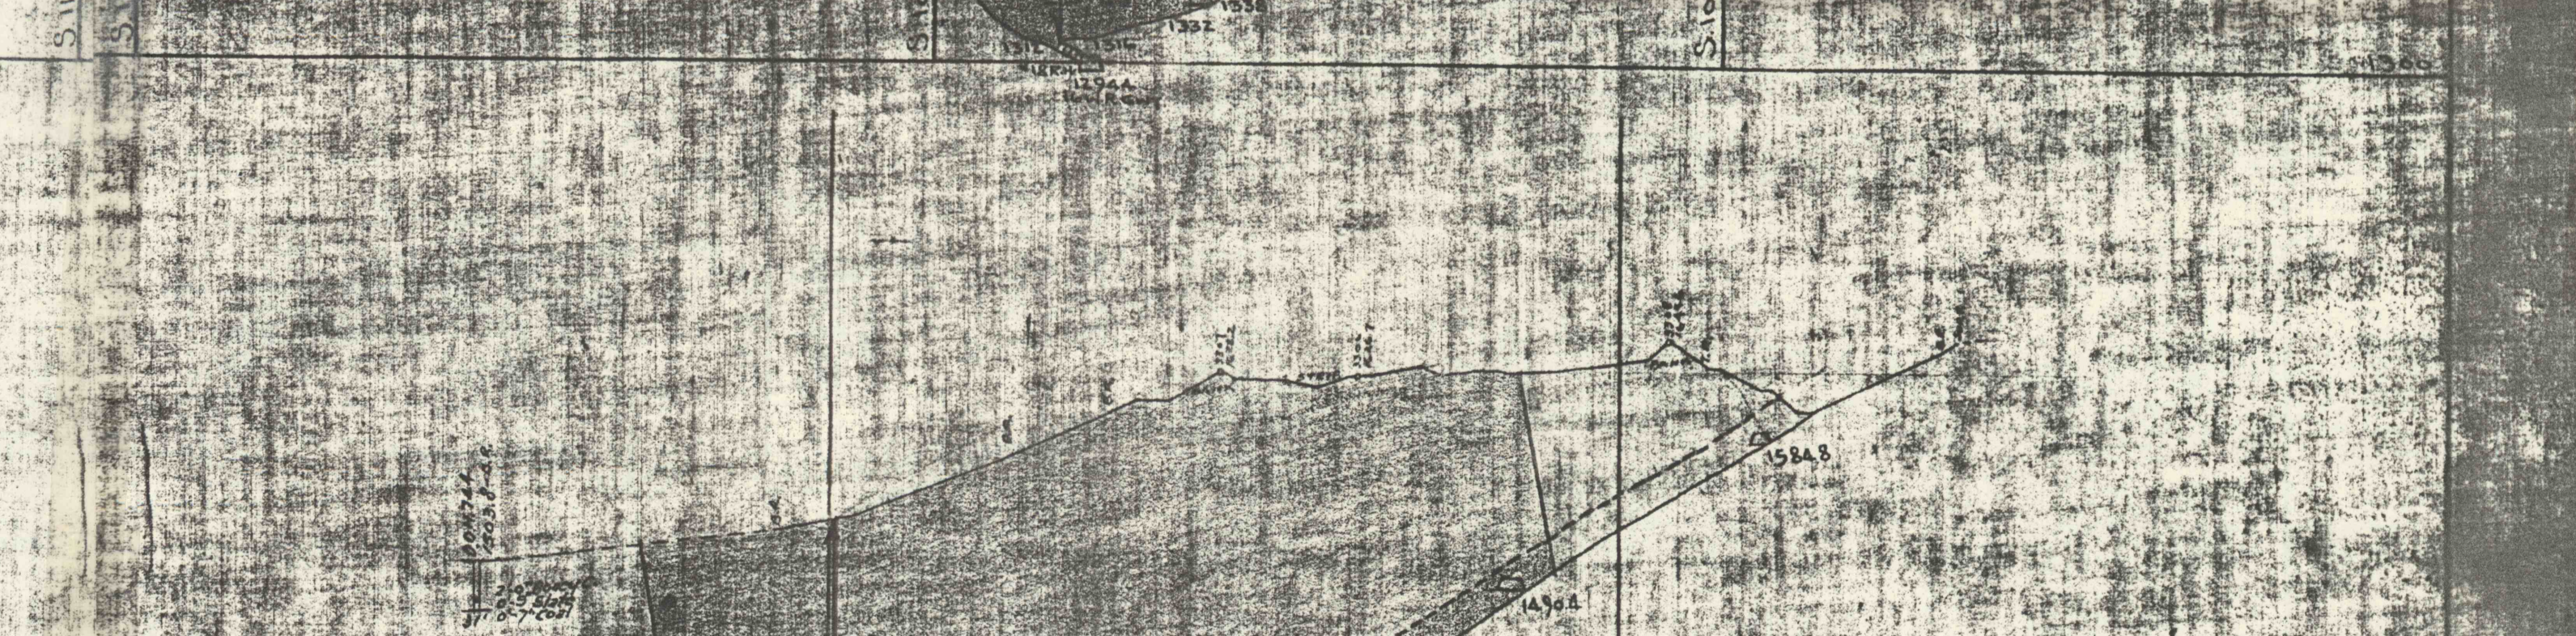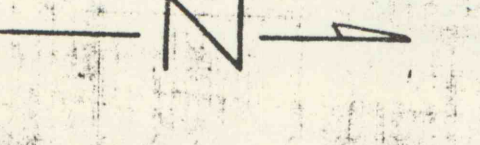

SECTION NO. 17

SCALE 1"=100'

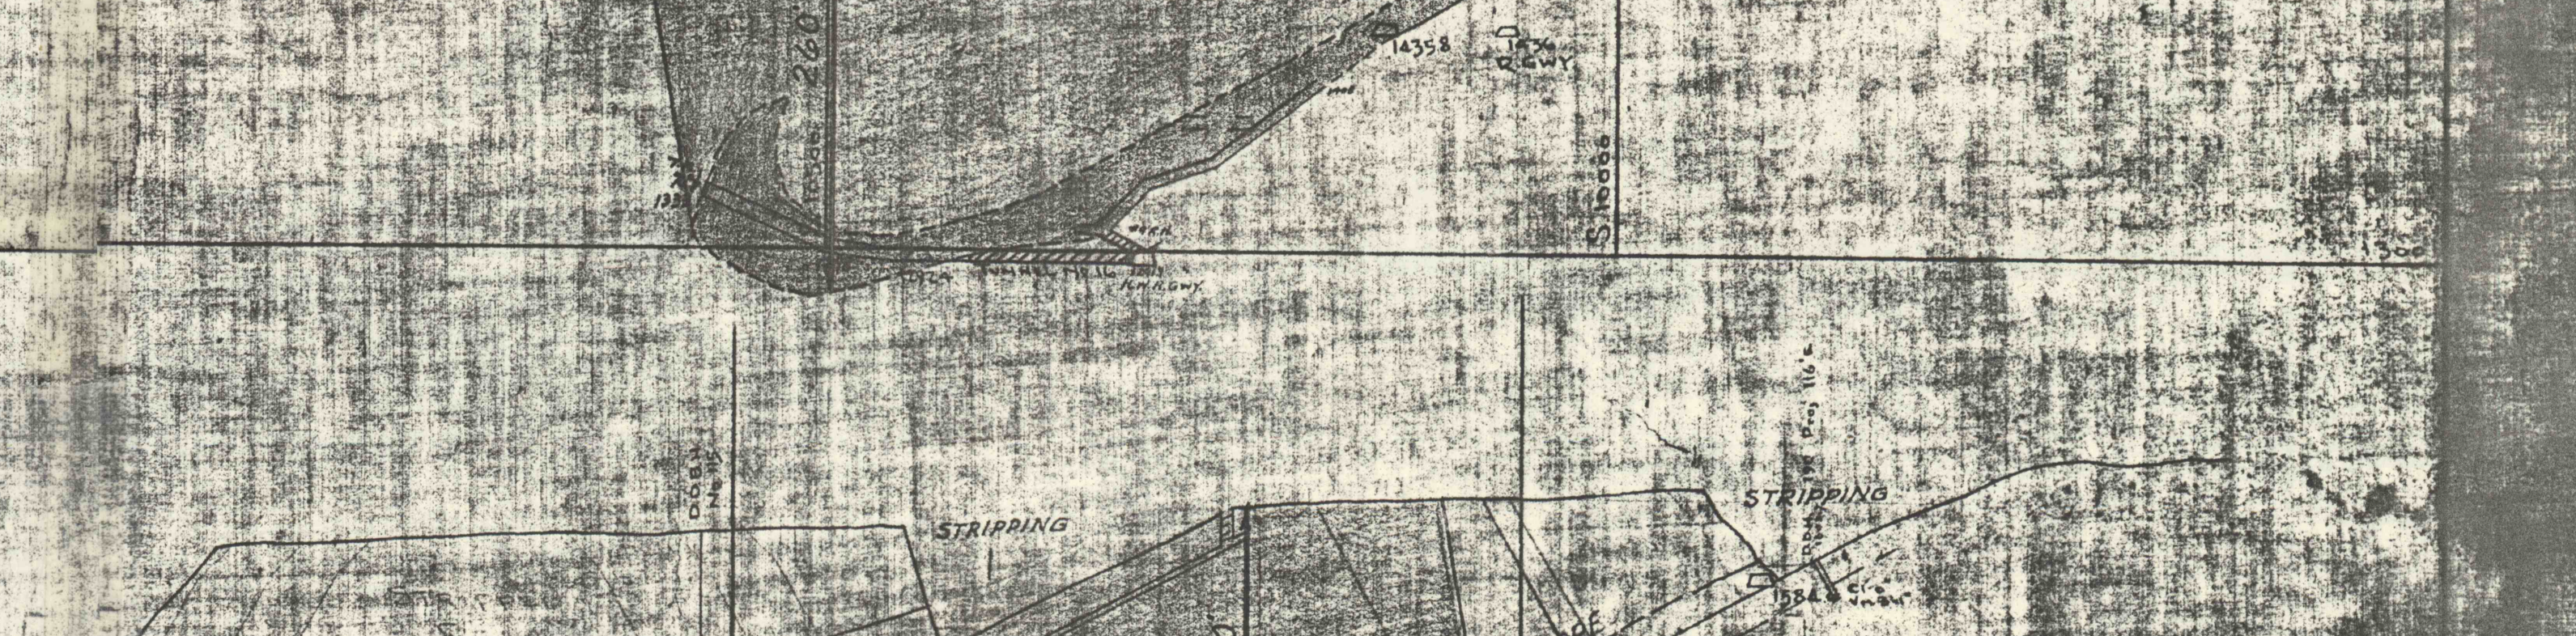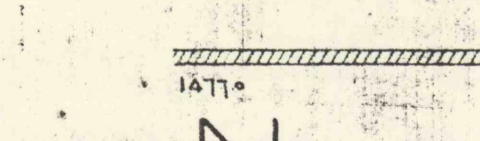

SECTION NO. 16

SCALE 1"=100'

