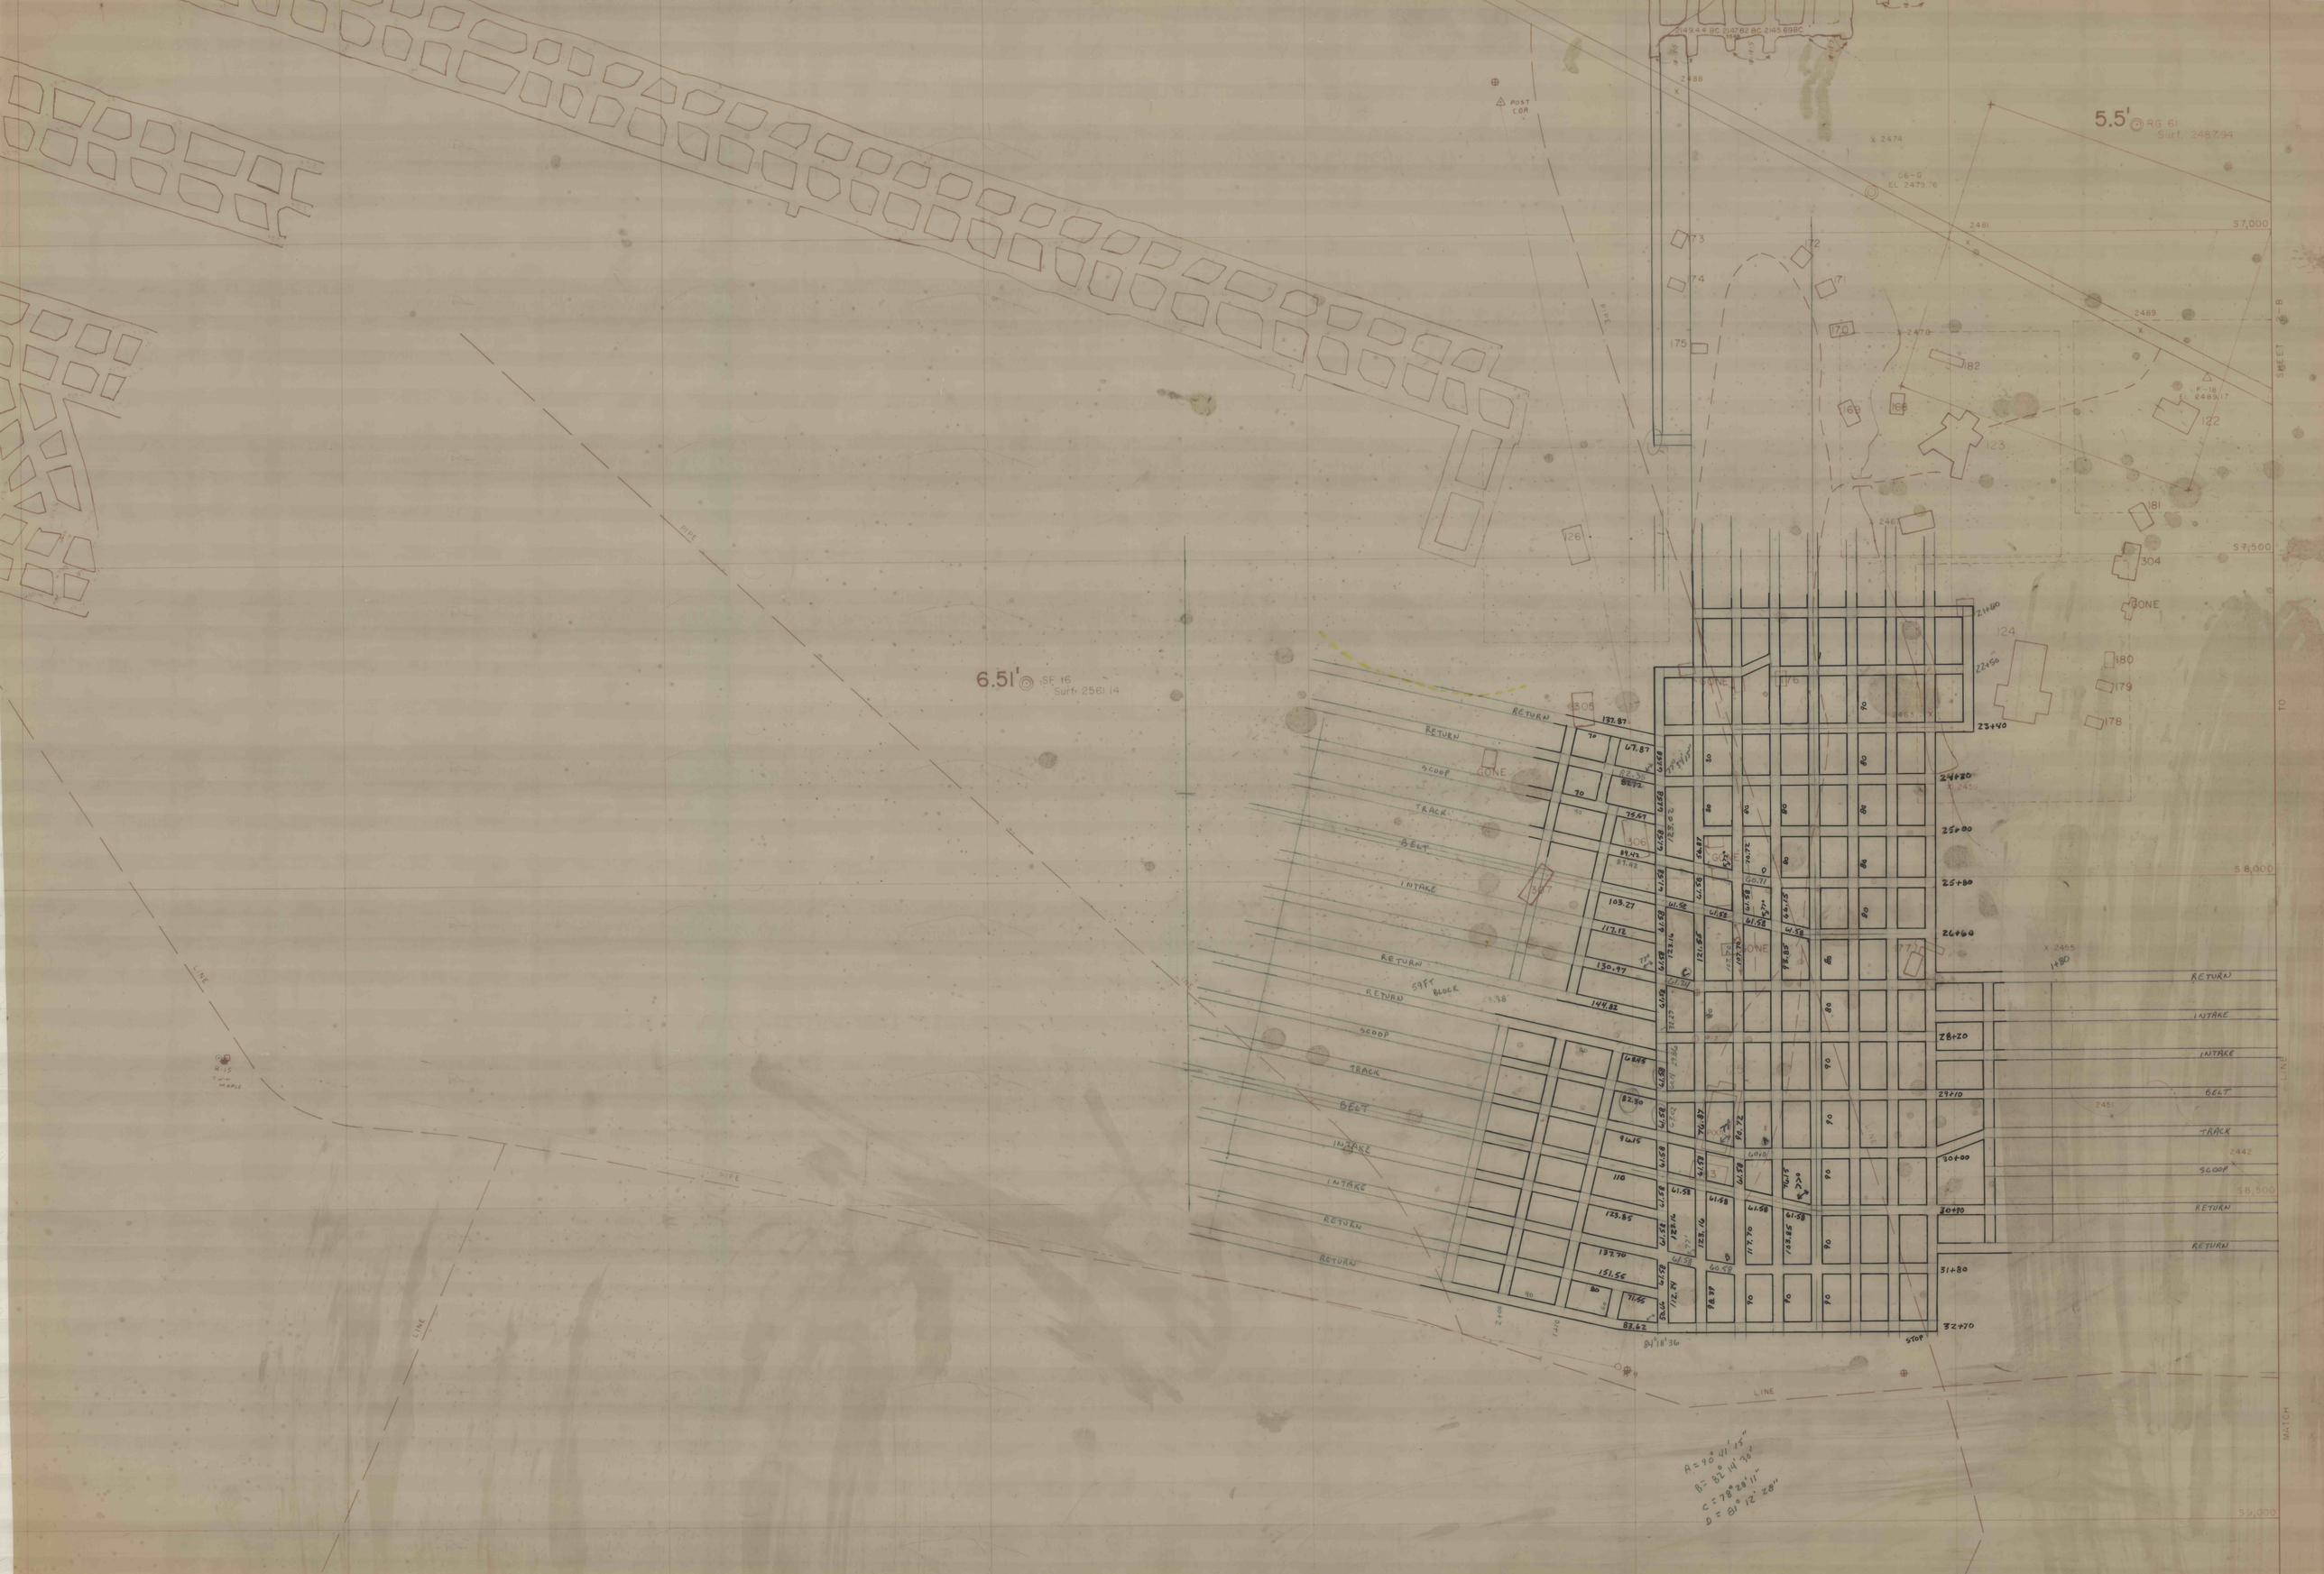

5.5'
RG 61
Surf. 2487.94
6.51'
SF 16
Surf. 2561.14
POST COR
PIPE
LINE
RETURN
SCOOP
TRACK
BELT
INTAKE
GONE
STOP
S7,000
S7,500
S8,000
S8,500
S9,000
SHEET 2-B
TO
MATCH
A = 90° 41' 15"
B = 82° 14' 30"
C = 78° 28' 11"
D = 81° 12' 28"