


Valier No. 8
Tracing #43-Drawer-67

Mohney
17 Acres
Reserve

J. H. & W. S. DILTS

JAS. W GAUL

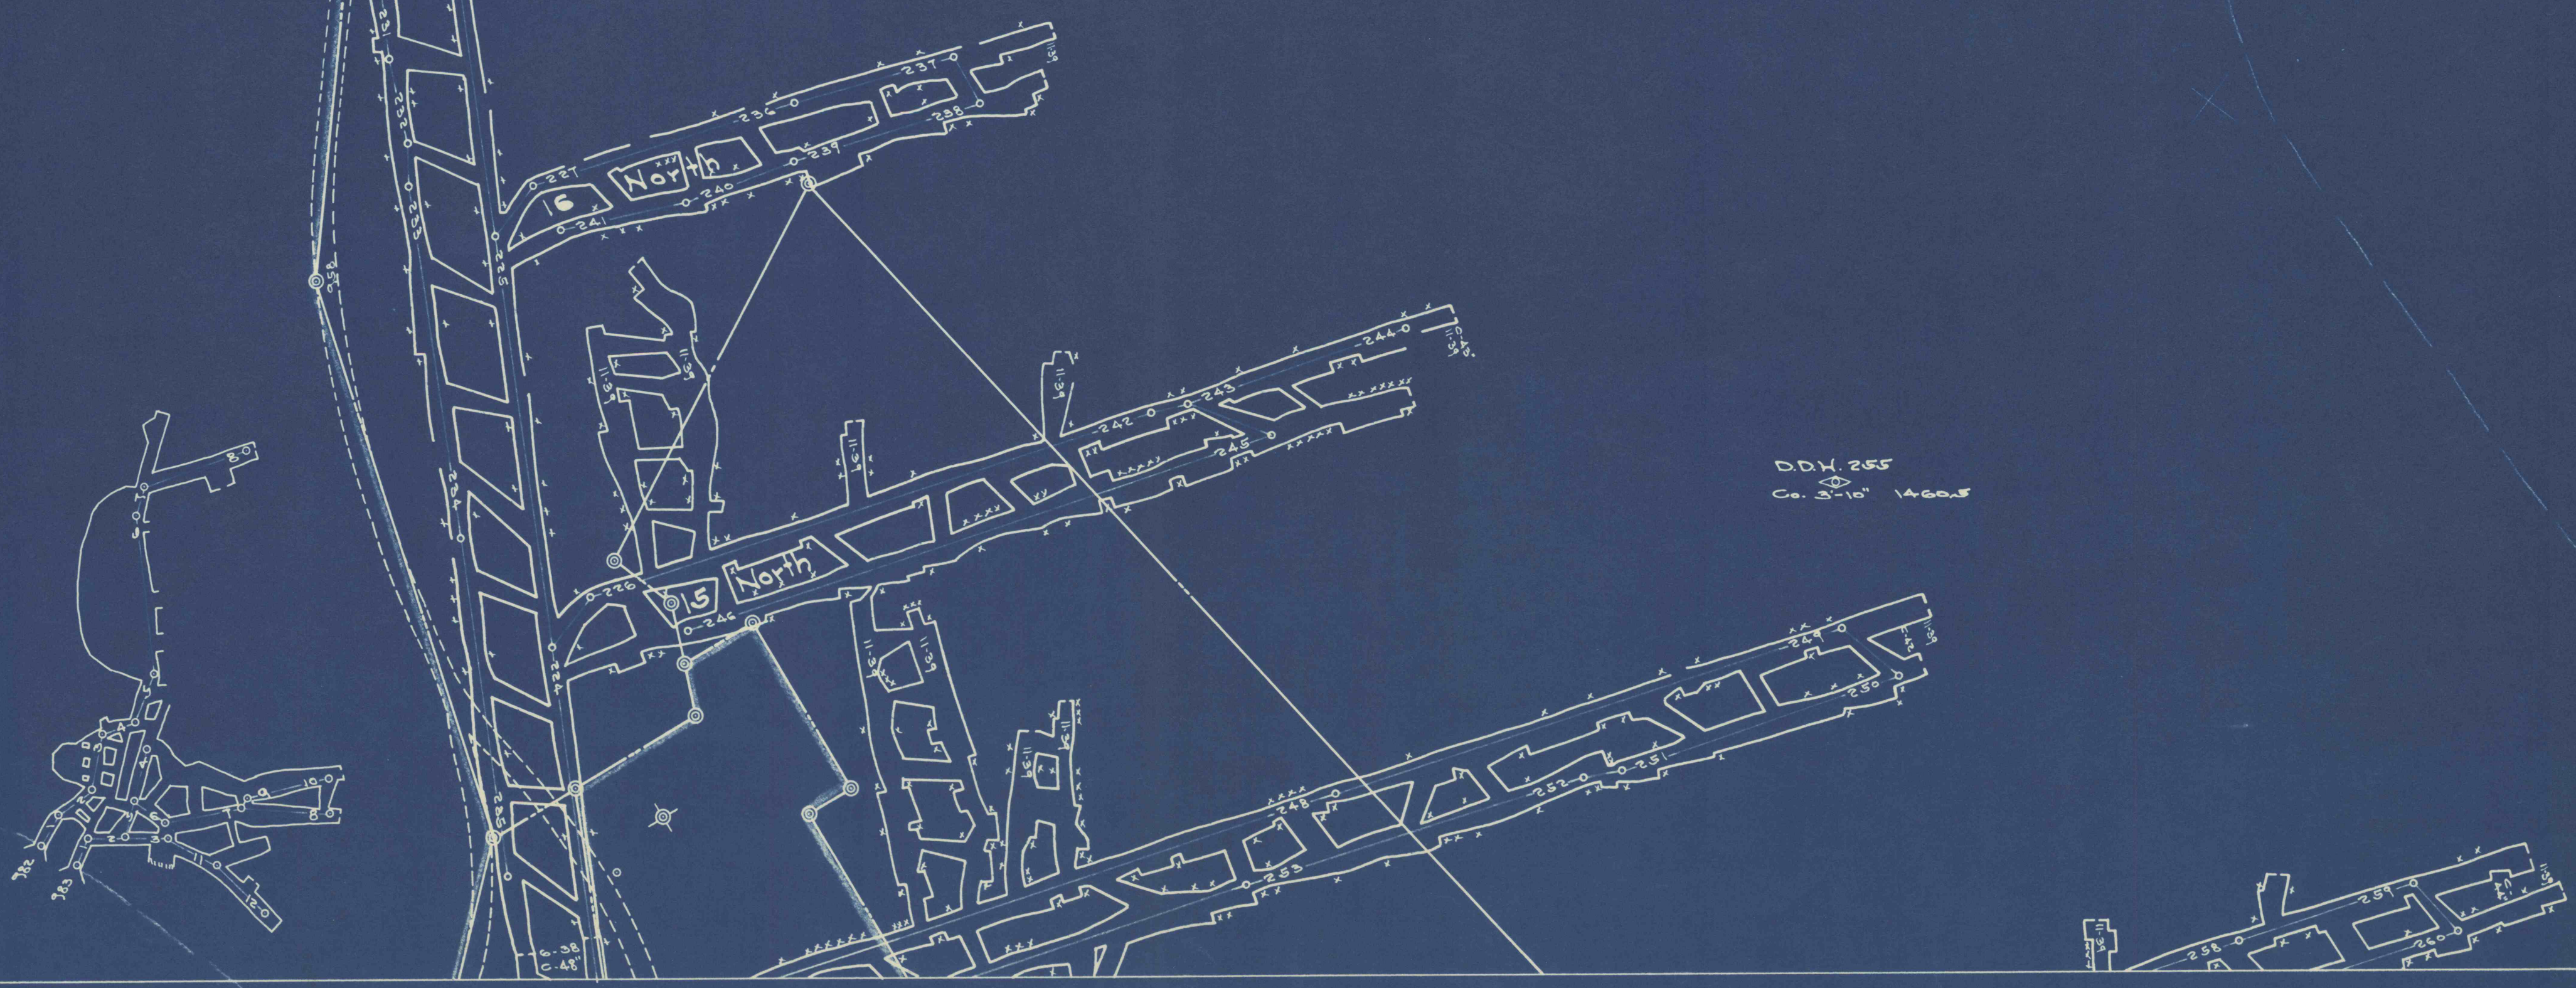

Valier No. 8
Tracing #43-Drawer-67