


*Minesome urban*

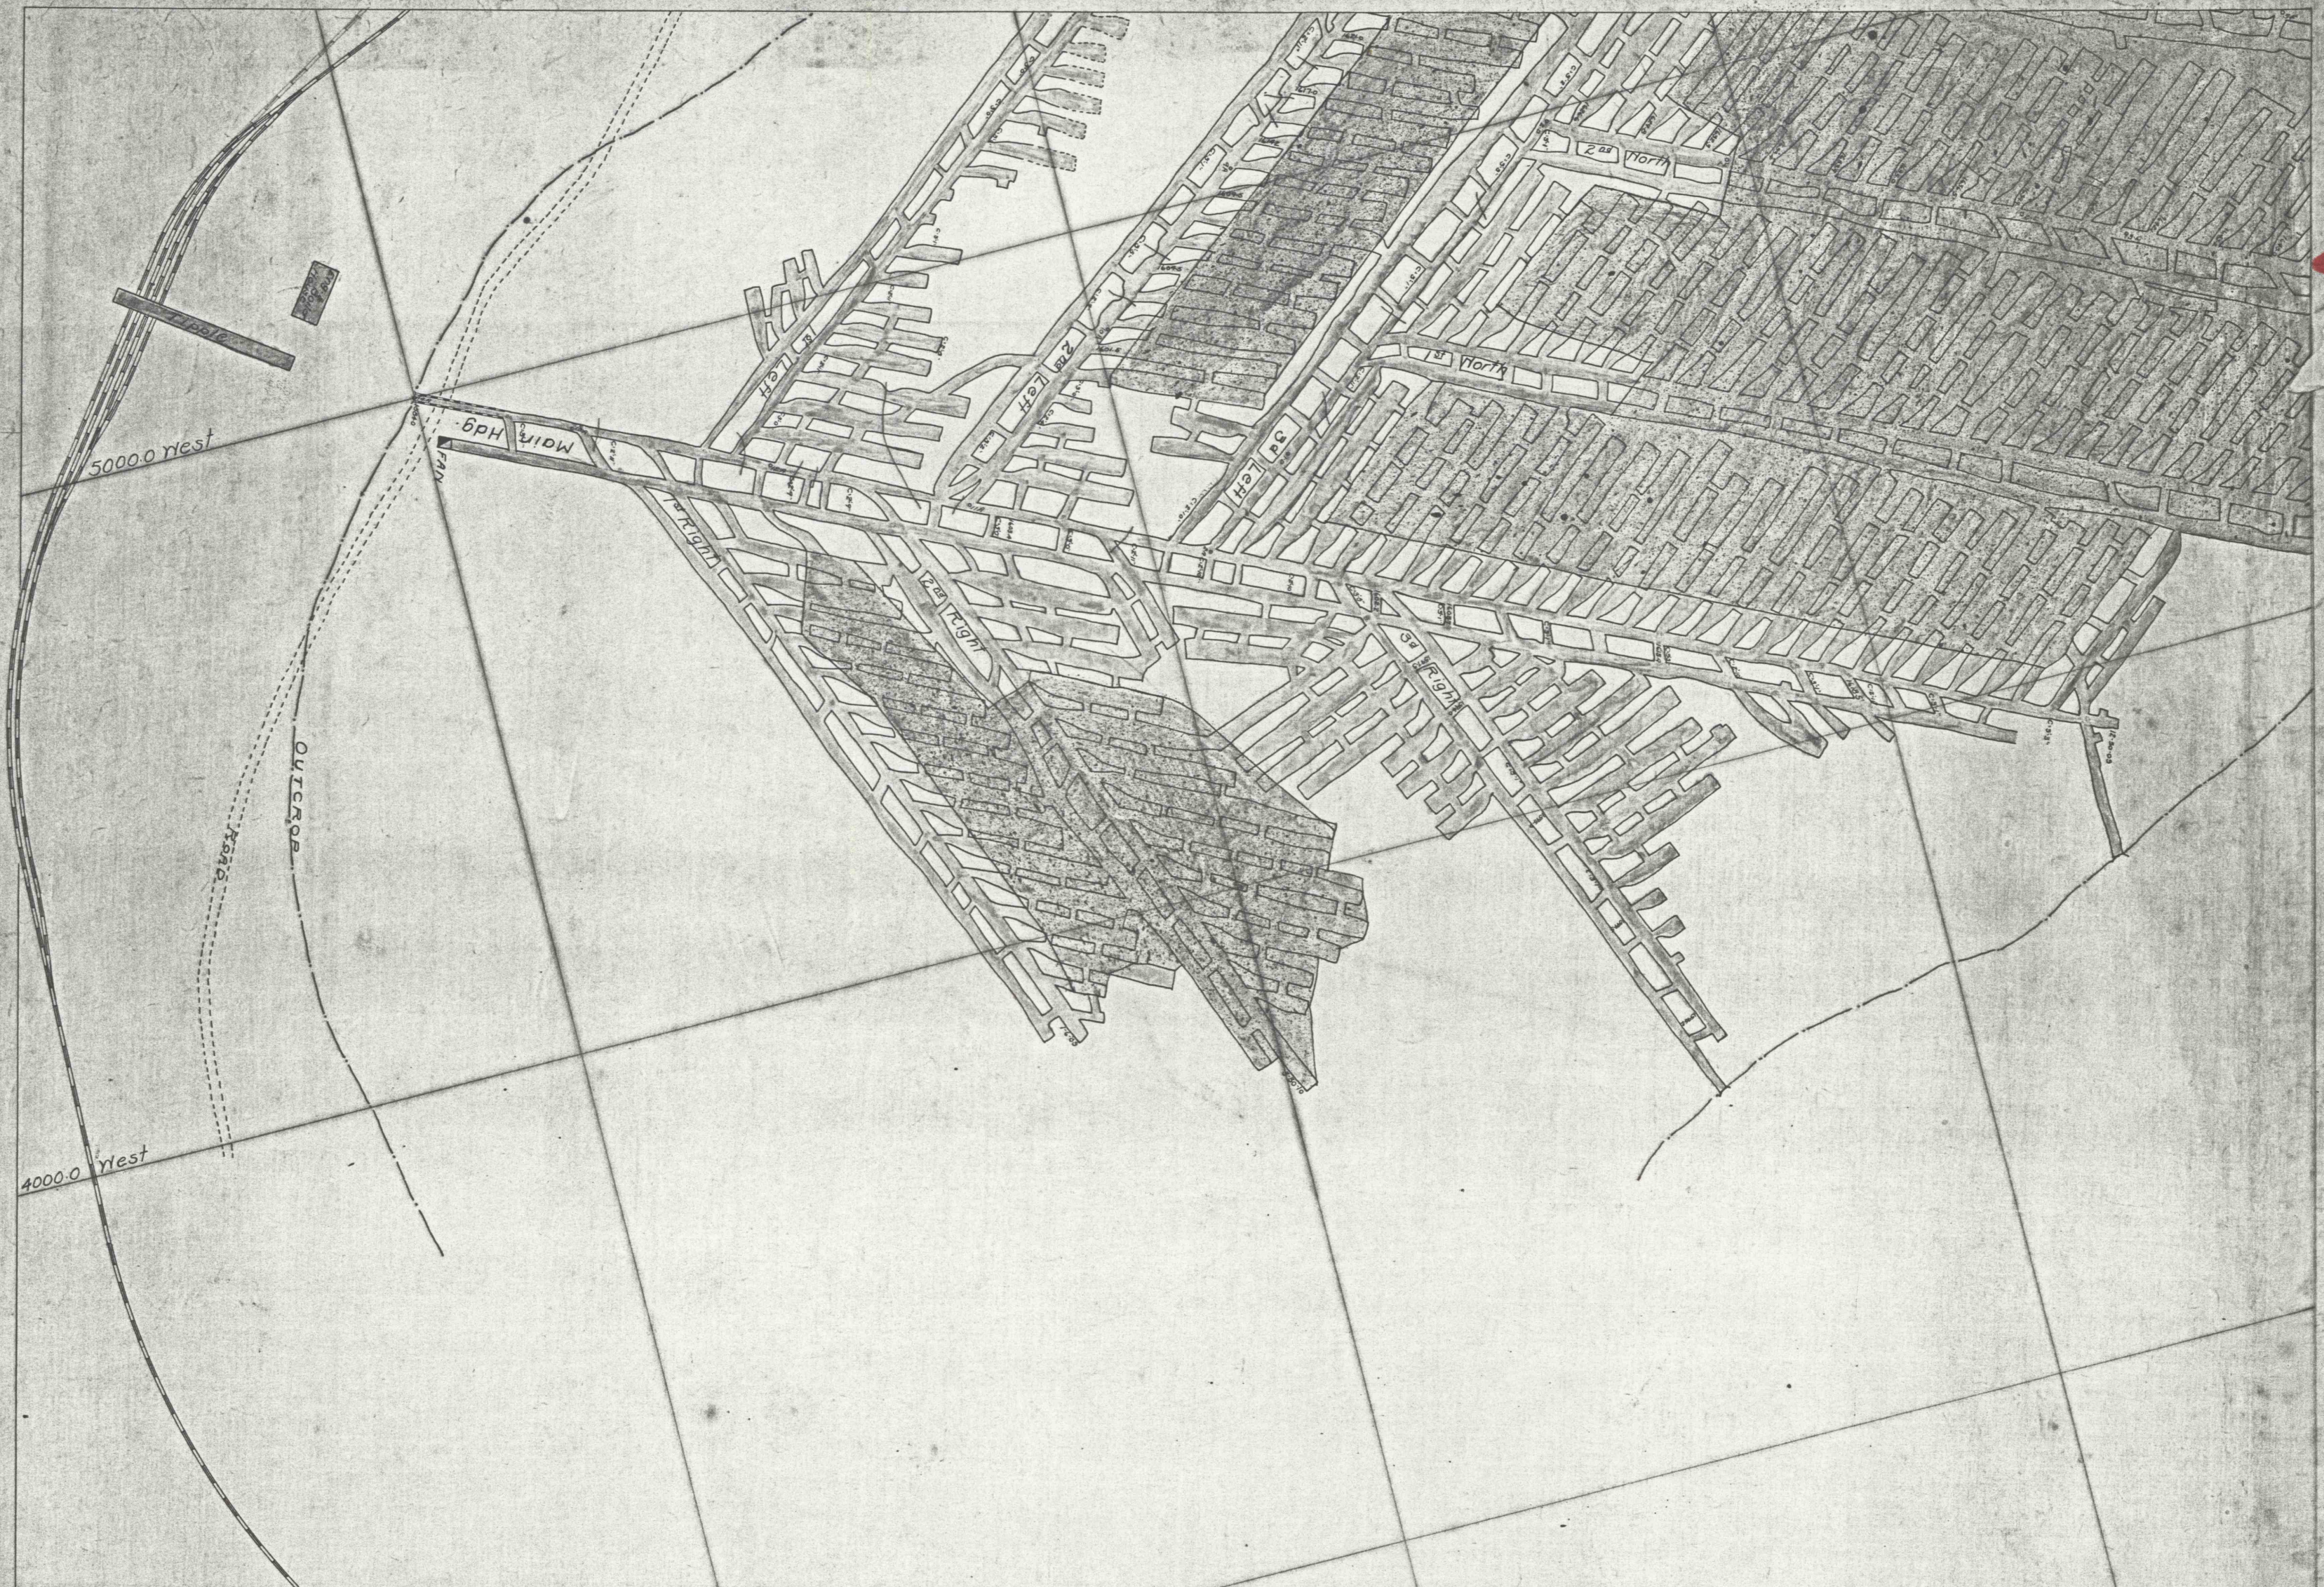

*↑  
motel 1*