




1" = 200'

match 2



match 1

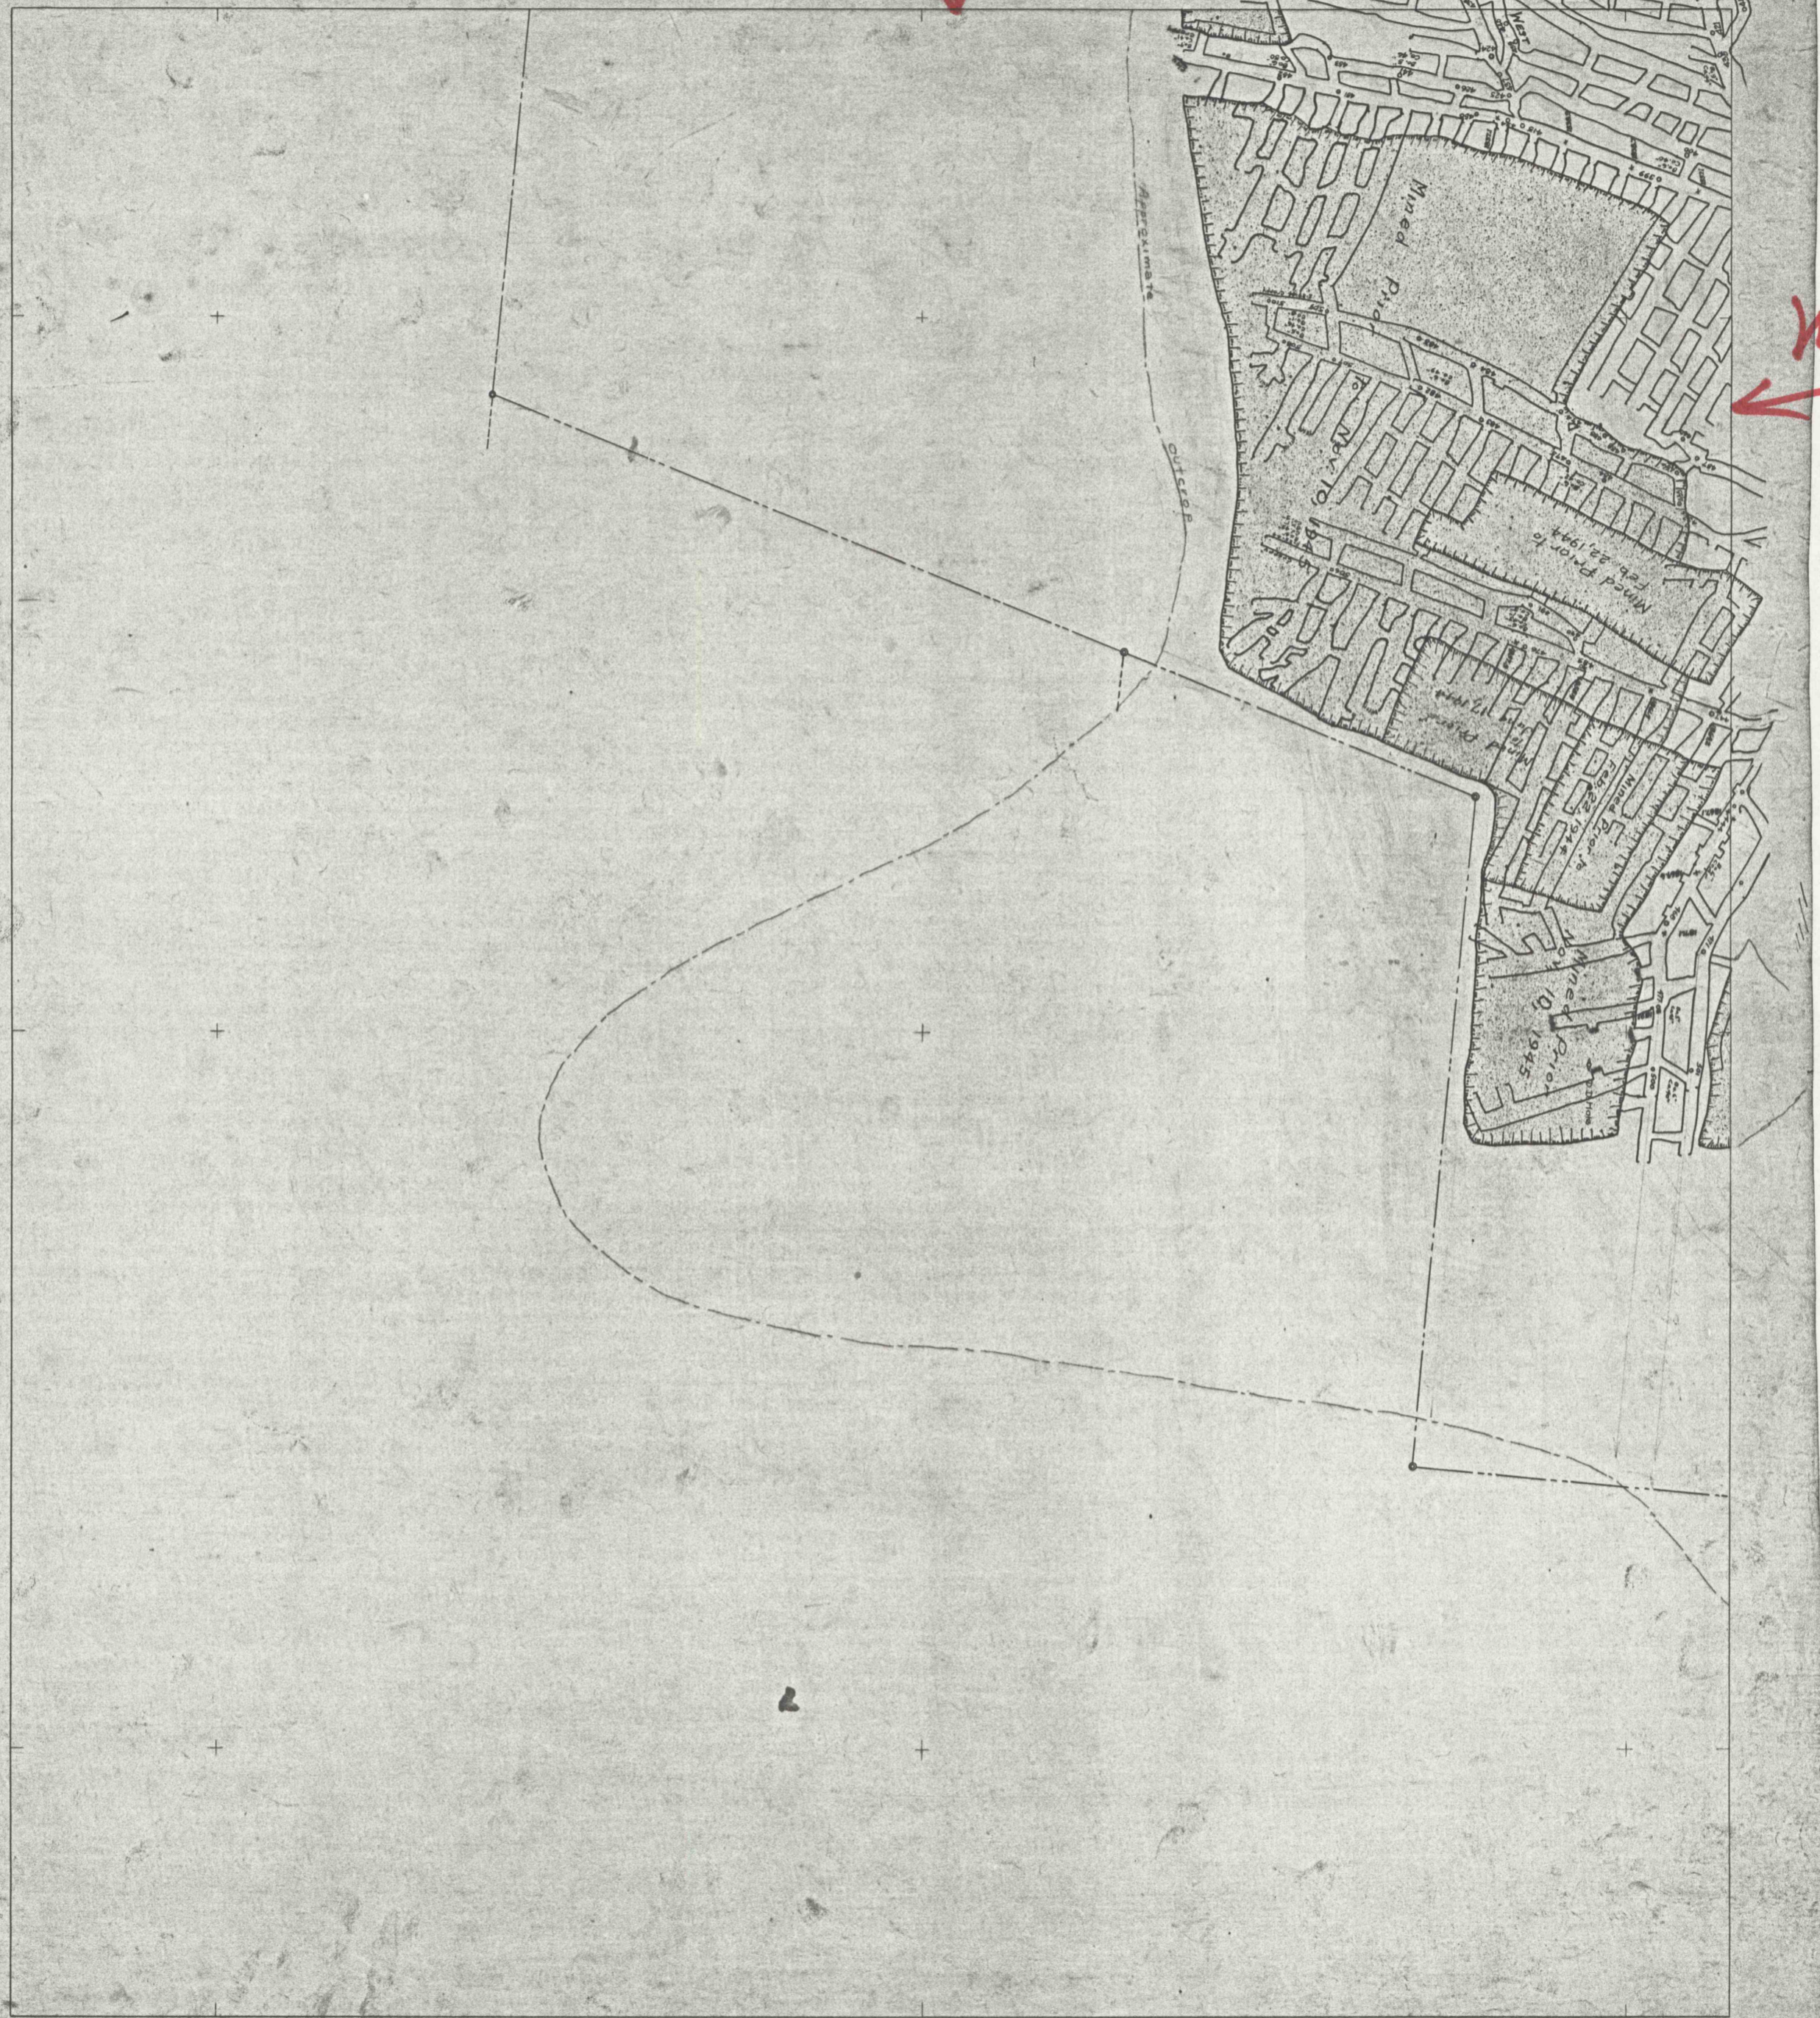

Approximate

OUTSIDE

Mined Pits

Mined from to
Feb. 23, 1944

Mined from
Jan. 12, 1944

Mined from
Oct. 10, 1945