


FIGURE 15.— Generalized columnar sections showing names, average thickness of coal, and intervals between coal beds in the Pennsylvania anthracite fields

For 20% reduction

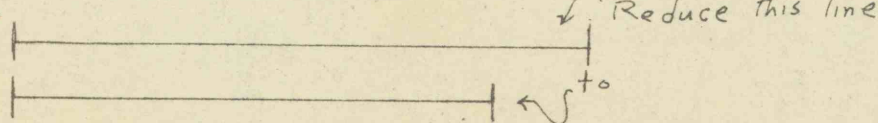

one 1:40,000 scale at this scale

for a 20% reduction
Approximate Result 1/200,000