


EXPLANATION for GH Wood's Tamagua Quad

reviewed 7/72

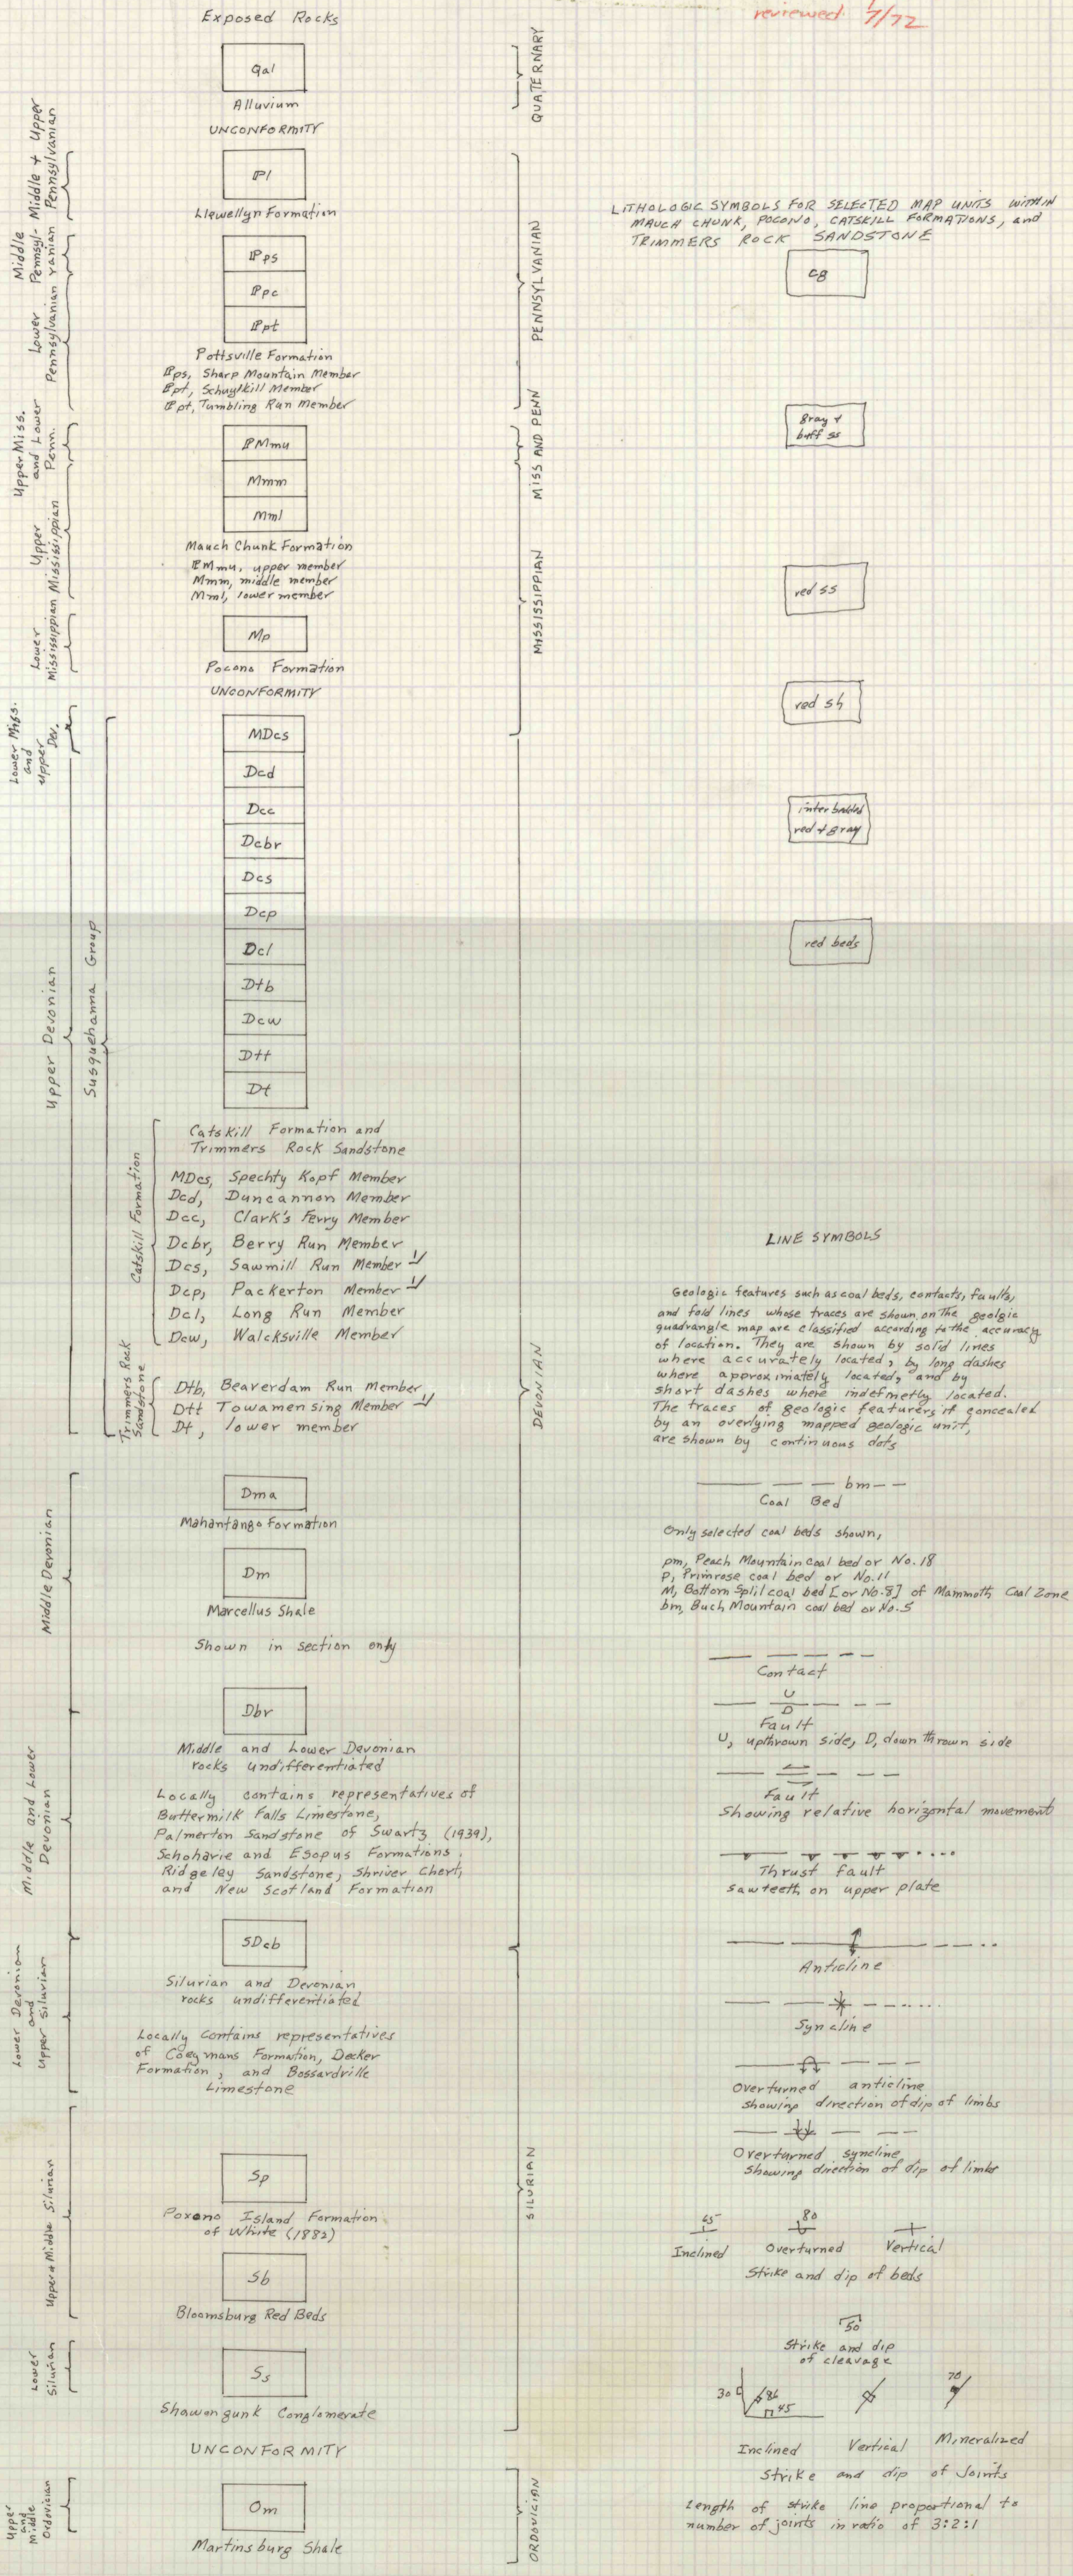

✓ Member of Catskill Formation herein adopted. Sevon, William, 1969, Sedimentology of some Mississippian and Pleistocene deposits of Northeast Pennsylvania in Geology of selected areas in New Jersey and eastern Pennsylvania and Guidebook excursions, Rutgers University Press, New Brunswick, New Jersey, p. 233-234.