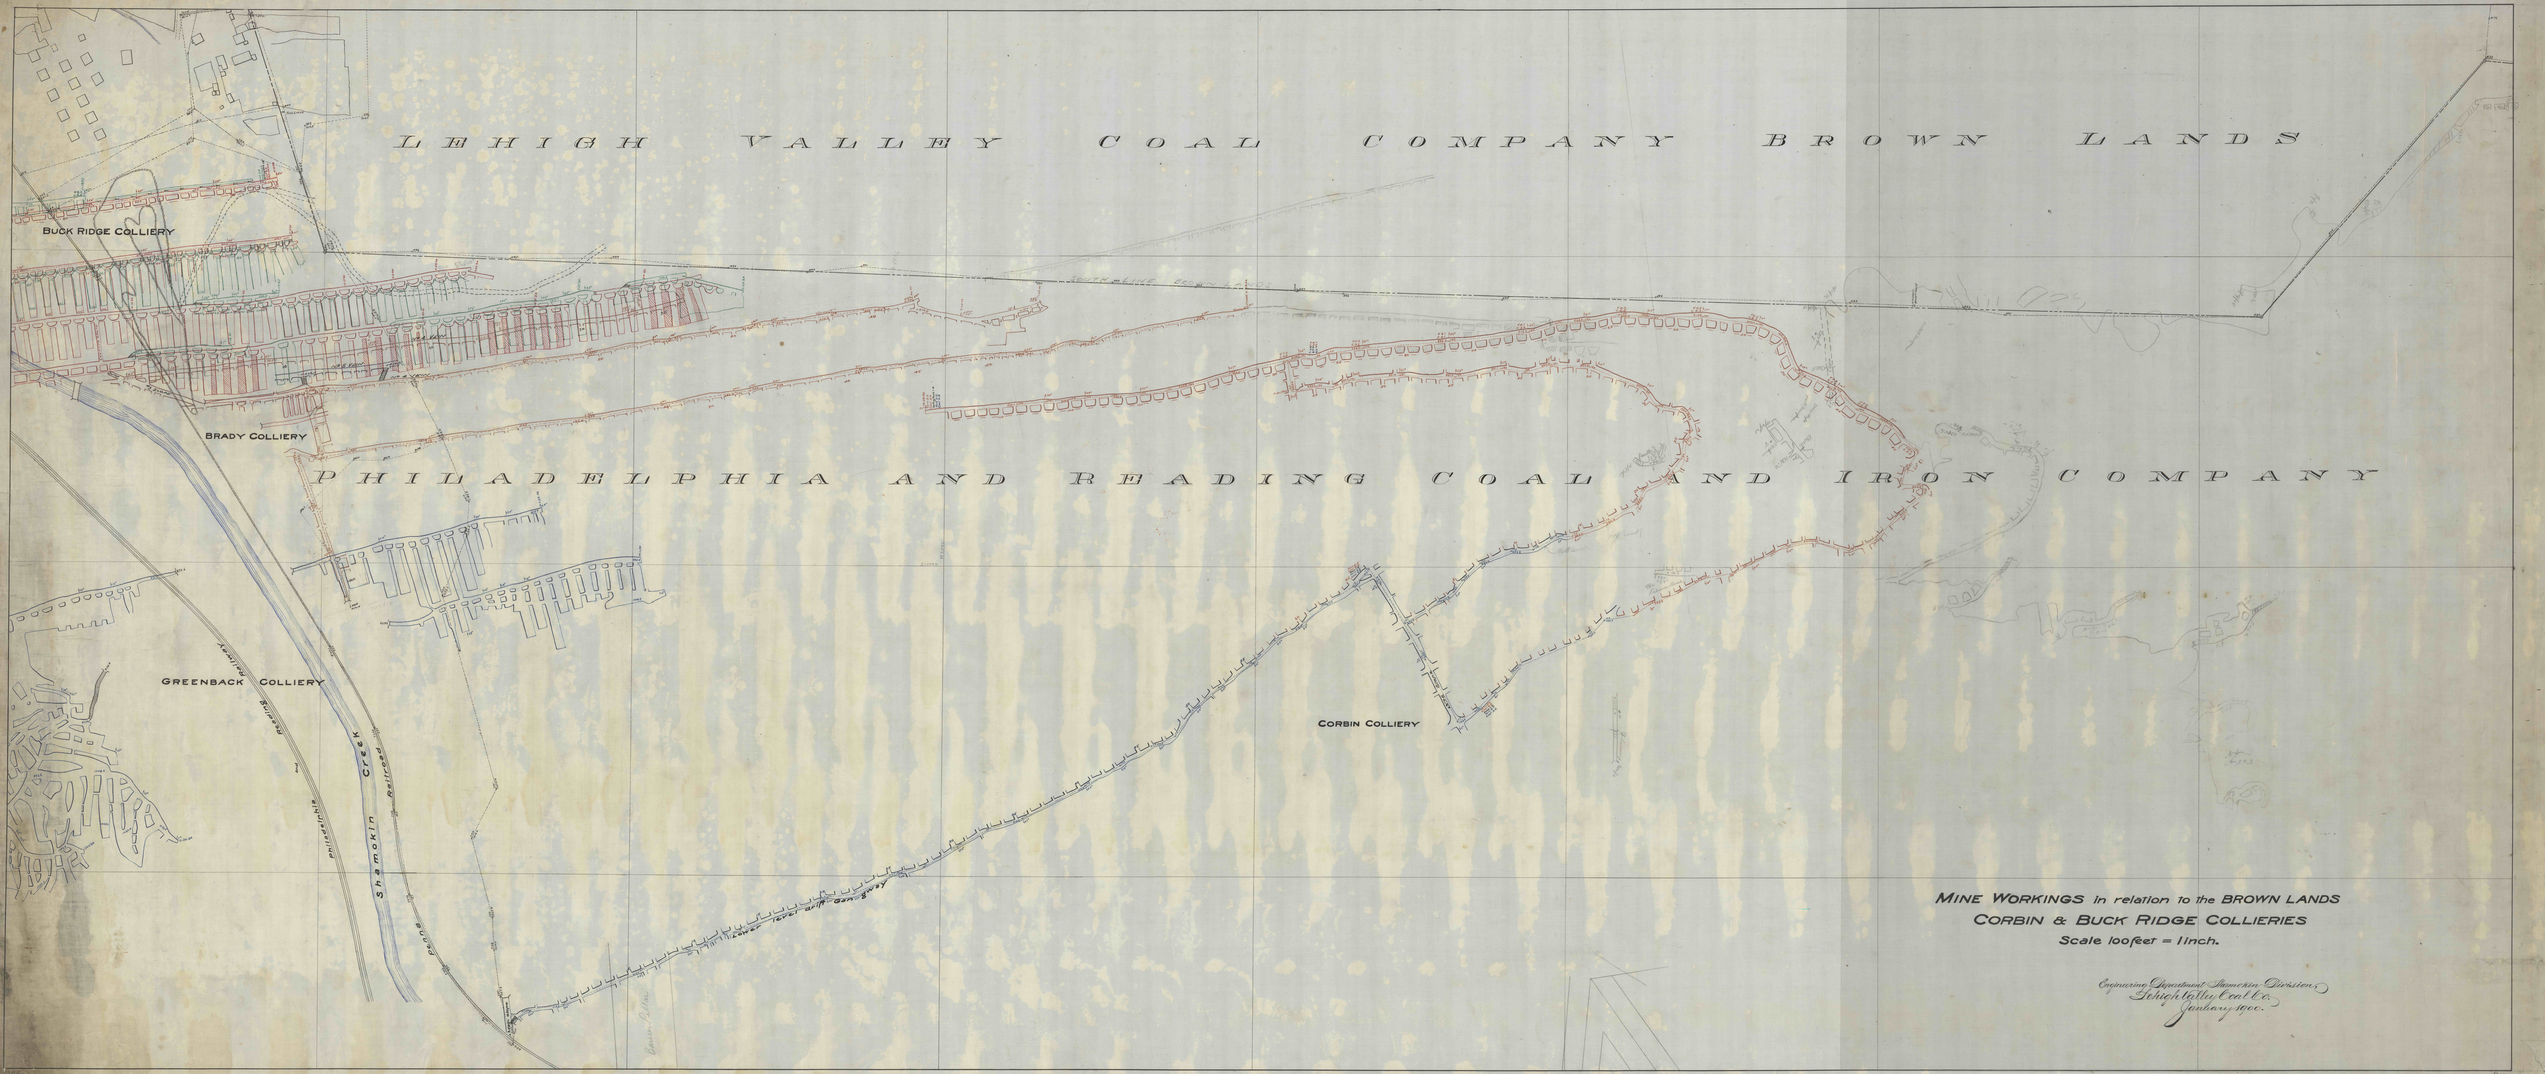

MINE WORKINGS in relation to the BROWN LANDS
CORBIN & BUCK RIDGE COLLIERIES
Scale 100 feet = 1 inch.

Engineering Department Shamokin Division
Lehigh Valley Coal Co.
January 1900.