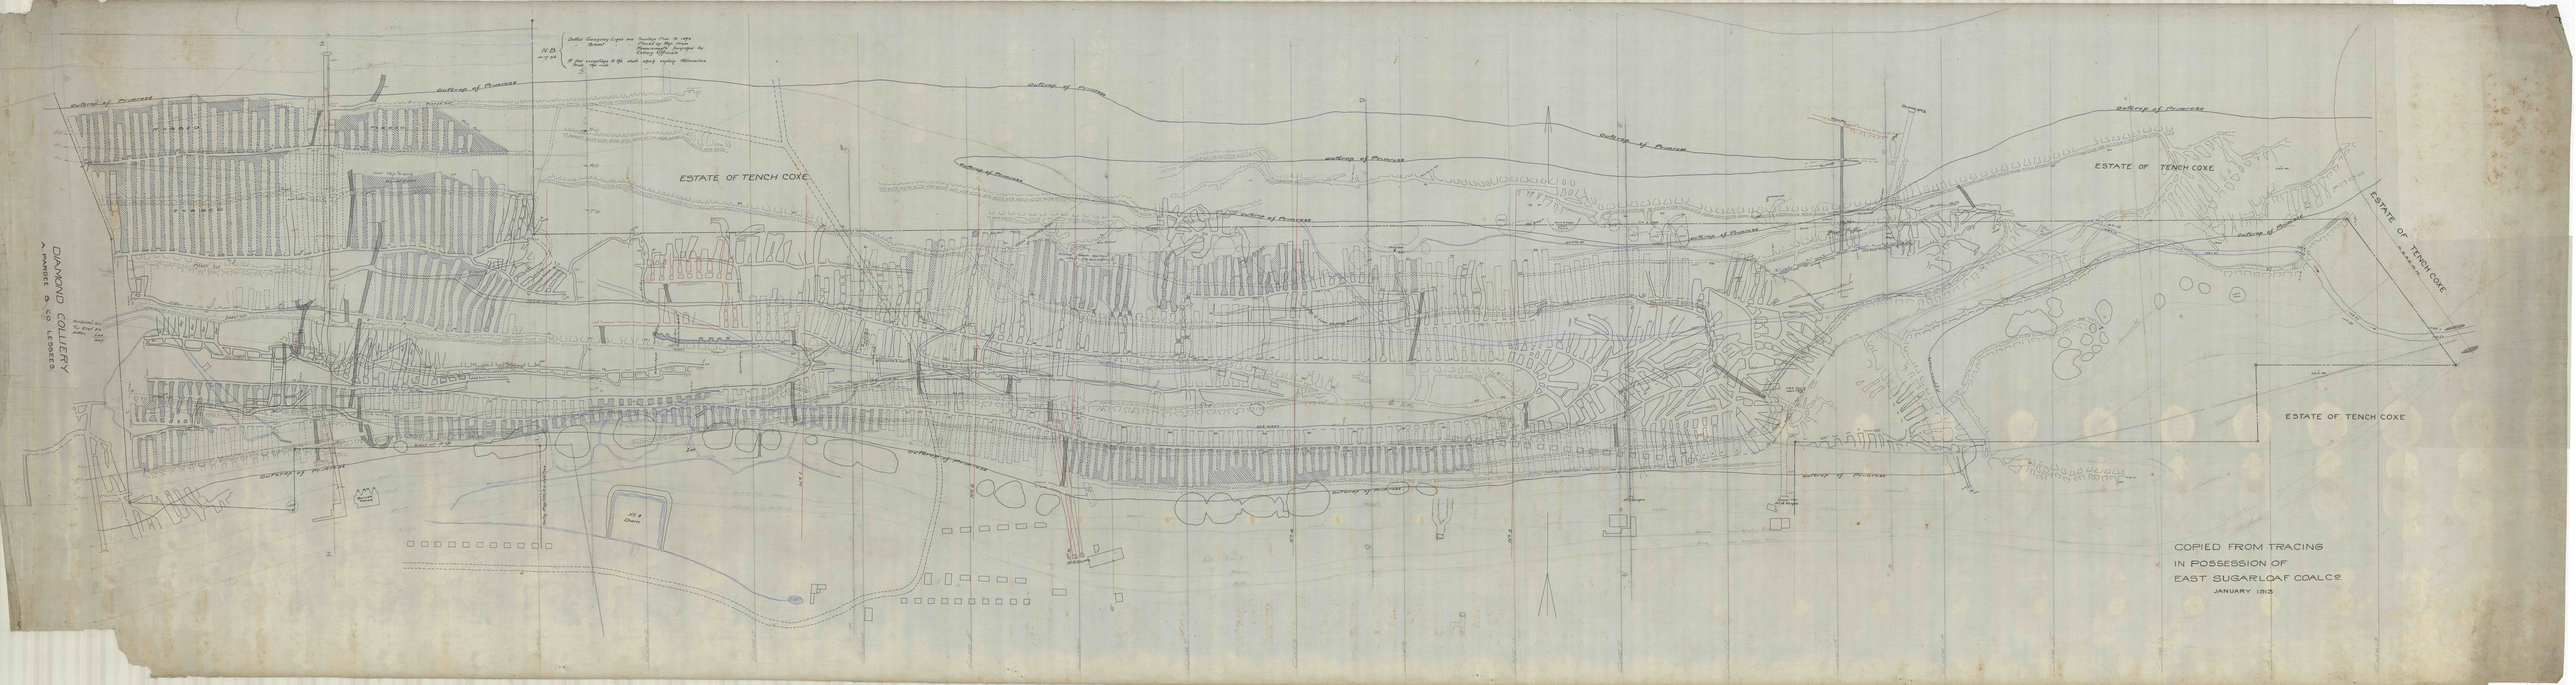

DIAMOND COLLIERY
ESTATE OF TENCH COXE
ESTATE OF TENCH COXE
ESTATE OF TENCH COXE
ESTATE OF TENCH COXE
Outcrop of Primrose
COPIED FROM TRACING
IN POSSESSION OF
EAST SUGARLOAF COAL Co
JANUARY 1913