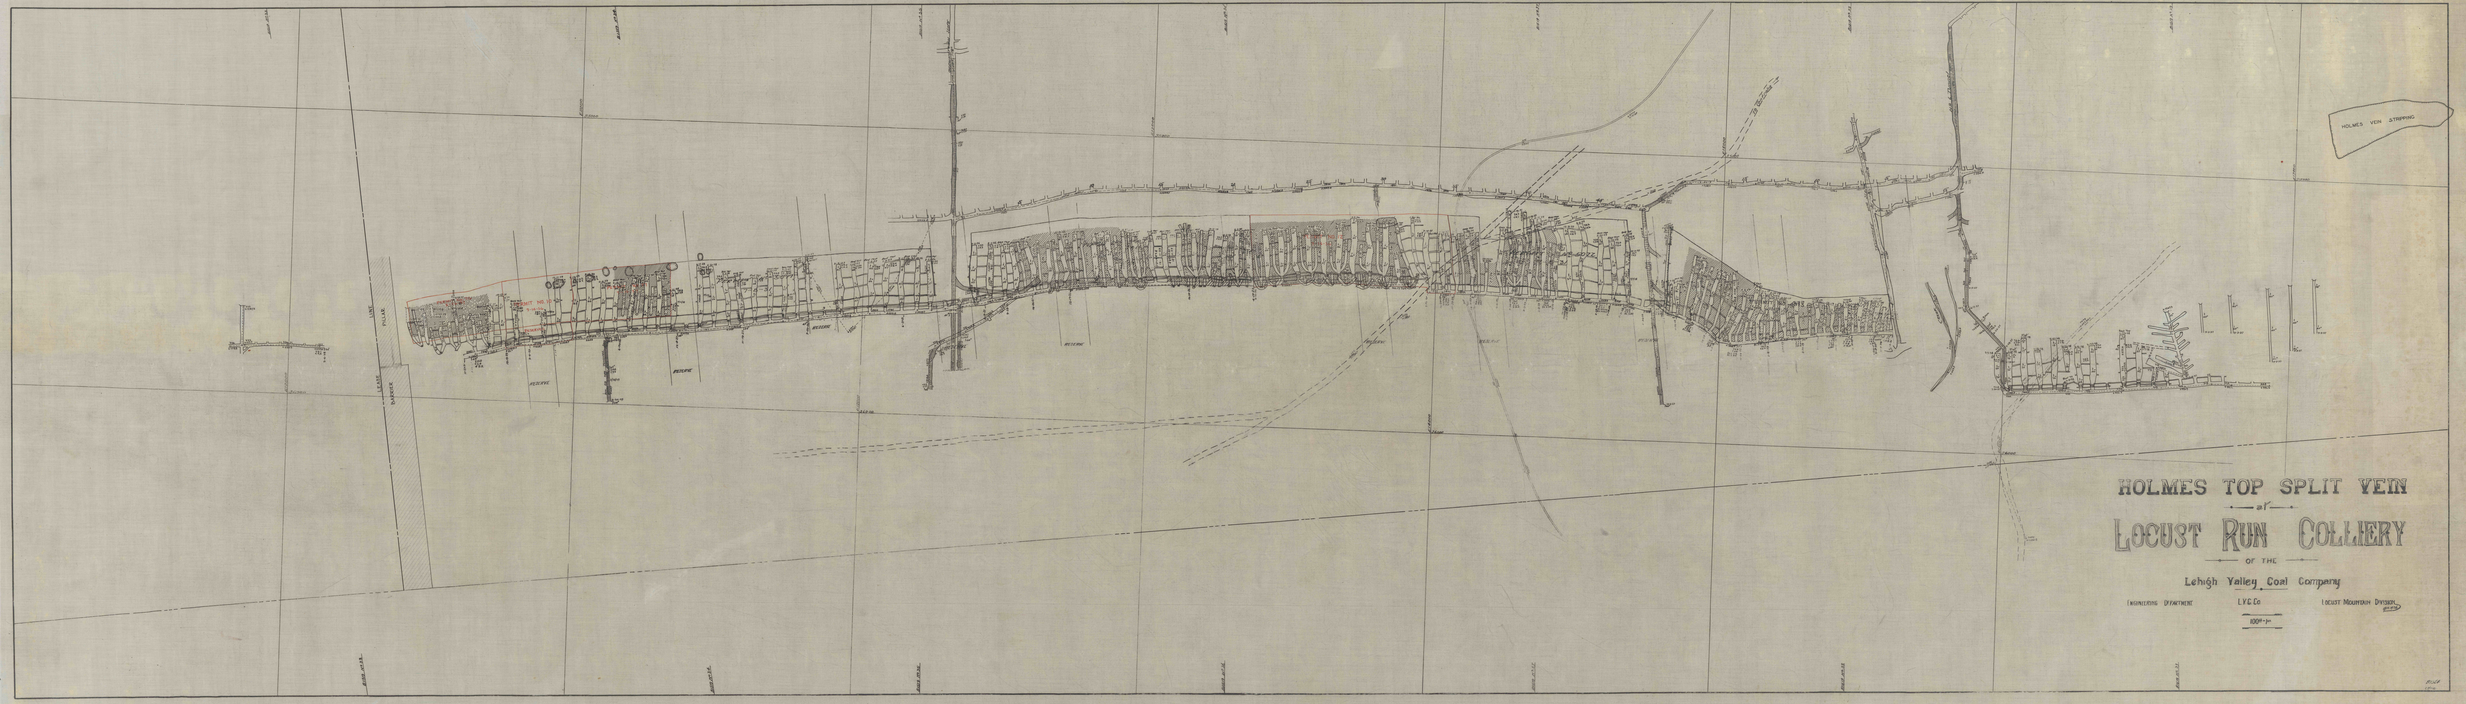

HOLMES VEIN STRIPPING
LARGE PILLAR BARRIER
HOLMES TOP SPLIT VEIN
at
LOCUST RUN COLLIERY
OF THE
Lehigh Valley Coal Company
ENGINEERING DEPARTMENT
L.V.C.Co
LOCUST MOUNTAIN DIVISION
100ft=1in