


use for base map.
 See vol map.
 Principal structural features
 index map of strat. sections

WESTERN MIDDLE FIELD
 outline of base of Pennsylvanian
 Prepared for 20% reduction
 January 6, 1965

(Sharp) 20% reduction
 2/9/65
 5 Pitt 20%
 29/022 1965
 881838
 19/022 1965
 17/11/65

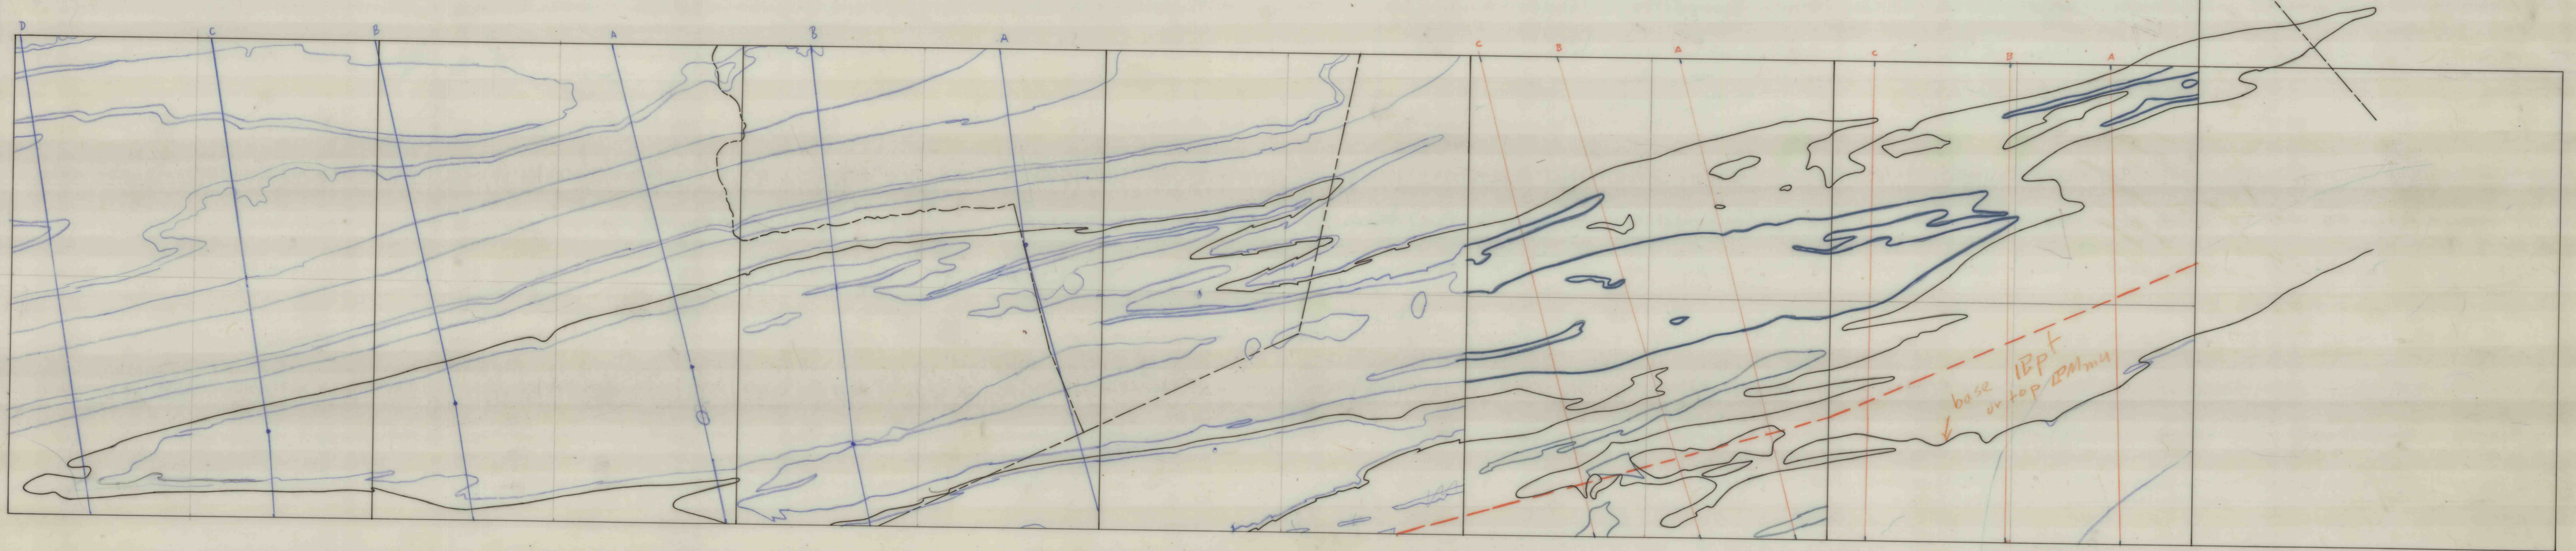

0 2 4 6 MILES
 For 20% reduction so that 2 mi = 1 in

3/73
 Formation contacts