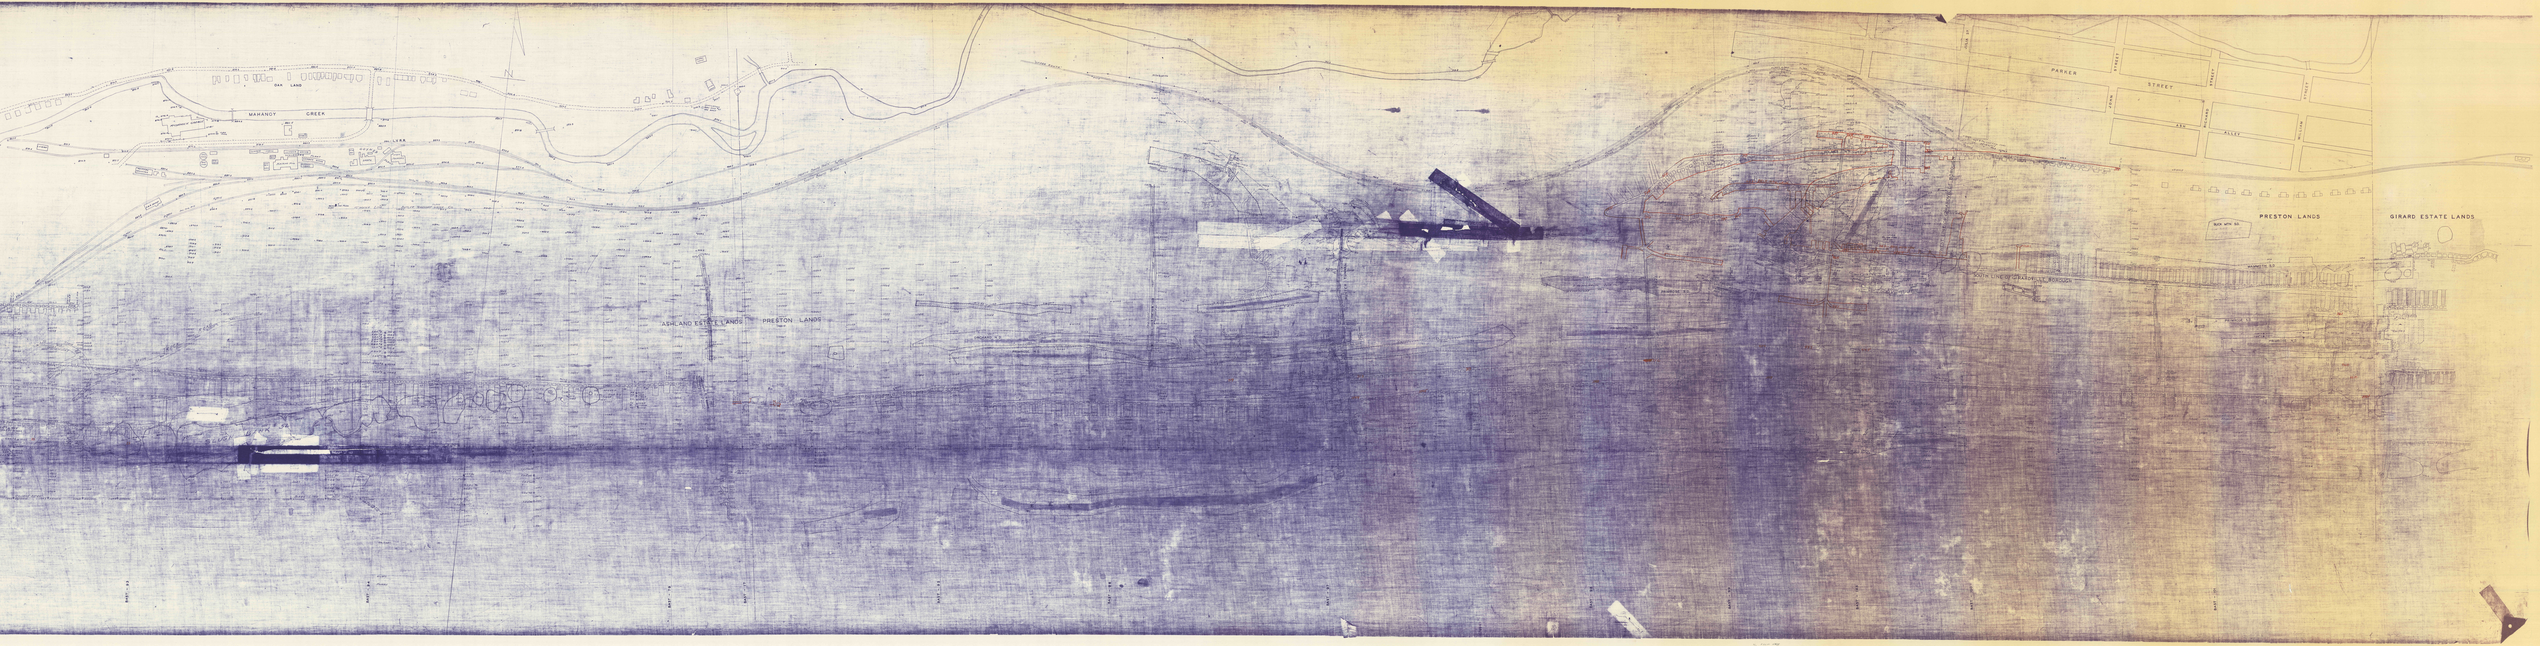

MAHANOY CREEK
OAK LAND
ASHLAND ESTATE LANDS
PRESTON LANDS
PARKER STREET
ALLEY
PRESTON LANDS
GIRARD ESTATE LANDS
BOX MINE RD
