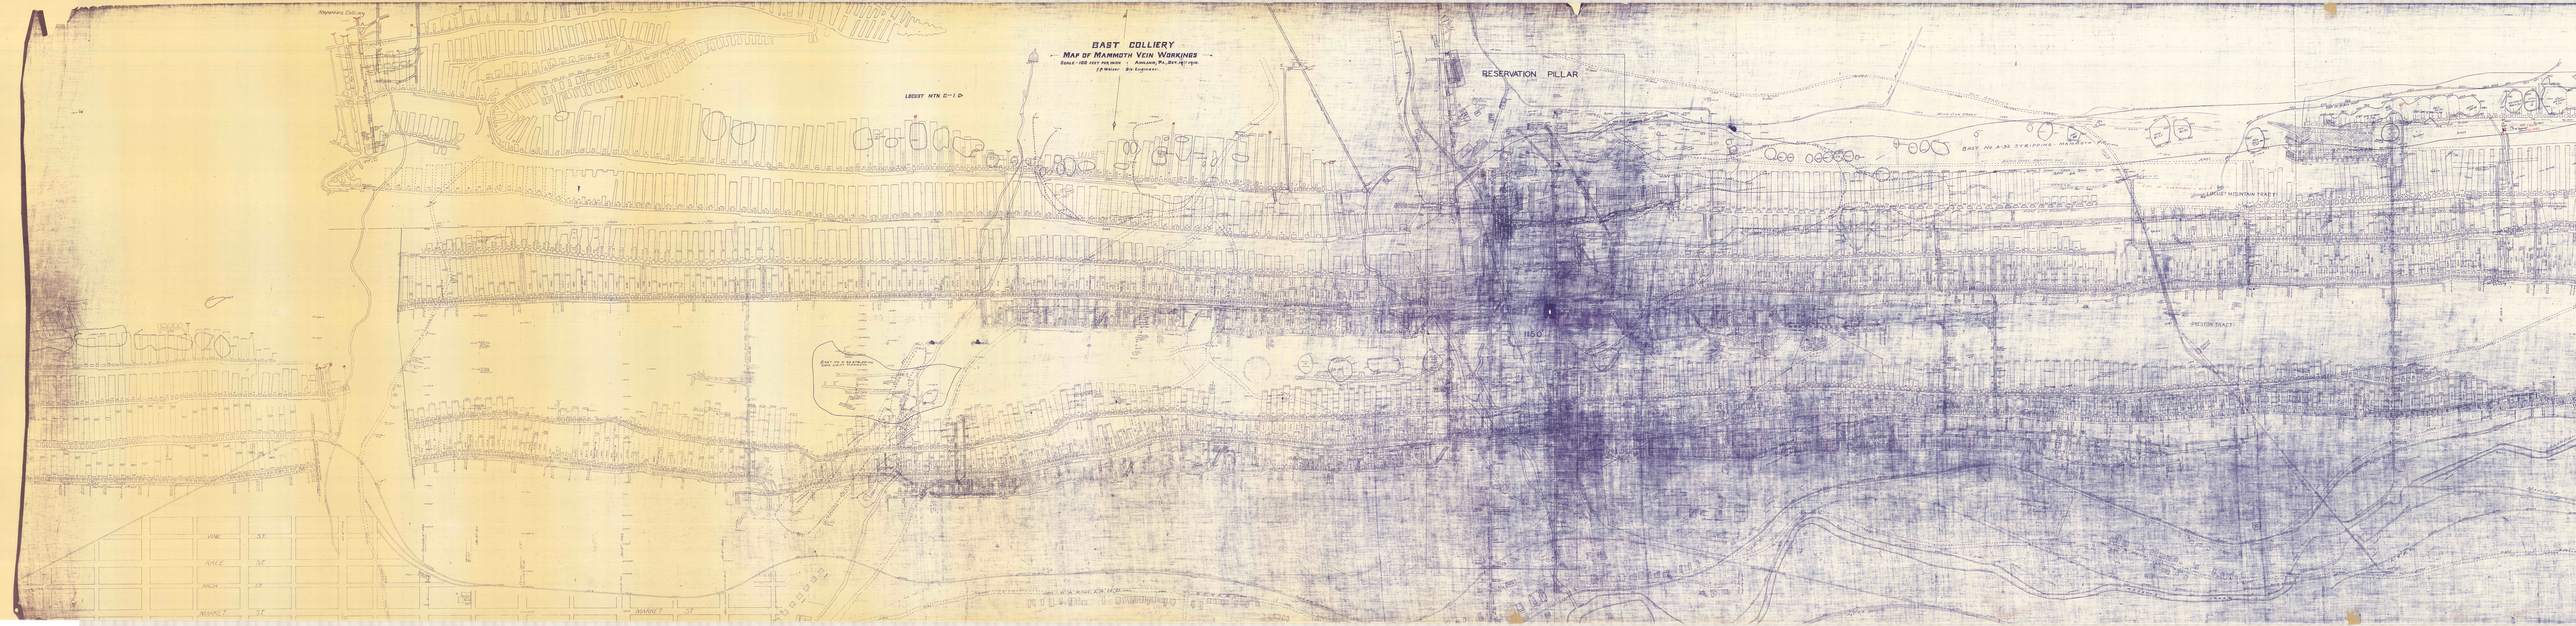

EAST COLLIERY
MAP OF MAMMOTH VEIN WORKINGS
SCALE - 100 FEET PER INCH
ASHLAND, PA., DEC. 1ST 1910.
J.P. WOLFE, Div. Engineer.
LOCUST MTN. C-I.D.
RESERVATION PILLAR
EAST NO. 4-35 STRIPPING - MAMMOTH VEIN
LOCUST MOUNTAIN TRACT
PRESTON TRACT
VINE ST.
RACE ST.
MAIN ST.
MARKET ST.
MARKET ST.
1150