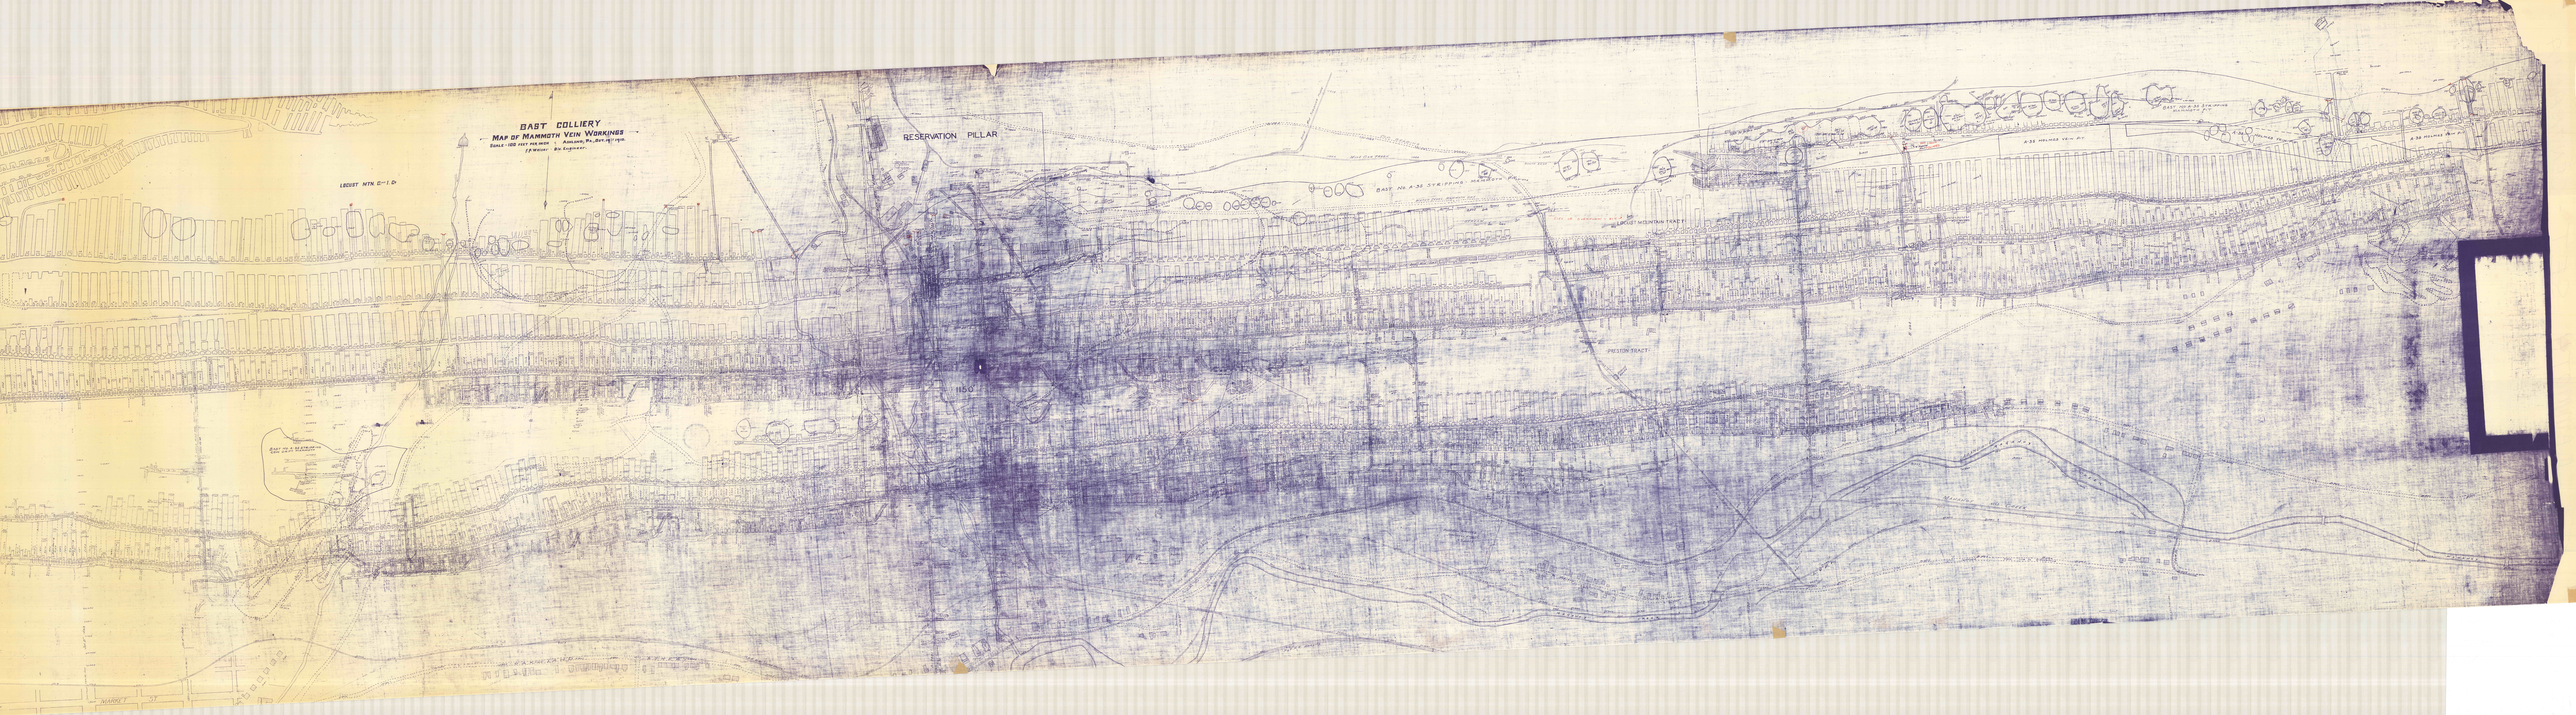
BAST COLLIERY
MAP OF MAMMOTH VEIN WORKINGS
RESERVATION PILLAR
LOCUST MTN. C-I &
BAST NO. 4 SLOPE
BAST NO. 4-35 STRIPPING
A-35 HEADING
PISTON TRACT
1150