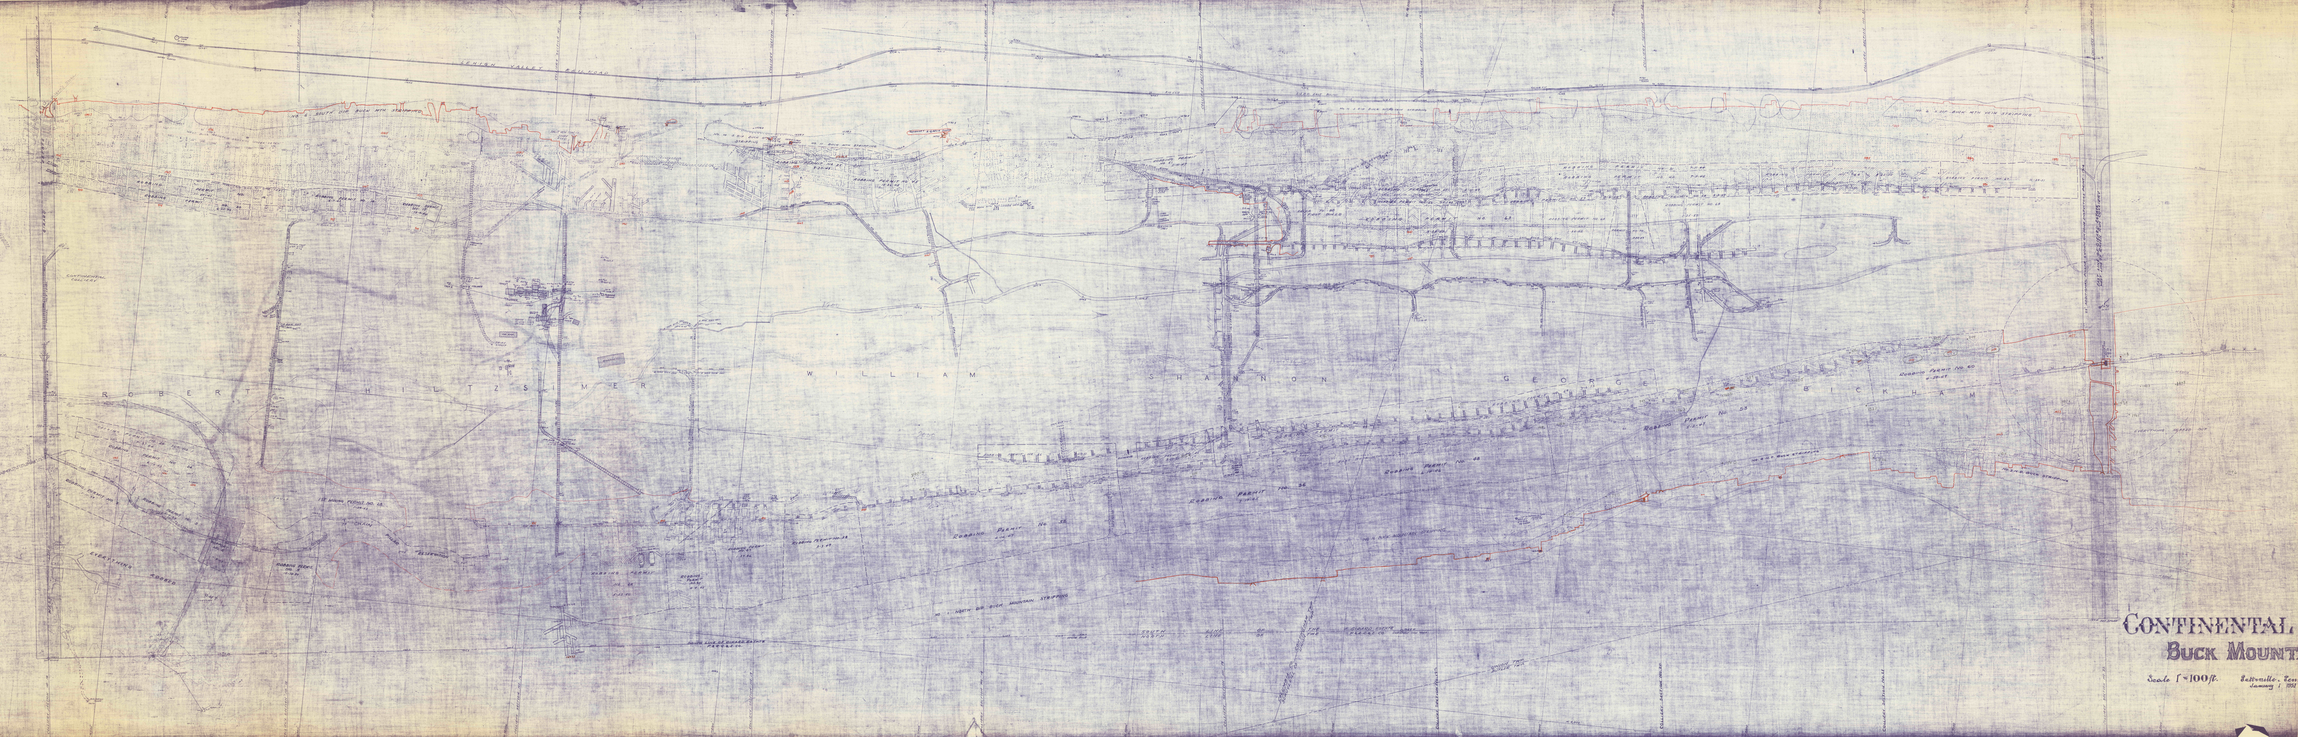


CONTINENTAL COLLIERY

BUCK MOUNTAIN BED

Scale 1"=100 ft. Pottsville, Pennsylvania, January 1, 1902. W. P. McWilliams, Mining Engineer & Surveyor.