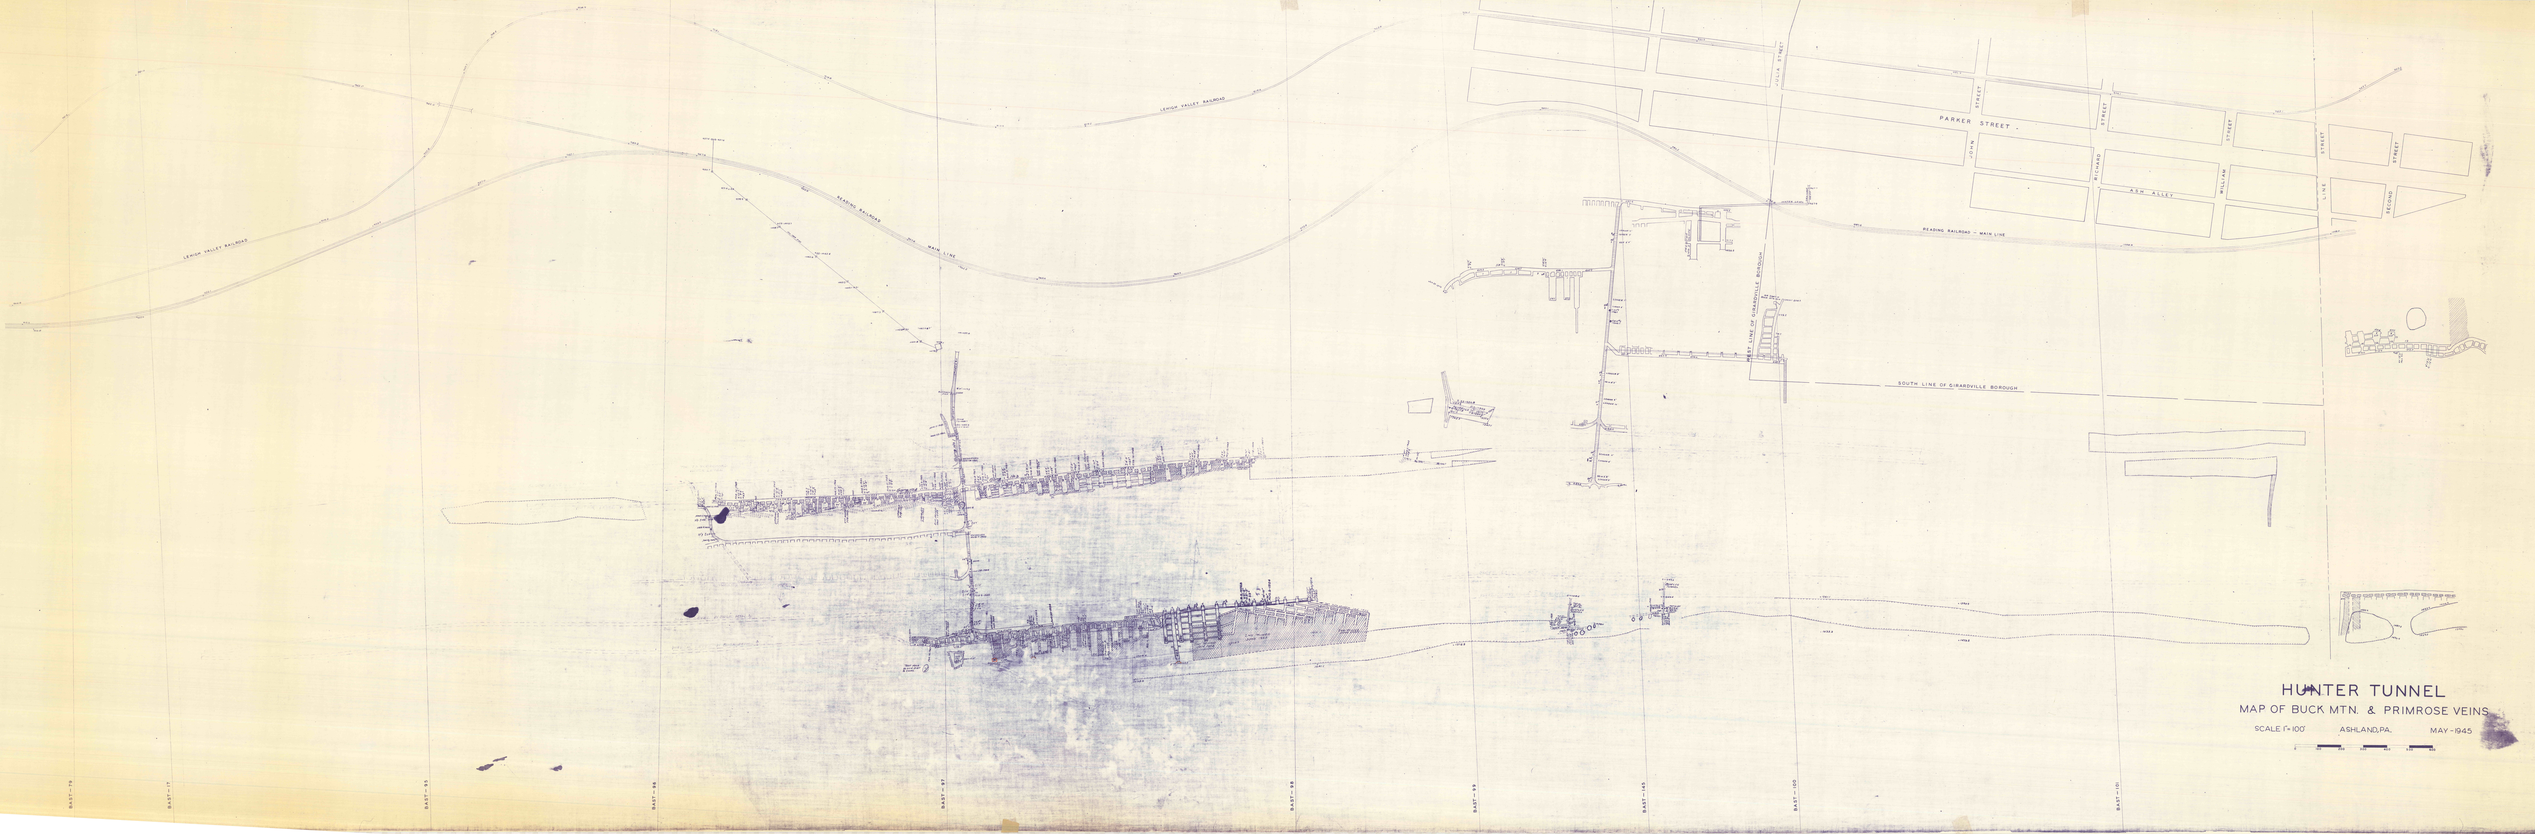

HUNTER TUNNEL

MAP OF BUCK MTN. & PRIMROSE VEINS

SCALE 1"=100' ASHLAND,PA. MAY - 1945