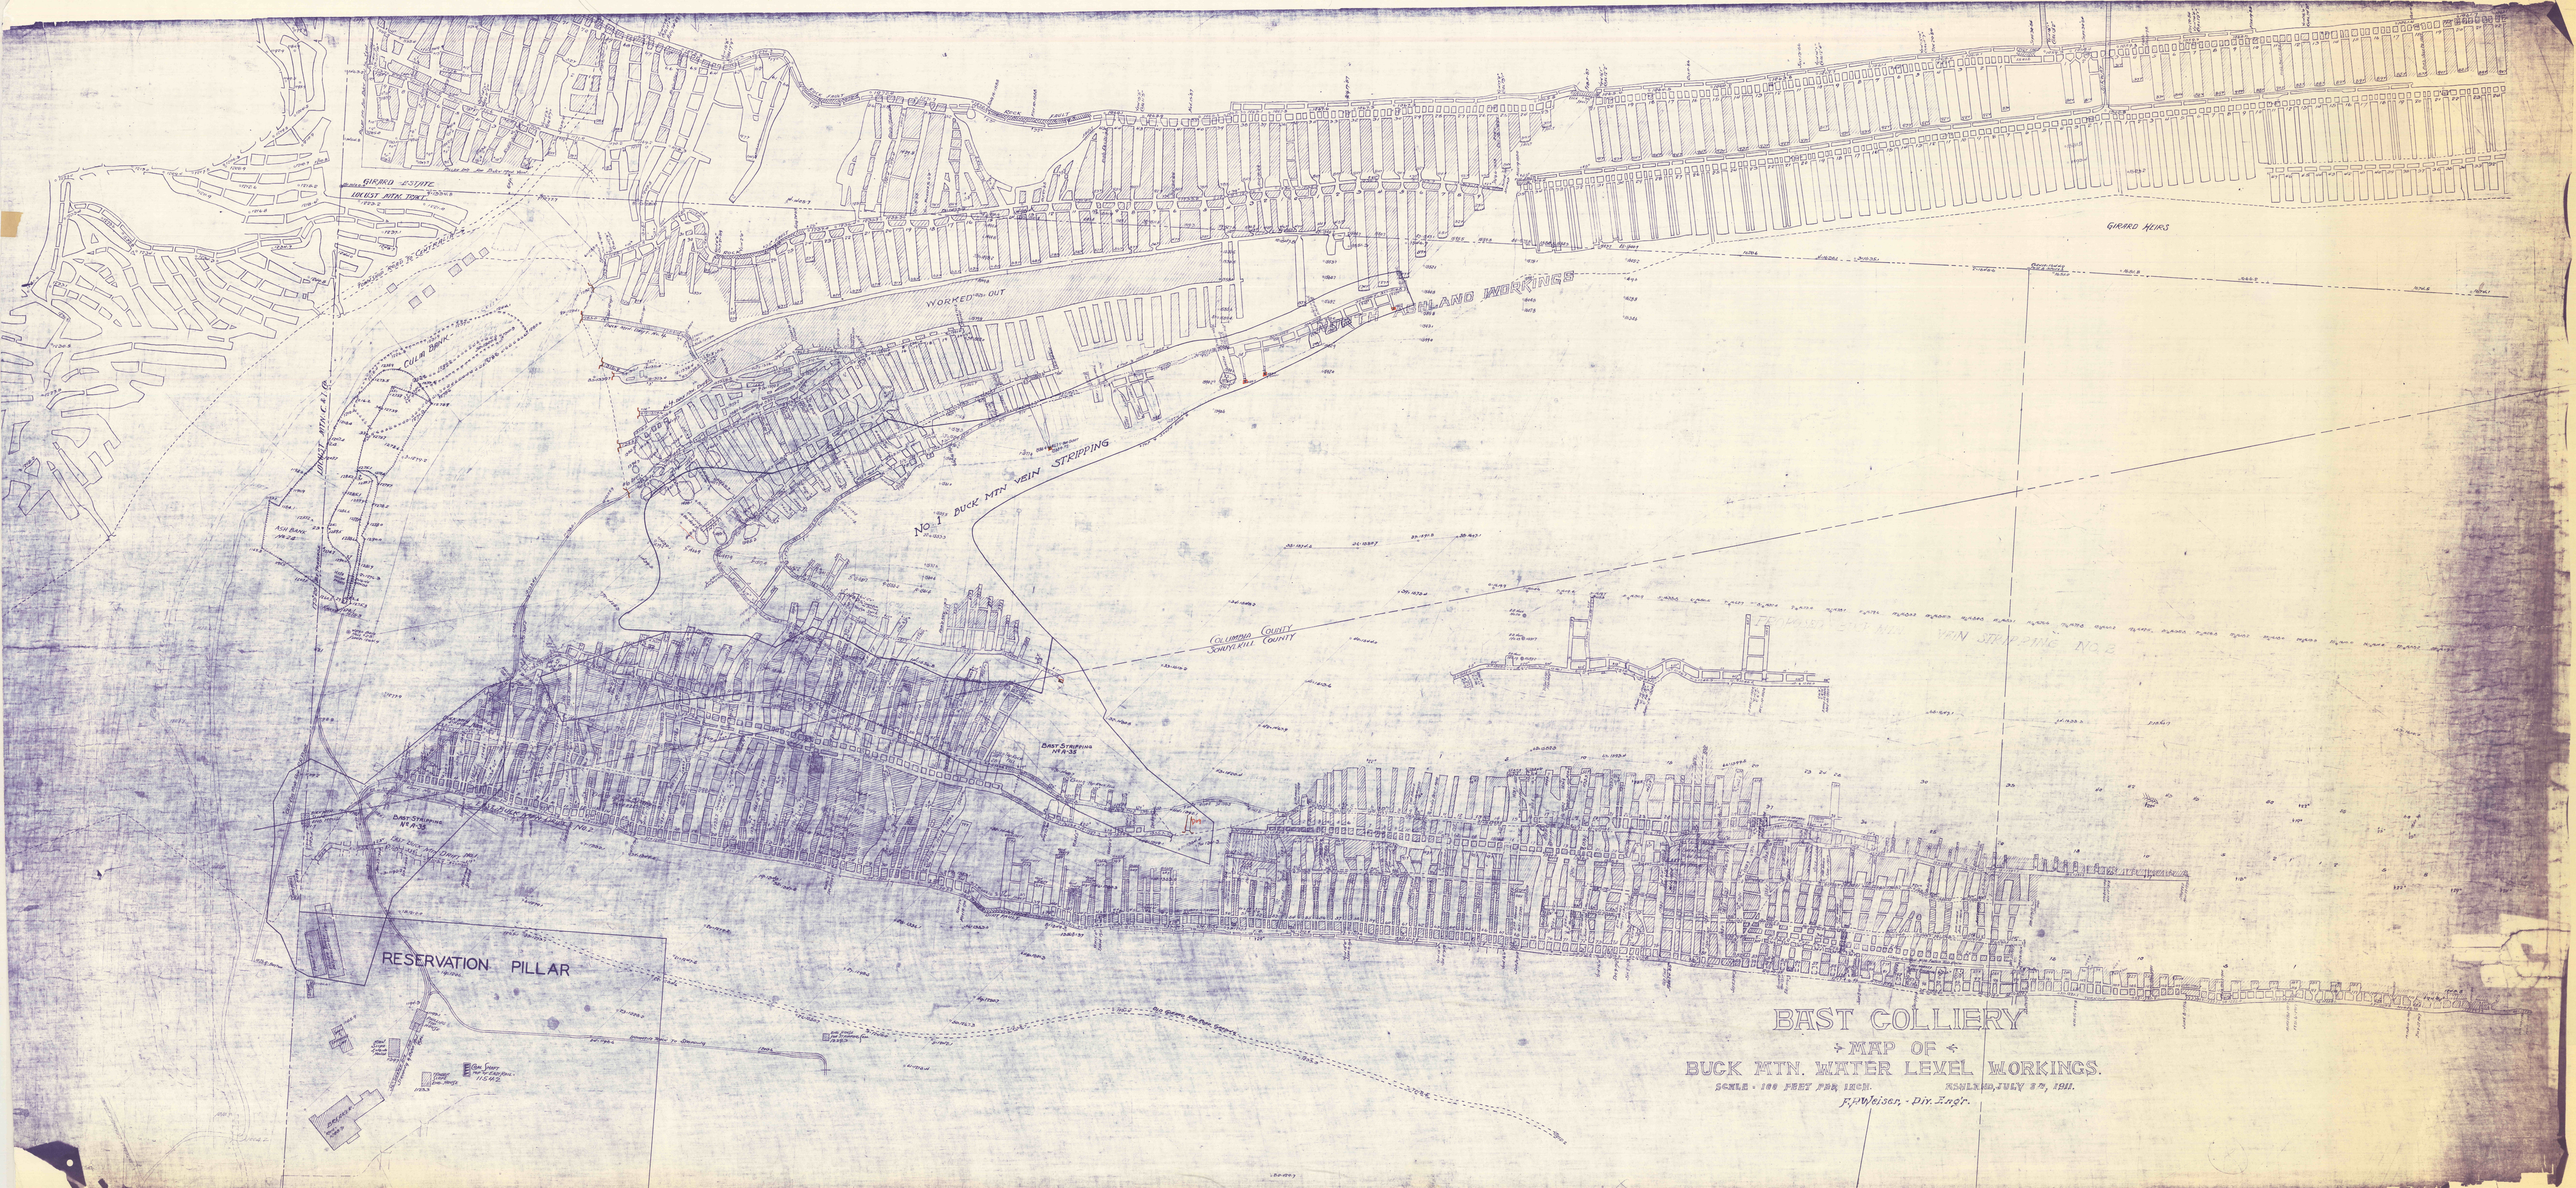
GIRARD ESTATE
LOCKST MTN. TONT.
WORKED OUT
HIGHLAND WORKINGS
GIRARD HEIRS
No. 1 BUCK MTN. VEIN STRIPPING
COLUMBIA COUNTY
SCHUYLKILL COUNTY
EAST STRIPPING No. 3
EAST STRIPPING No. 2
RESERVATION PILLAR
BAST COLLIERY
MAP OF
BUCK MTN. WATER LEVEL WORKINGS.
SCALE - 100 FEET PER INCH.
F. J. Weiser, - Div. Engr.