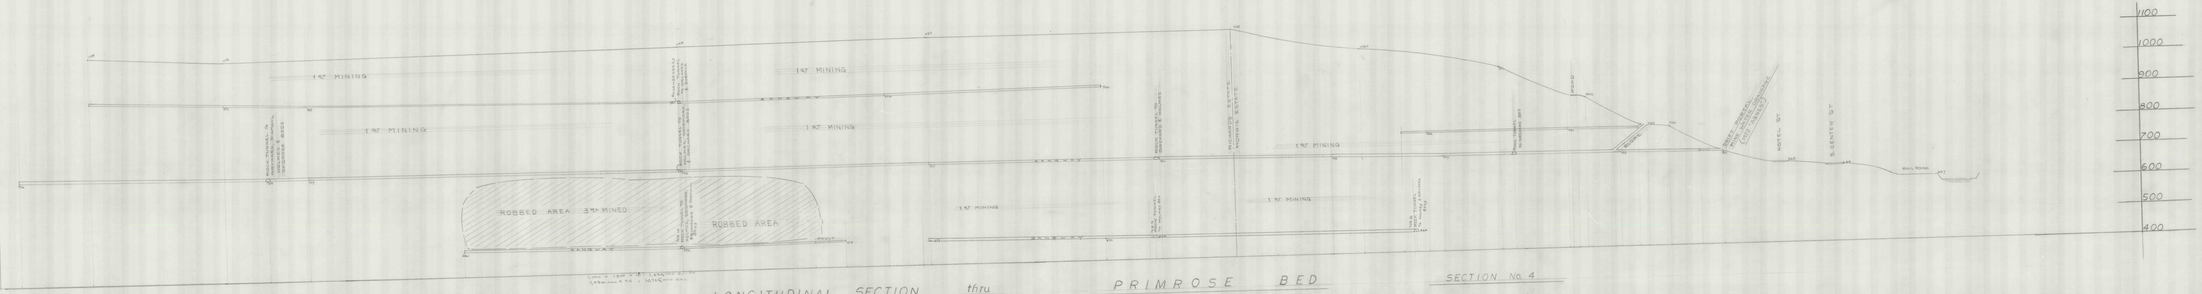

LONGITUDINAL SECTION thru PRIMROSE BED

SECTION No. 4

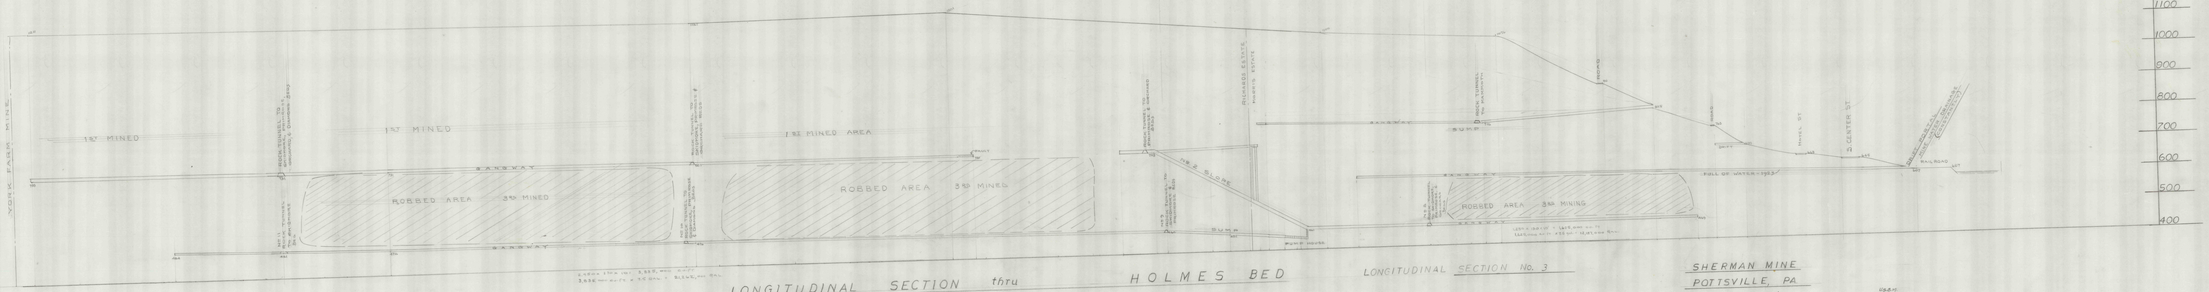

LONGITUDINAL SECTION thru HOLMES BED

LOOKING NORTH

LONGITUDINAL SECTION No. 3

SHERMAN MINE
POTTSVILLE, PA
scale 1" = 100'