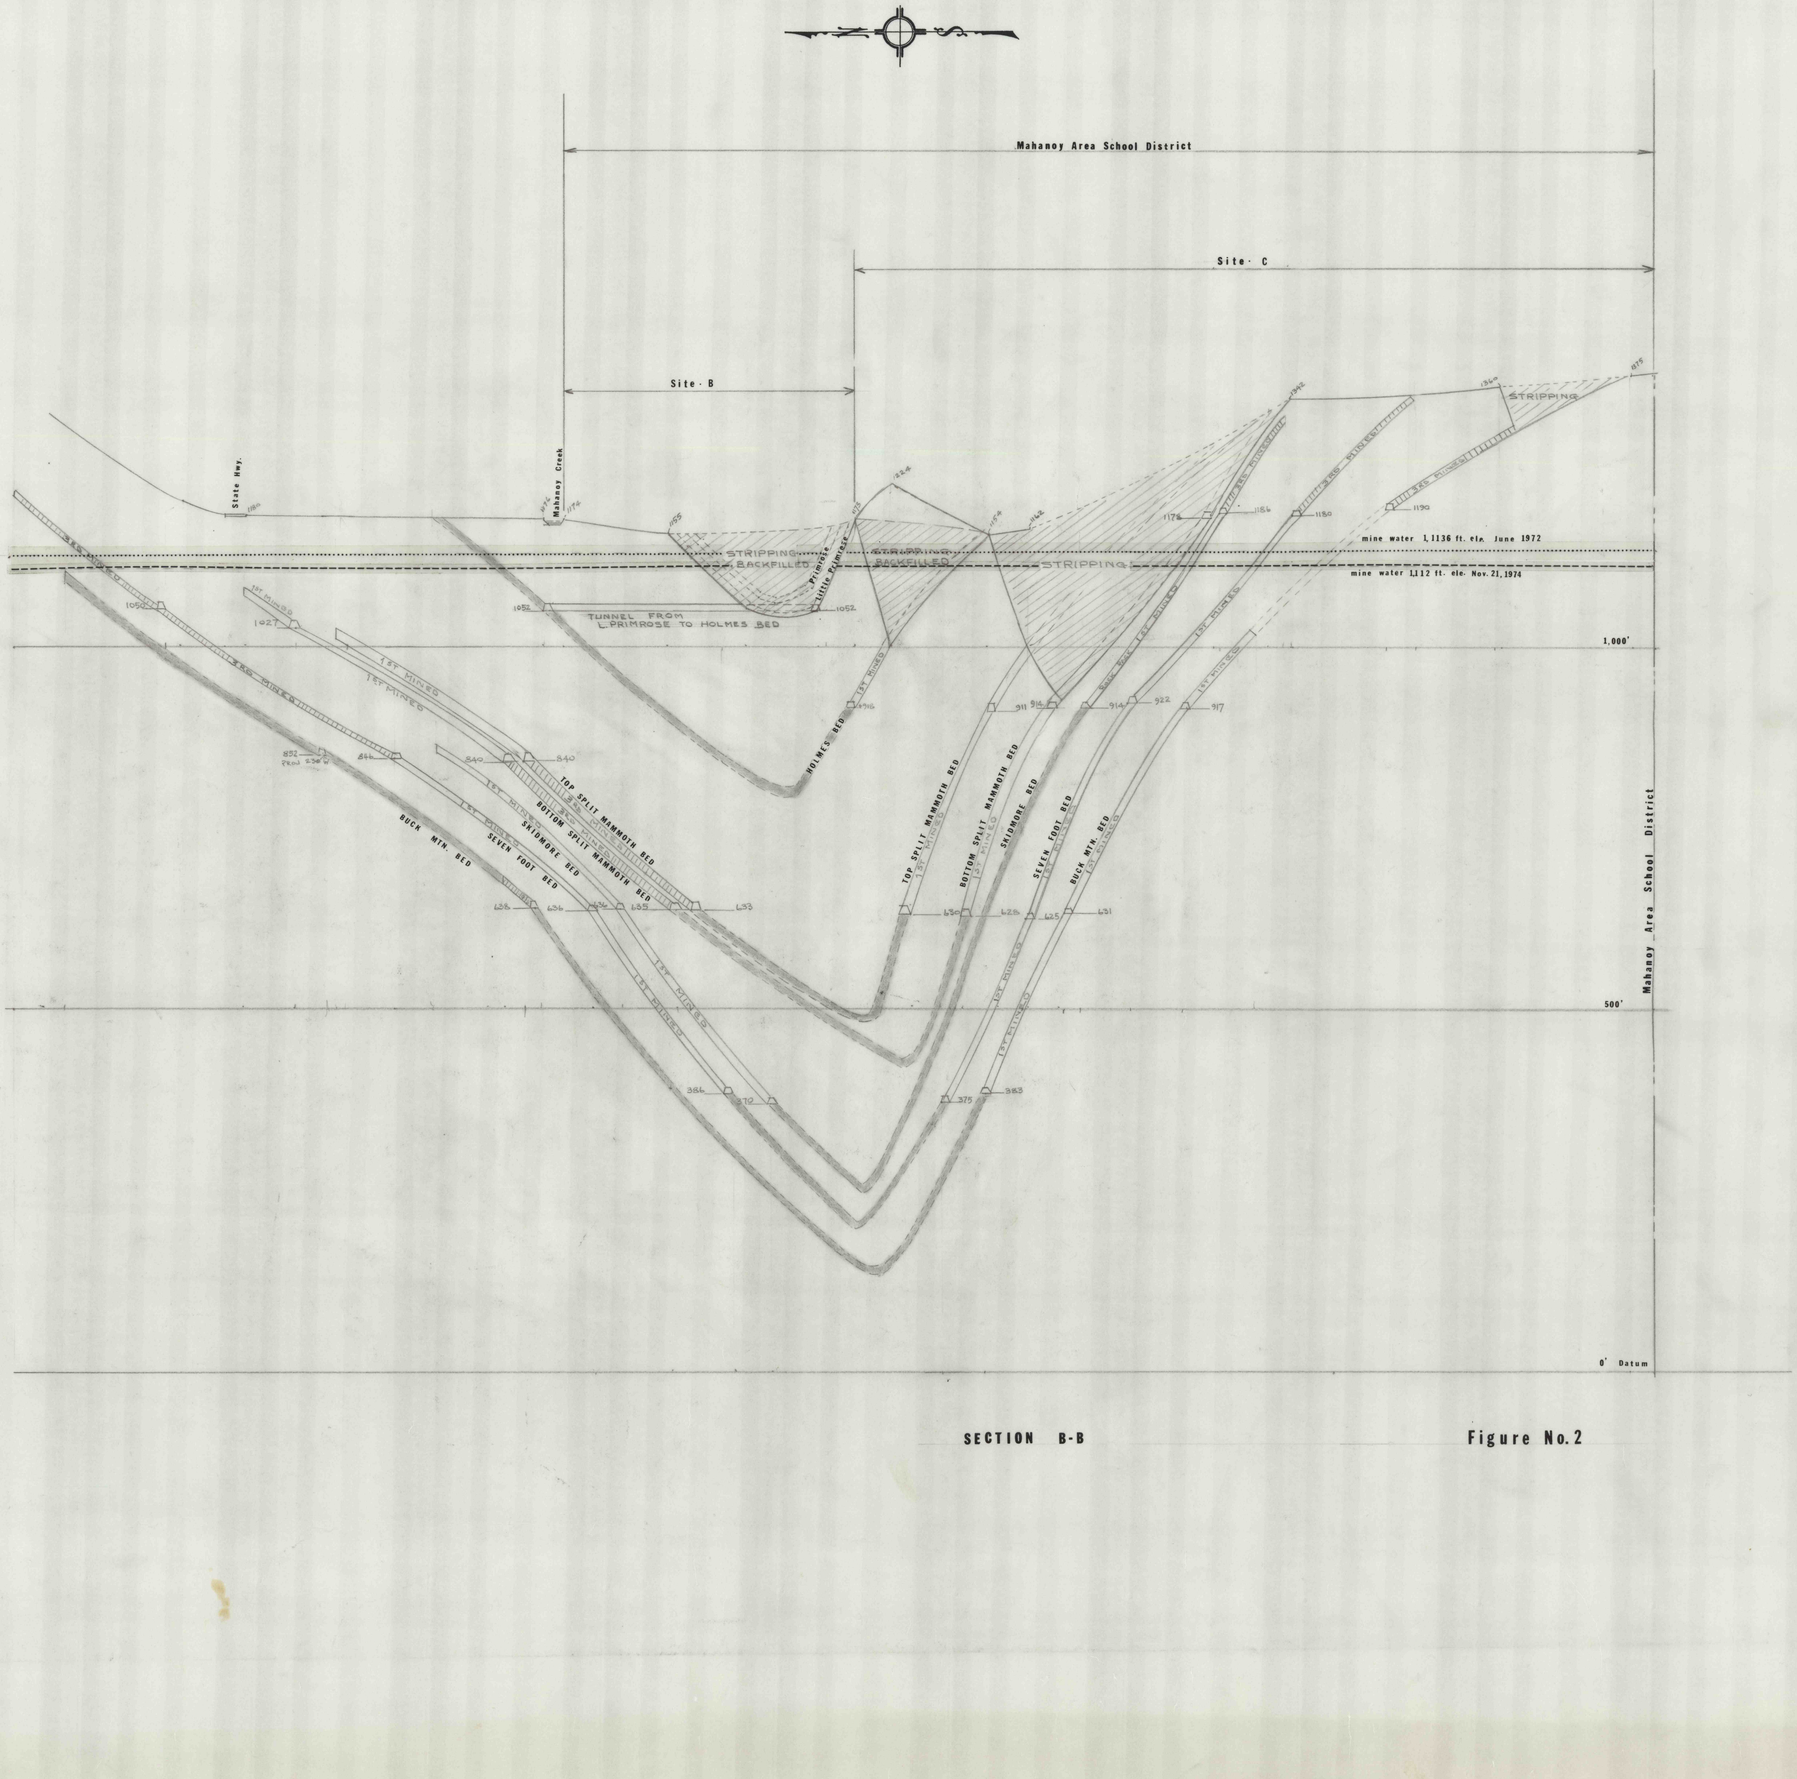

SECTION B-B

Figure No. 2