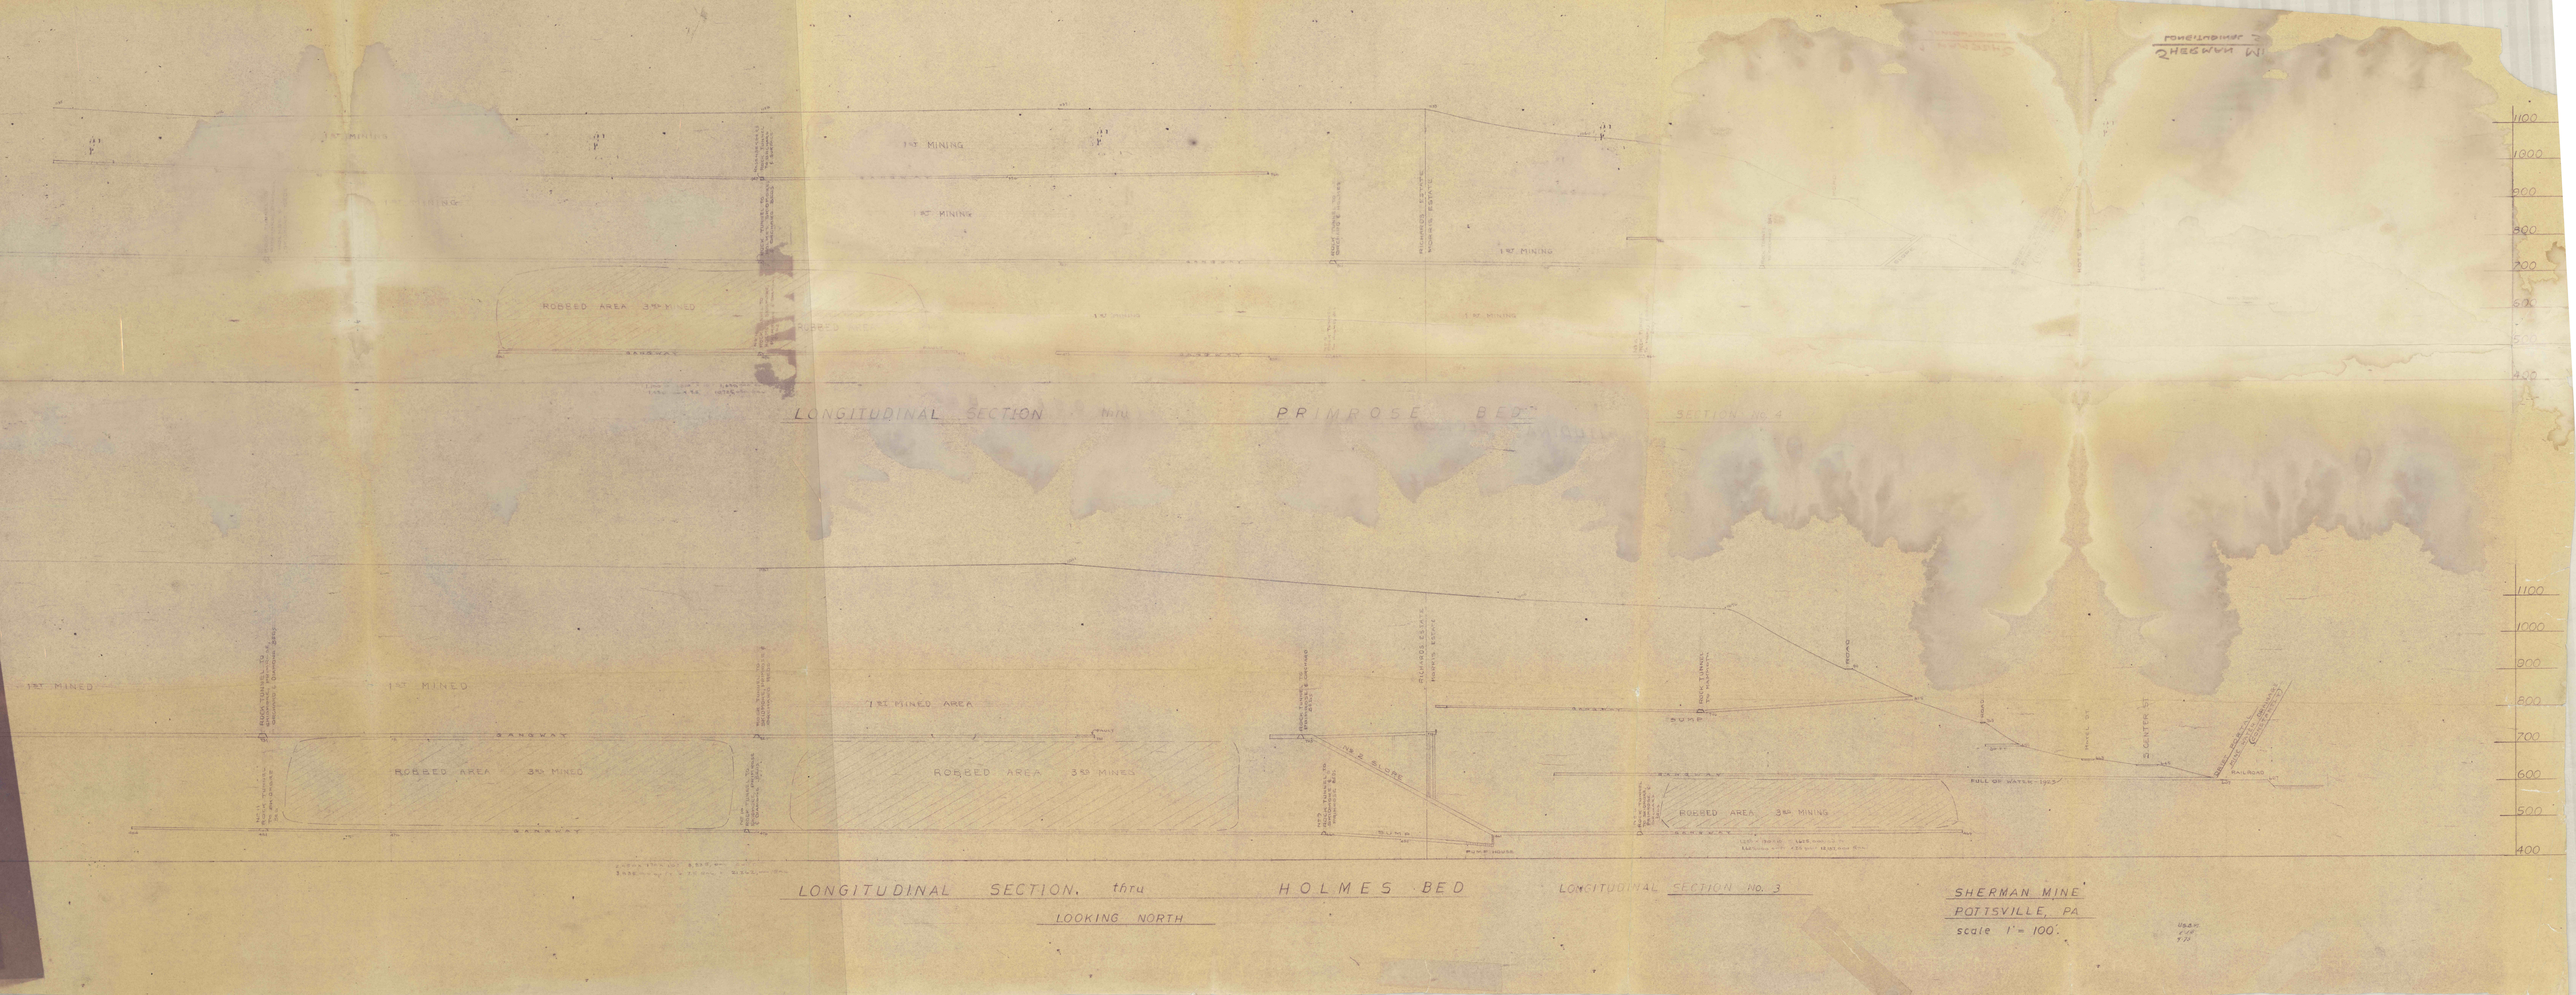
1ST MINING
1ST MINING
1ST MINING
1ST MINING
ROBBED AREA 3RD MINED
ROBBED
GANGWAY
LONGITUDINAL SECTION PRIMROSE BED
SECTION NO. 4
1ST MINED
1ST MINED
1ST MINED AREA
GANGWAY
ROBBED AREA 3RD MINED
ROBBED AREA 3RD MINES
18° SLOPE
GANGWAY
ROBBED AREA 3RD MINING
GANGWAY
FULL OF WATER 1903
CENTER ST
RAILROAD
1100
1000
900
800
700
600
500
400
LONGITUDINAL SECTION. thru HOLMES BED
LOOKING NORTH
LONGITUDINAL SECTION NO. 3
SHERMAN MINE
POTTSVILLE, PA
scale 1" = 100'.