


3544-242

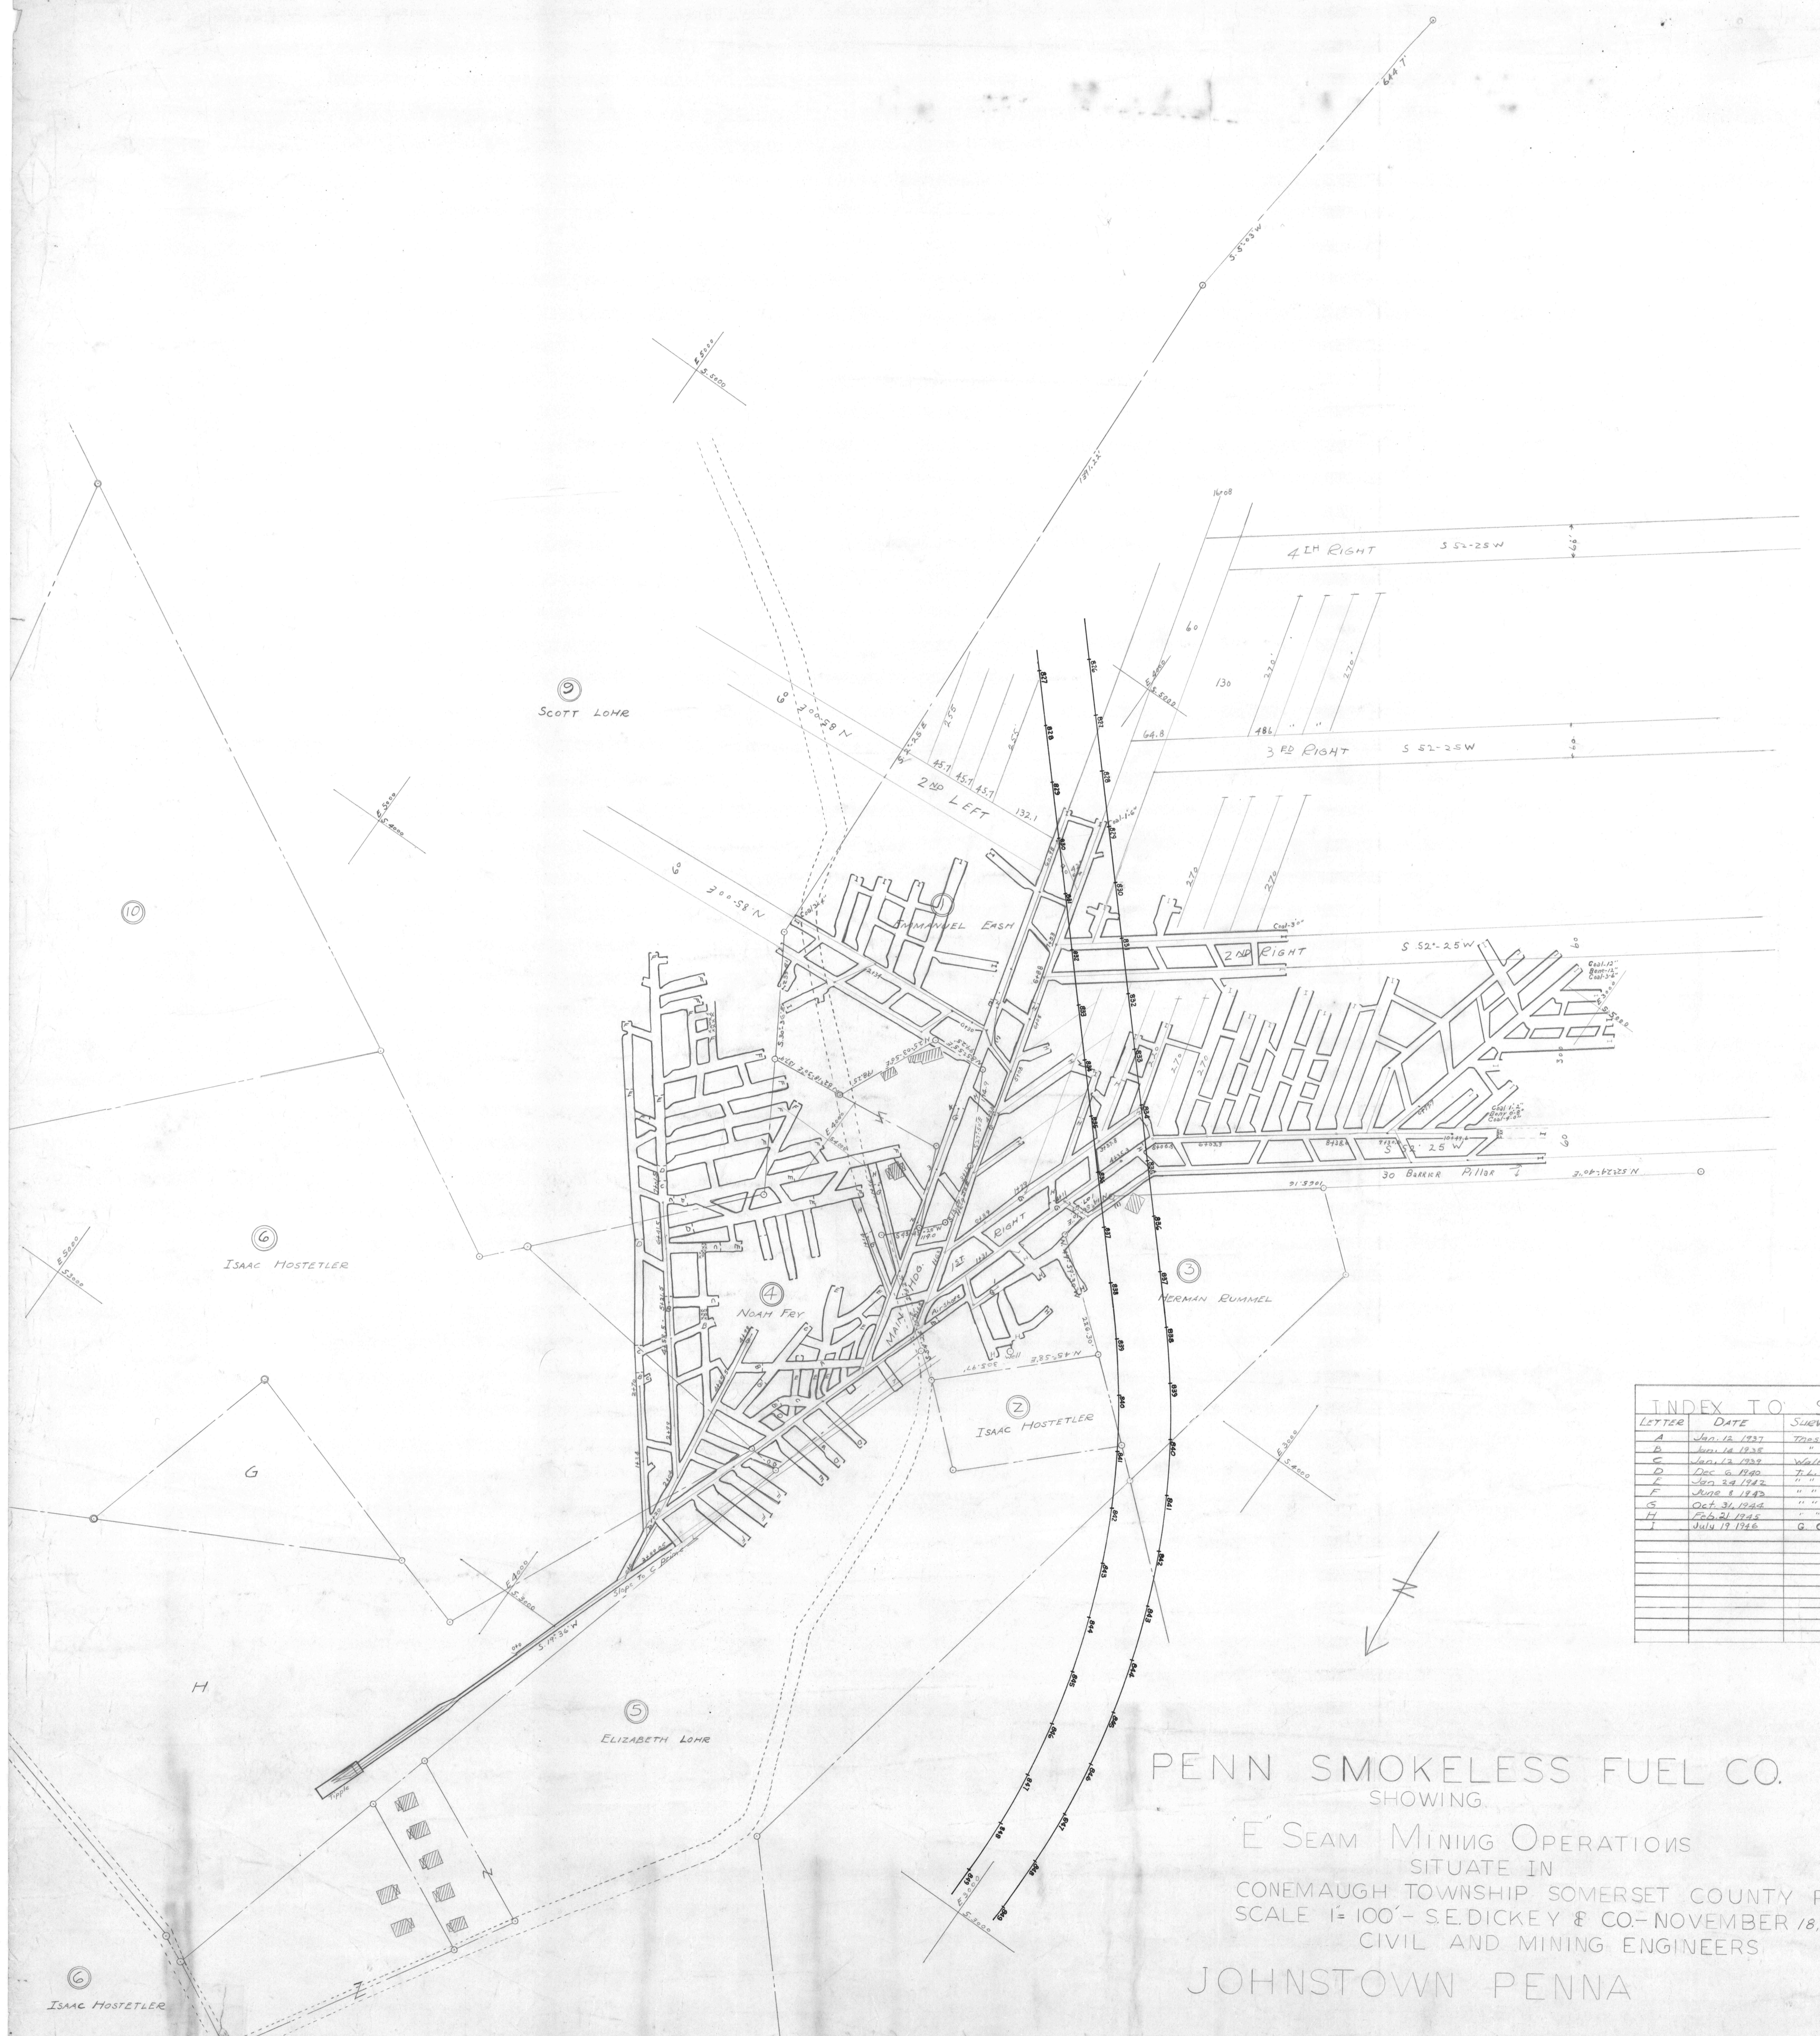

INDEX TO SURVEYS			
LETTER	DATE	SURVEYED BY	PLOTTED BY

PENN SMOKELESS FUEL CO.
 SHOWING
 E SEAM MINING OPERATIONS
 SITUATE IN
 CONEMAUGH TOWNSHIP SOMERSET COUNTY PENNA.
 SCALE 1" = 100' - S.E. DICKEY & CO. - NOVEMBER 18, 1944
 CIVIL AND MINING ENGINEERS
 JOHNSTOWN PENNA

ISAAC HOSTETLER


11-Moz