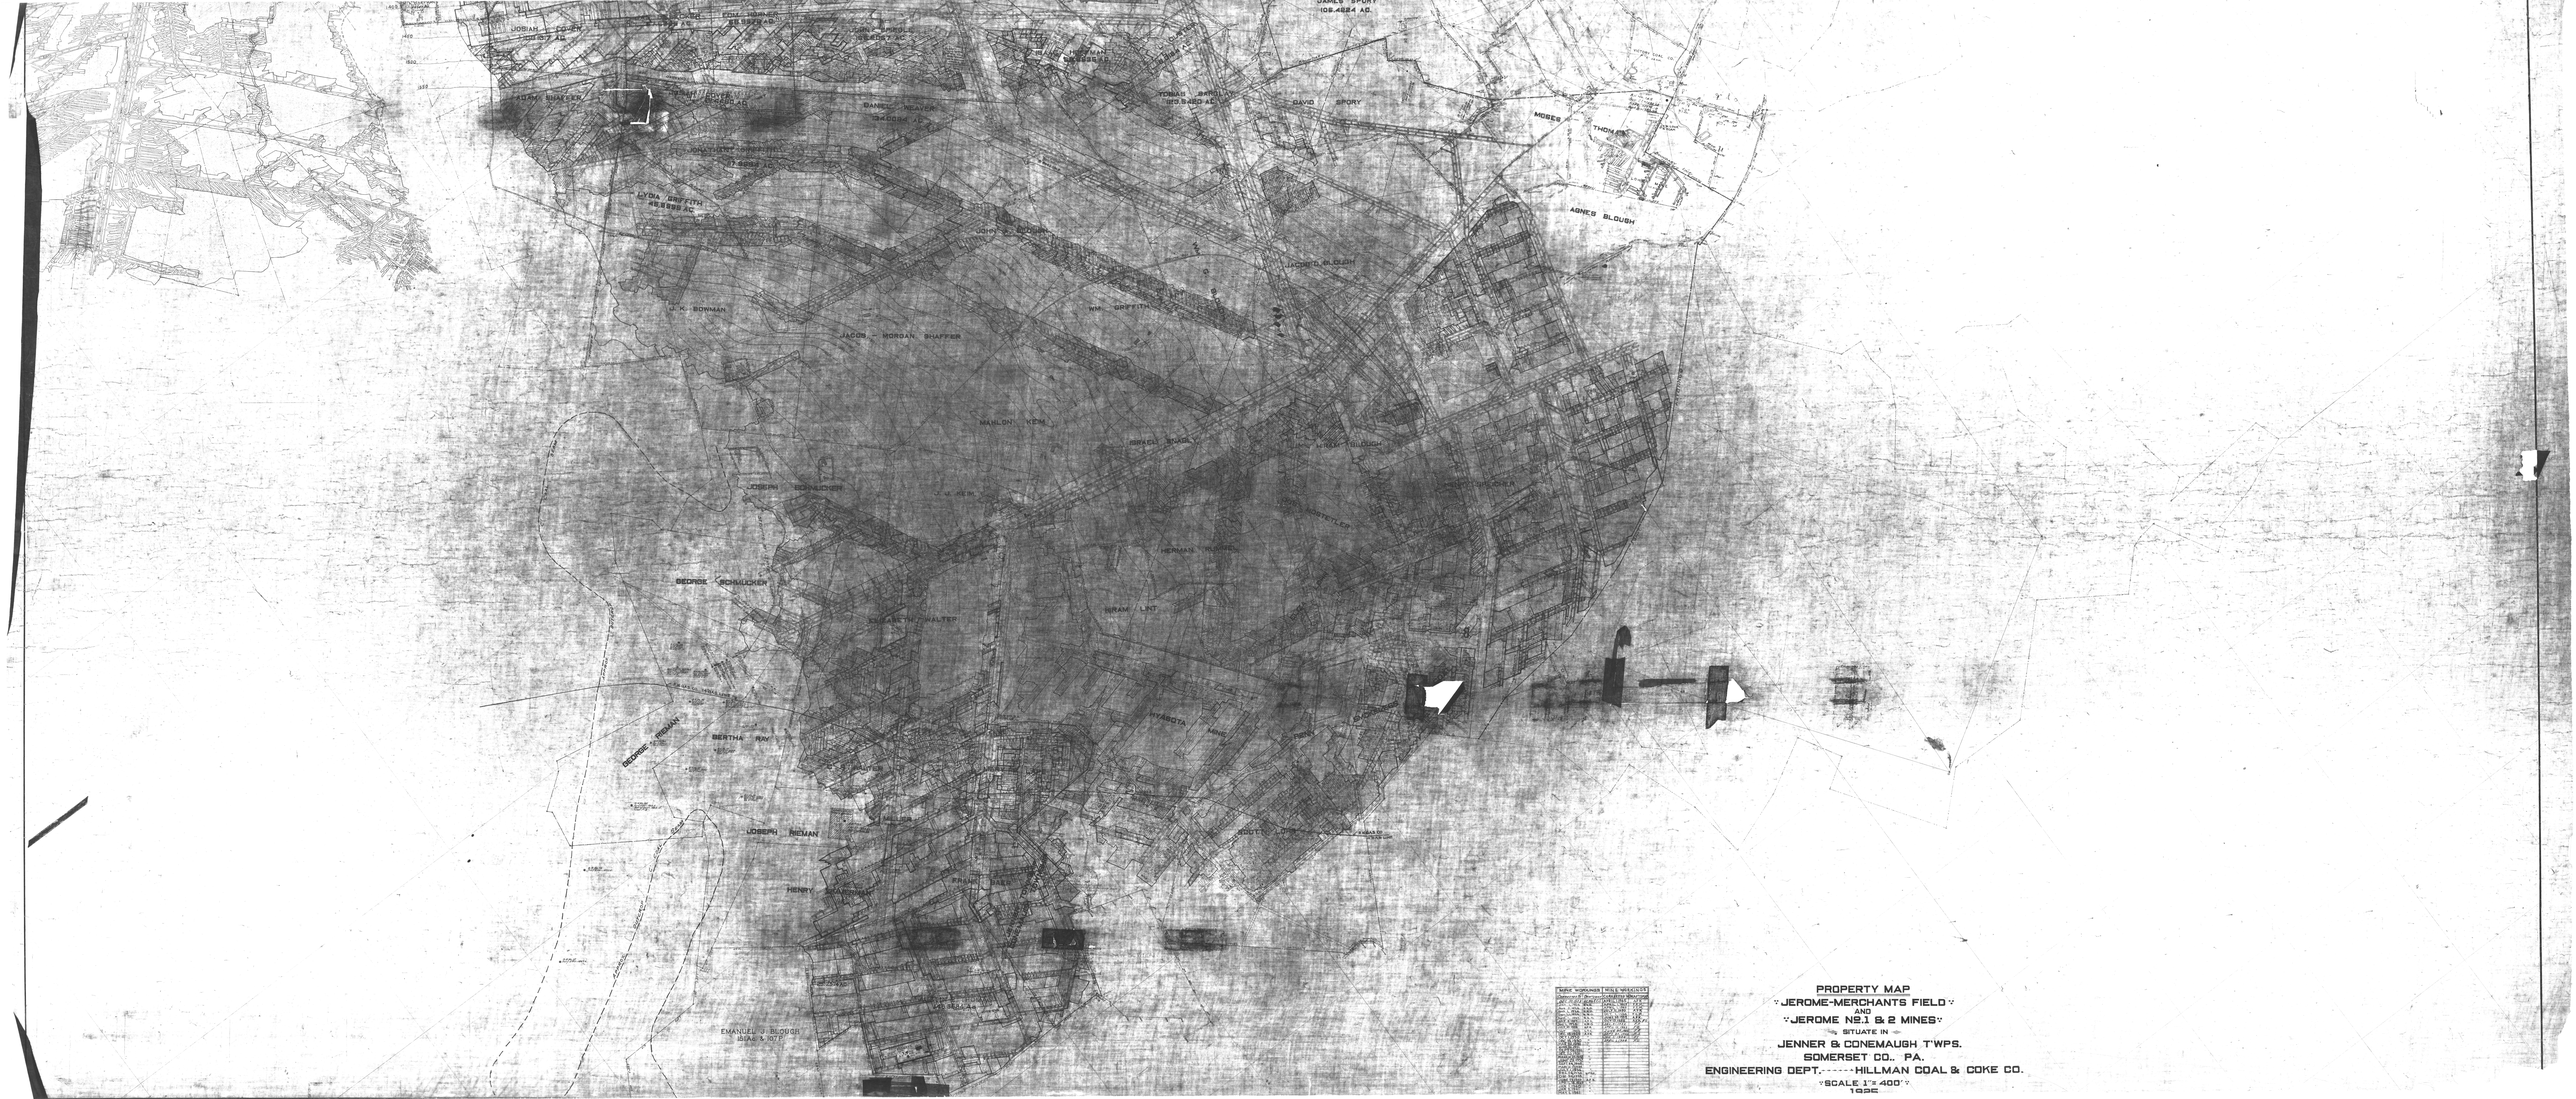

PROPERTY MAP
JEROME-MERCHANTS FIELD
AND
JEROME NO.1 & 2 MINES
SITUATE IN
JENNER & CONEMAUGH T'WPS.
SOMERSET CO., PA.
ENGINEERING DEPT.------HILLMAN COAL & COKE CO.
SCALE 1"= 400'
1925
INDEX NUMBER
TITLE NUMBER
JOSIAH SHAFFER
DANIEL WEAVER
JOHN T. BROWN
LYDIA GRIFFITH
JACOB G. BLOUGH
AGNES BLOUGH
MOSES THOMAS
DAVID SPORY
W.K. BOWMAN
JACOB - MORGAN - SHAFFER
MANLOVE KEIM
ISRAEL BOWER
JOSEPH SCHLUCKER
GEORGE SCHLUCKER
ELIZABETH WALTER
HIRAM LINT
BERTHA RAY
GEORGE REIMAN
JOSEPH REIMAN
HENRY SCHLUCKER
EMANUEL J. BLOUGH
185 A. & 107 P.