

SAME J LIGHT/TRACT
KEYSTONE MINE NO. 2
REDSTONE SEAM

SITUATED IN ELK LICK TOWNSHIP SOMERSET COUNTY PENNSYLVANIA.

IN. 100 FEET


SEPTEMBER 1916

J. Hobbs & Co.

Civil and Mining Engineers.

NOTE:-
All levels are based on mean tide datum at Sandy Hook.
Survey of Jan-1916 established from survey and map of
Keystone Coal Co

LEGEND		
Date	Letter	Surveyed by

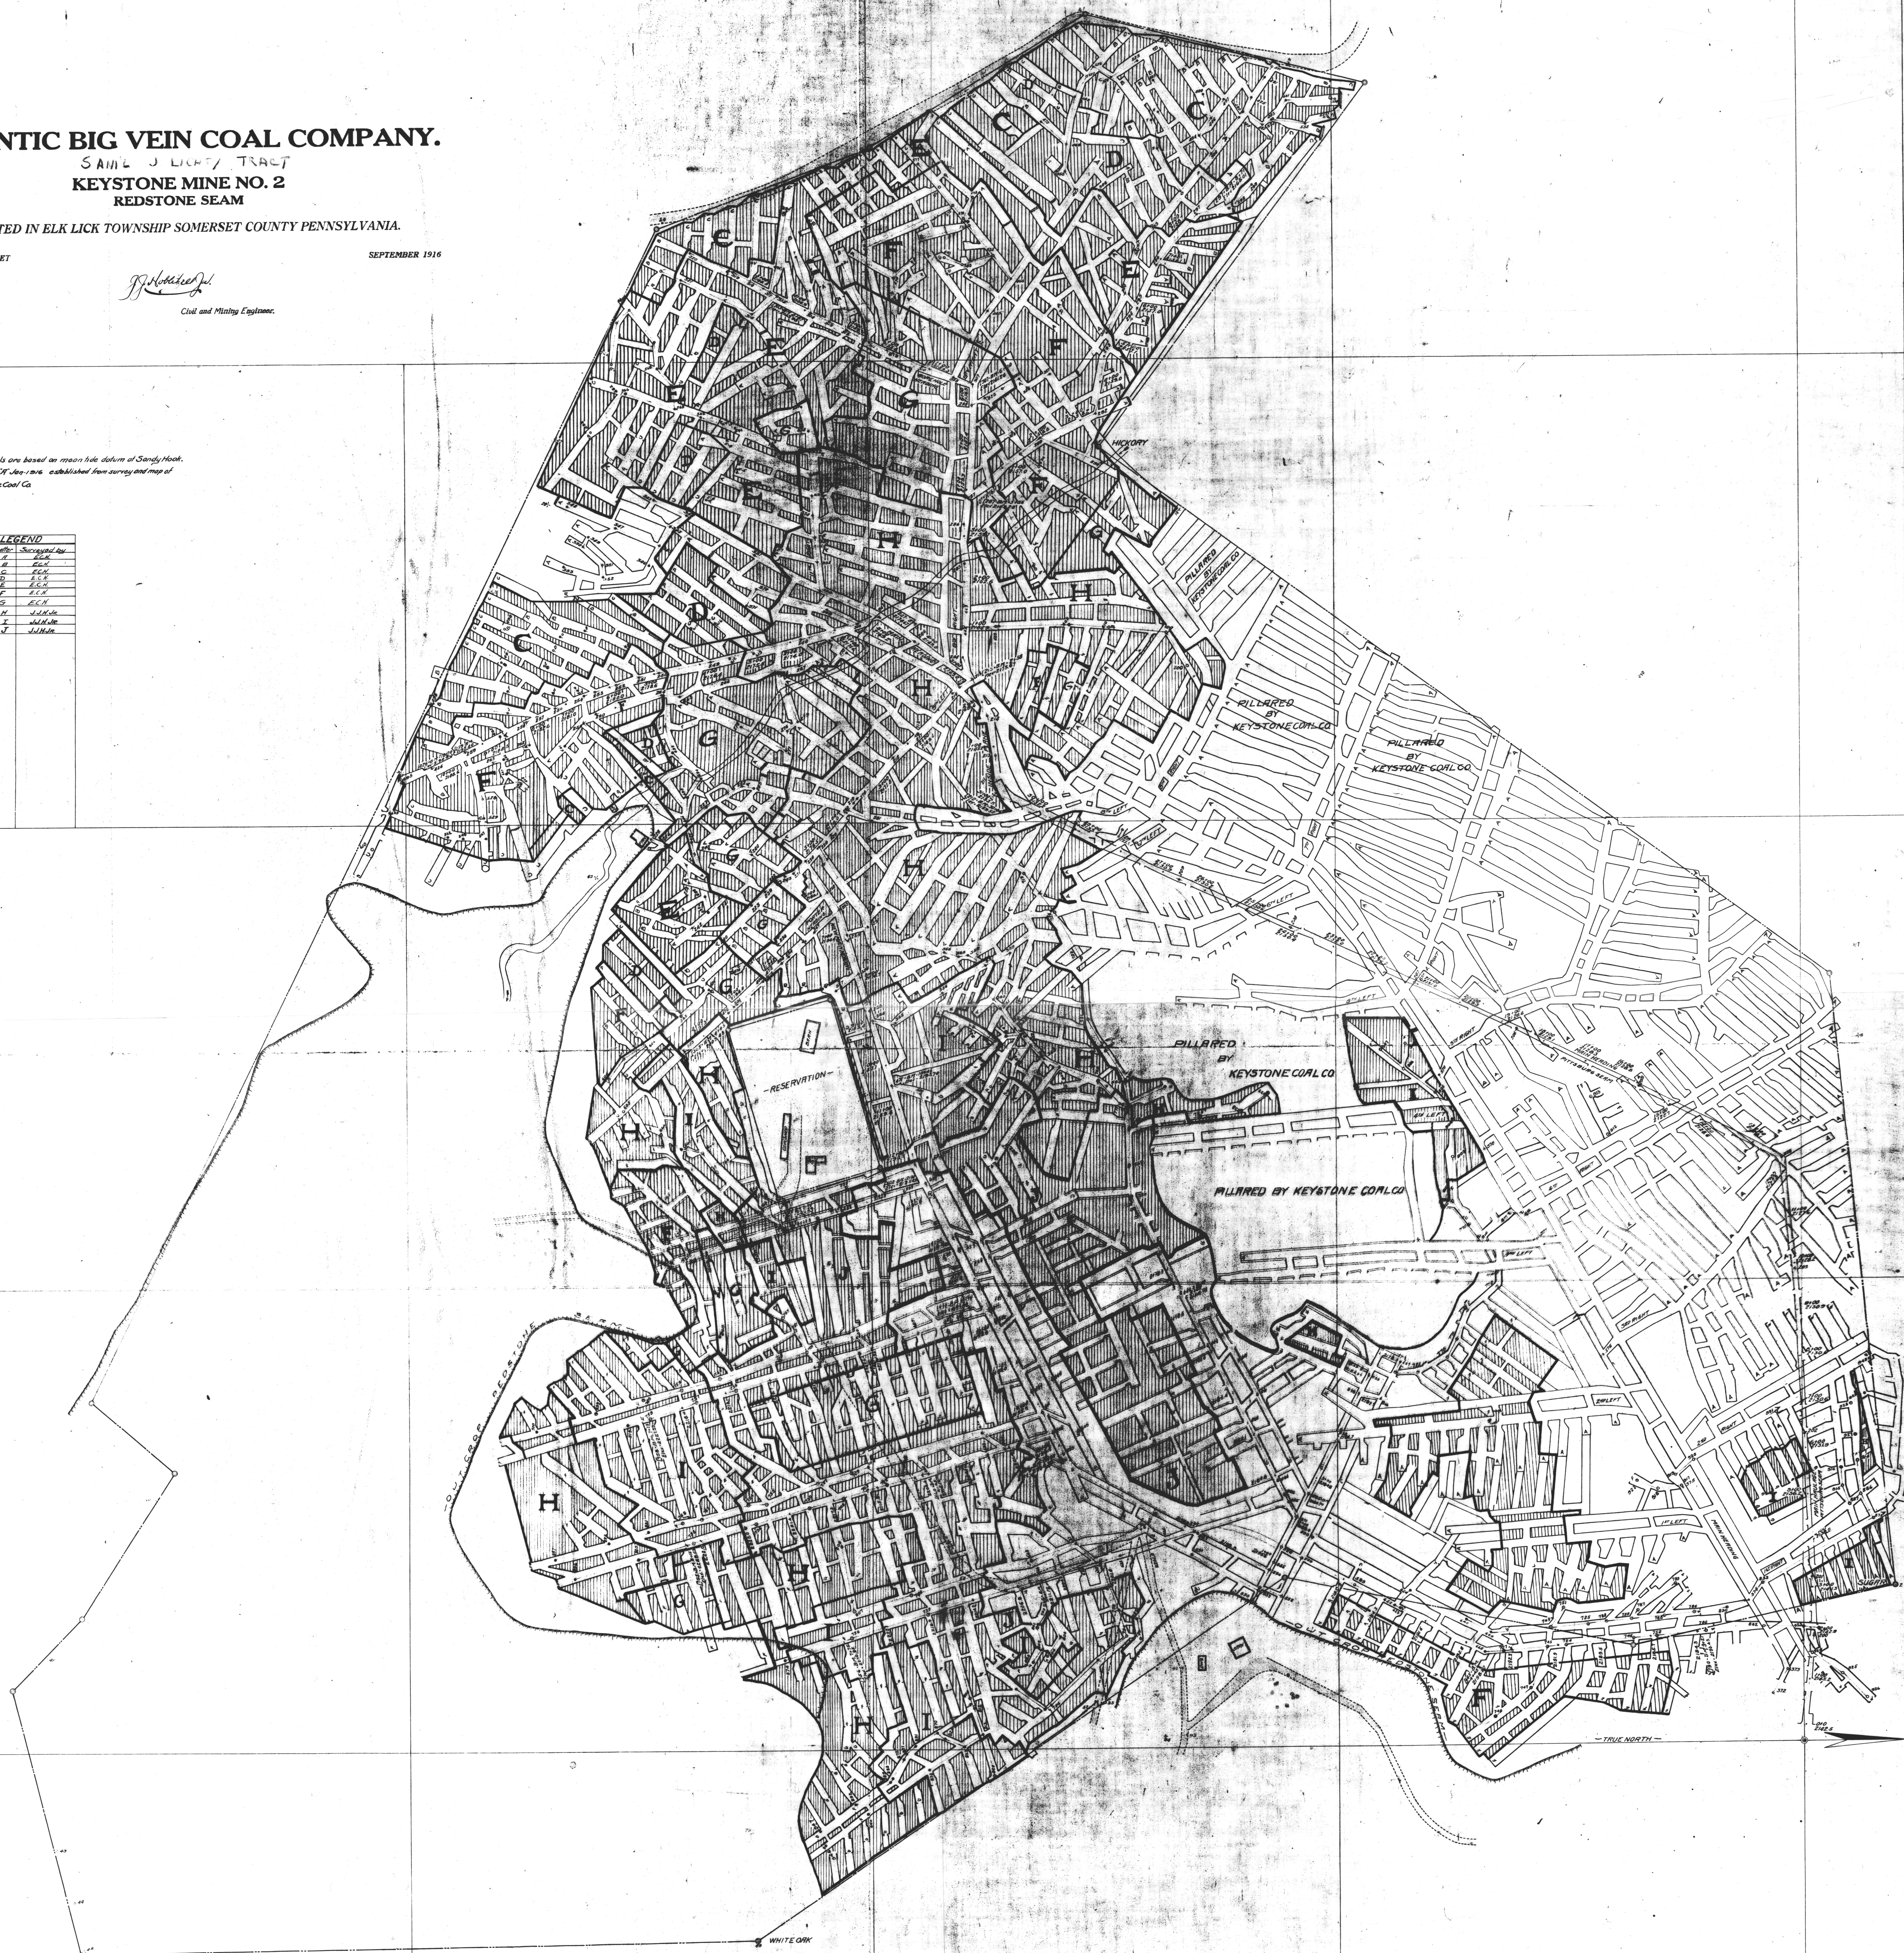

2402 73342