


39% reduction

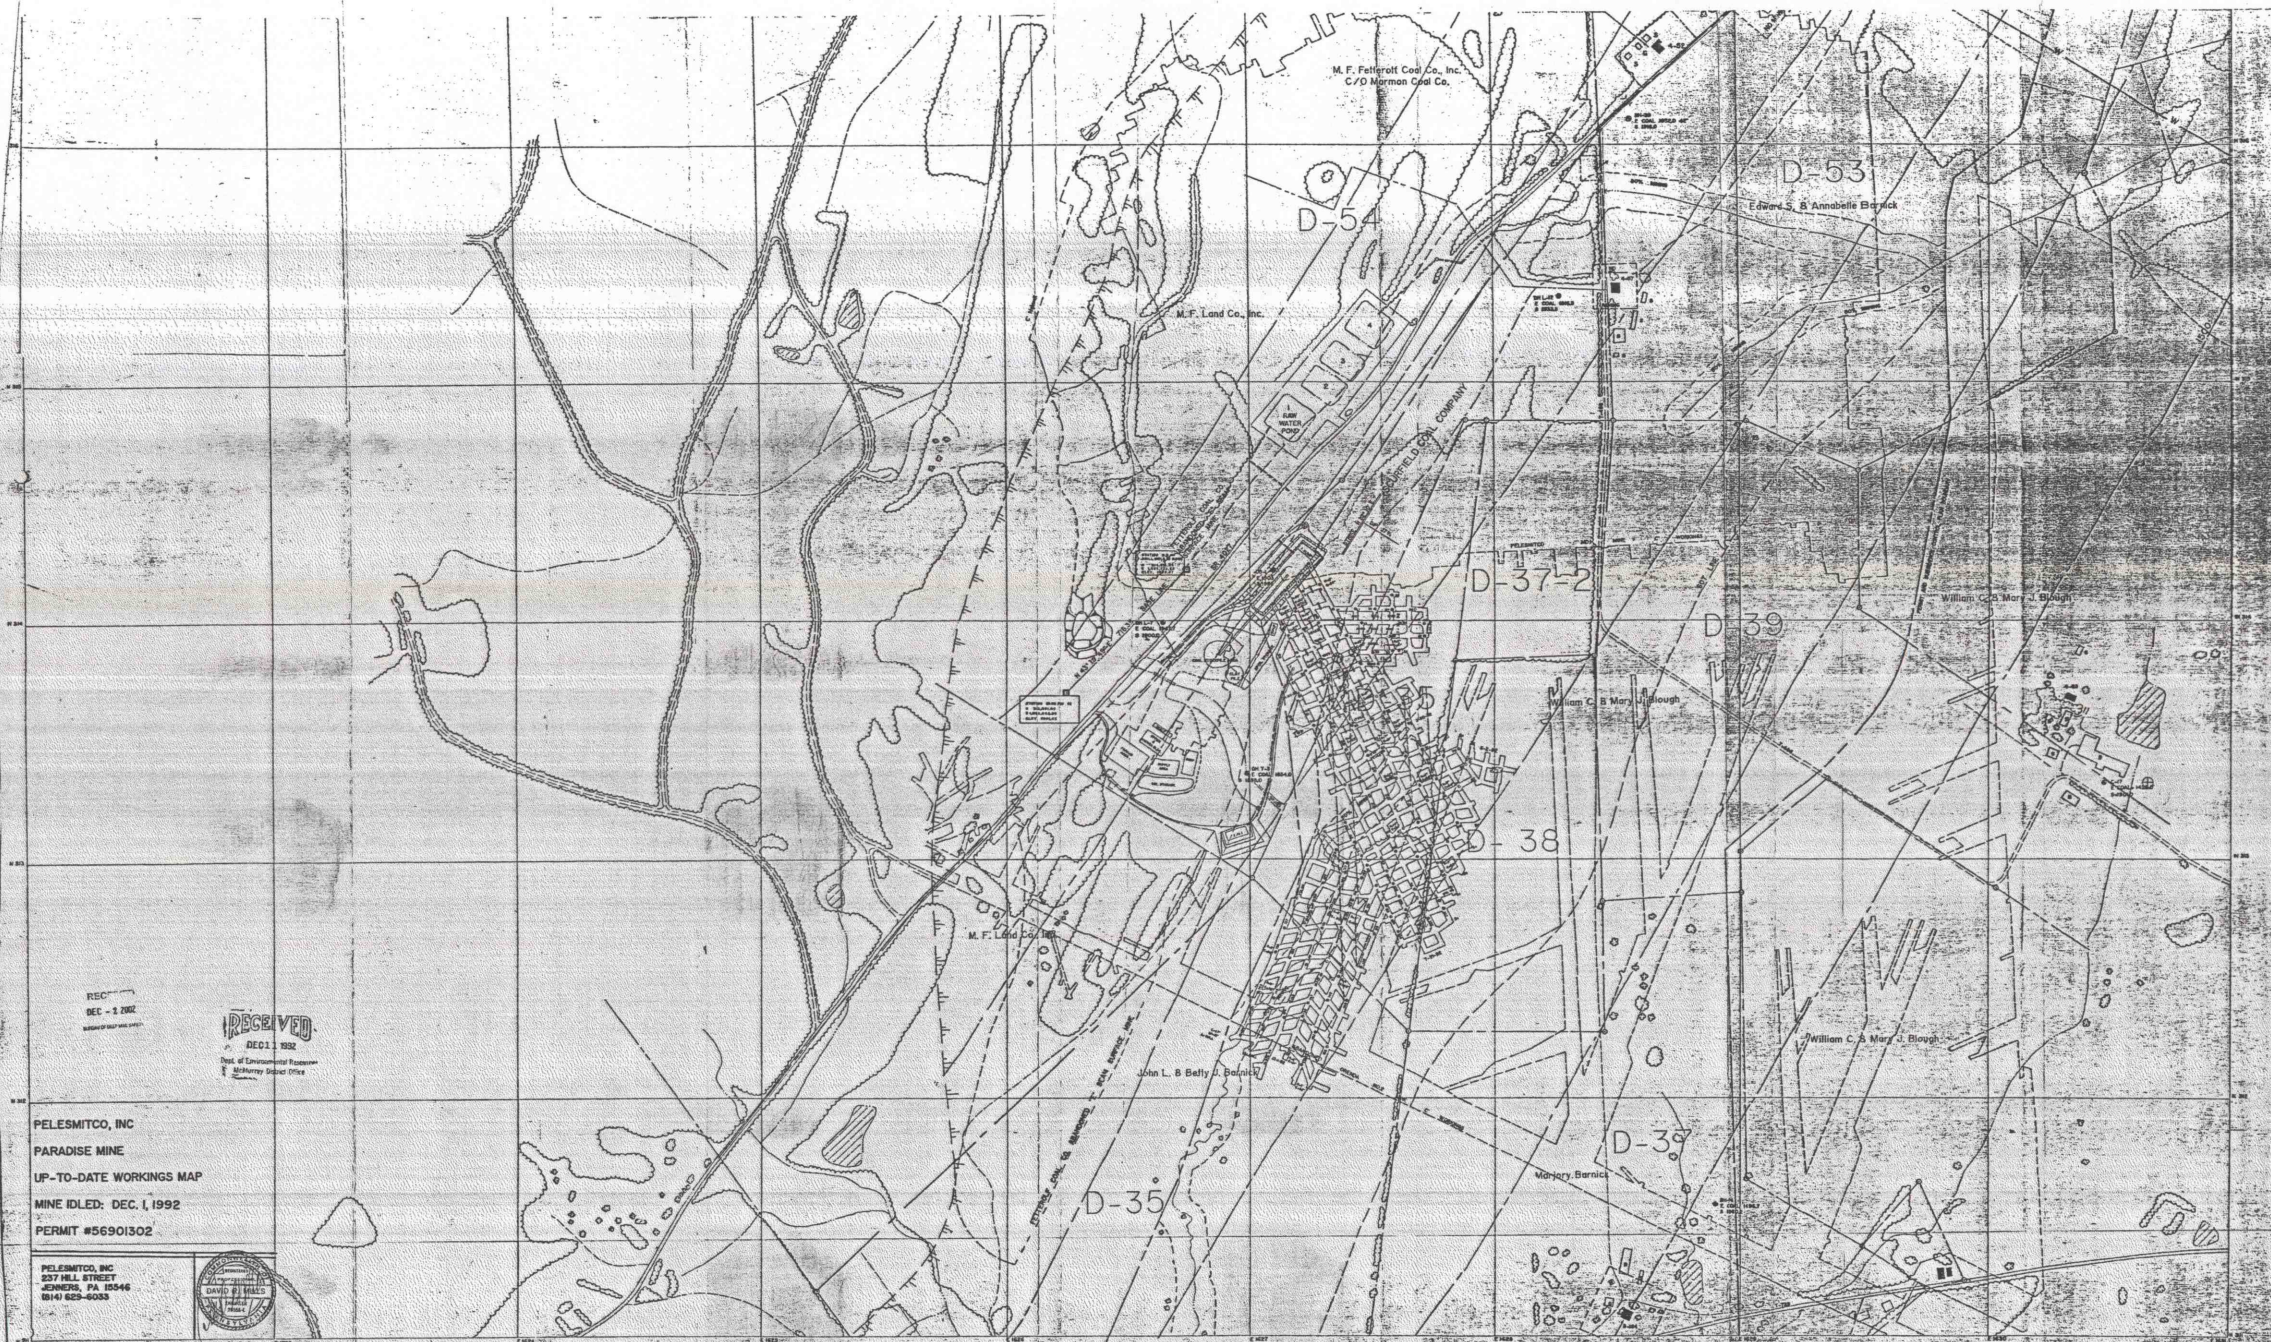

REC-1
DEC-1 1992


RECEIVED
DEC 1 1992
Dept. of Environmental Protection
McHurry District Office

PELESMITCO, INC
PARADISE MINE
UP-TO-DATE WORKINGS MAP
MINE IDLED: DEC. 1, 1992
PERMIT #56901302

PELESMITCO, INC
(814) 628-6033

P4
4286
JENNER TOWNSHIP & JENNERSTOWN BORO
SOMERSET COUNTY
PENNSYLVANIA

NOTE: THIS PROPERTY IS OWNED BY M.F. LAND CO., INC.

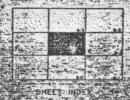

PLANIMETRIC SERIES
SHEET NO. A-2

