


X.4 - reductivi

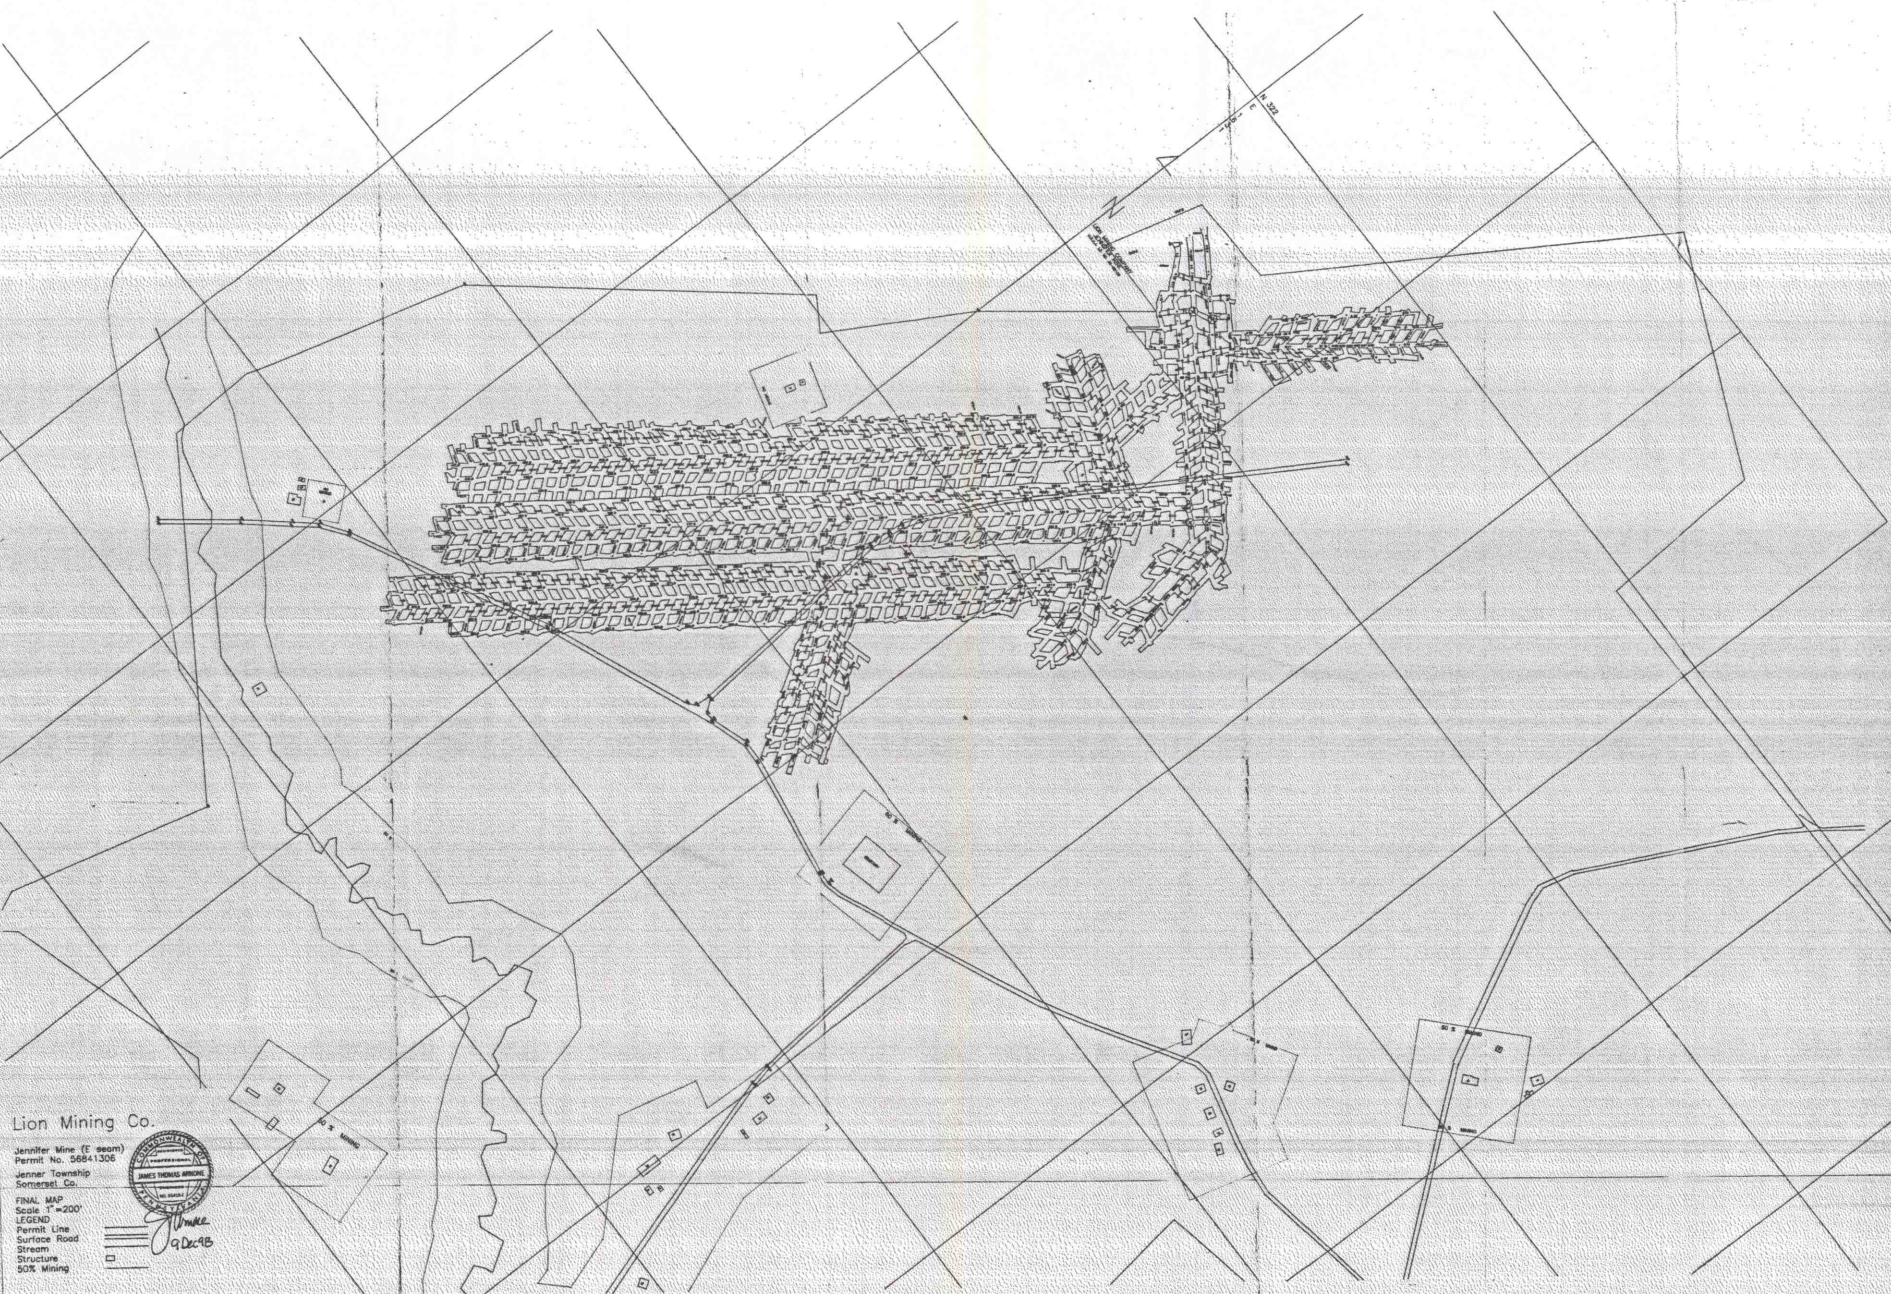

Lion Mining Co.

Jenner Township



FINAL MAP
Scale 1"=200'
LEGEND
Permit Line
Surface Road
Stream
Structure

J. D. Miller
9 Dec 98

2000'