


Baswell Reservoir

X.4 - radioactive

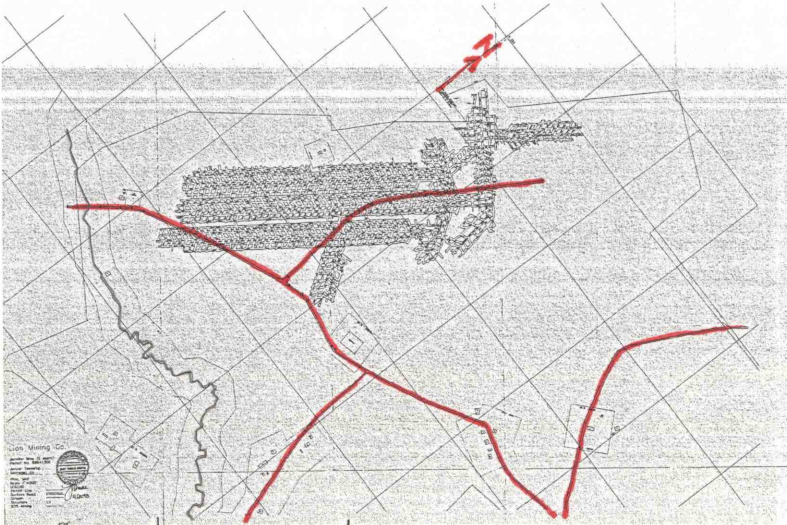

UF, plotted

Jennifer mine

Baswell 7 1/2

2 mi N of Jennifer town  
Lion Mining Co.