


REC-2  
DEC - 2 2002  
BUREAU OF DEPT. OF ENVIRONMENTAL RESOURCES

**RECEIVED**  
DEC 11 1992  
Dept. of Environmental Resources  
McMurry District Office

PELESMITCO, INC  
PARADISE MINE  
UP-TO-DATE WORKINGS MAP  
MINE IDLED: DEC. 1, 1992  
PERMIT #56901302

PELESMITCO, INC  
237 HILL STREET  
JENNERS, PA 15546  
(614) 629-6033


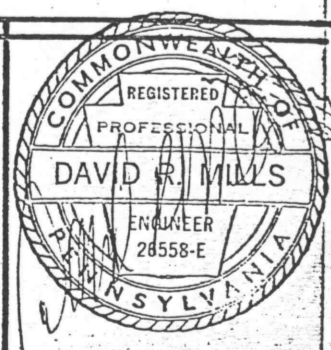


**P4**  
4286  
JENNER TOWNSHIP & JENNERSTOWN BORO  
SOMERSET COUNTY  
PENNSYLVANIA

John Doe SURFACE OWNERSHIP  
JOHN DOE SUBSURFACE OWNERSHIP  
NOTE: D-#s REPRESENT SUBSURFACE OWNERSHIP BY M.F. LAND CO., INC.

**LEGEND**

UNPAVED ROAD	RAILROAD	BENCH MARK
PAVED ROAD	LAKE, POND	TRANSFER STATION

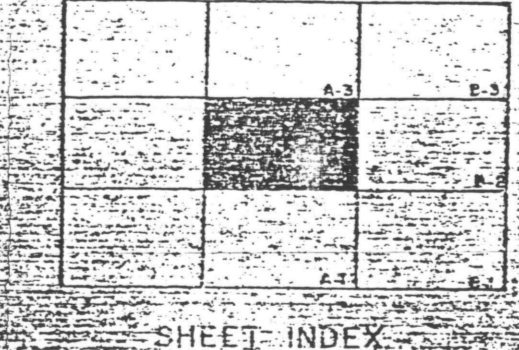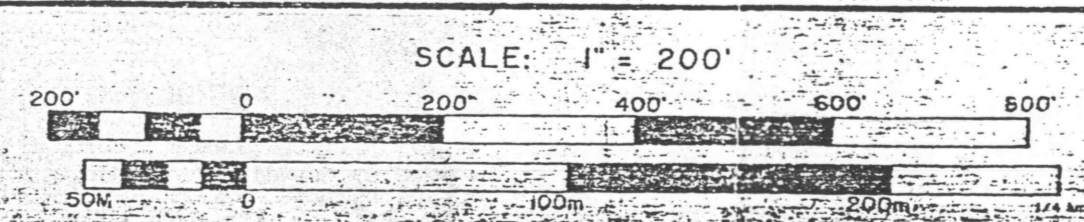

PLANIMETRIC SERIES  
SHEET NO. A-2

2000'