


Closed loop check surveys were run from the control points outside to Apache mains spod #299, Crow mains spod #2198, and Shawnee mains spod #2804. All check surveys exceed accuracy of 1 in 5,000.

MAP LEGEND

- Permit Boundary
- Subsidence Control Plan Boundary
- 25' Angle of Draw
- Property Lines
- Roads
- Streams
- Dwelling
- Contours 1990
- Drill Holes
- Utility Lines
- Deep Mine Entry
- Deep Mine Boundary
- Previously Surface Mined Area
- Gas Well

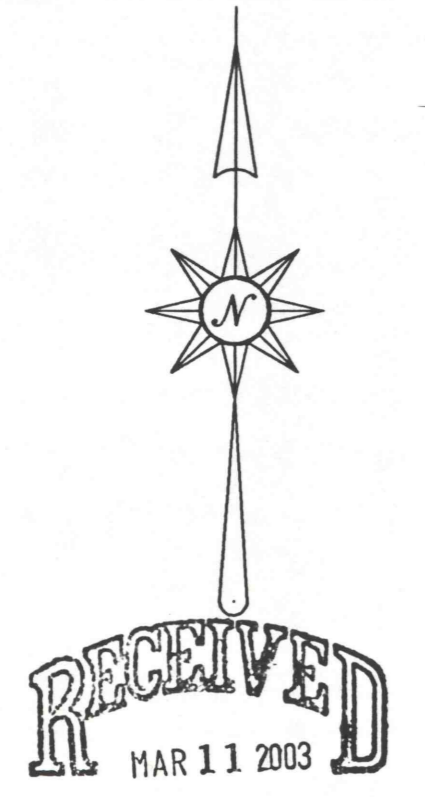

G M & S COAL CORP.
GERONIMO MINE
LOWER KITTANNING SEAM
M.A.P. NO. 56971301
MINING PERIOD: 2-15-03 TO 8-15-03
SURVEY DATE: 2-13-03
SCALE: 1"=200'
PROJECTION #12 SHEET #5
JENNER TOWNSHIP
SOMERSET COUNTY, PA

SUBSIDENCE LEGEND

FIRST MINING AREA	[Symbol]
DWELLINGS	[Symbol]
OTHER BUILDINGS	[Symbol]
CONTEMPLATED MINING	[Symbol]
PREVIOUS SIX MONTH'S MINING	[Symbol]
PERMIT LINE	[Symbol]
SUBSIDENCE CONTROL PLAN BOUNDARY	[Symbol]
PROPERTY LINE	[Symbol]

G M & S COAL, CORP.
P.O. BOX 233
JENNERSTOWN, PA 15547
(814) 629-5661

Dept. of Environmental Protection
 Montgomery County Office
 Maximum entry width will be 20'

There will be no retreat mining below the 2020 elevation in the UK mine above

Property identification number [Symbol]

Structure identification
 HOUSE H
 SHED S
 GARAGE G
 BARN B
 TRAILER T

Well [Symbol]

Spring [Symbol]

Underground Telephone Line U-T
 Telephone/Electric Line T-E
 Water Line W
 Natural Gas Line C

3-10-03

