







Lion Mining Co.

Jennifer Mine (E seam)
Permit No. 56841306
Jenner Township
Somerset Co.

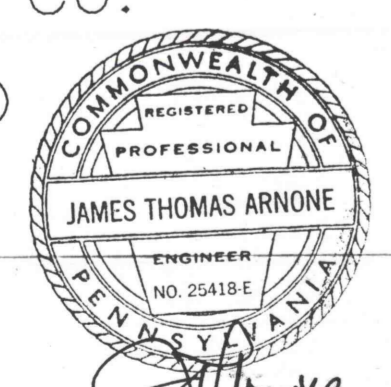

FINAL MAP
Scale 1" = 200'
LEGEND
Permit Line
Surface Road
Stream
Structure
50% Mining

J. Arnone
9 Dec 98

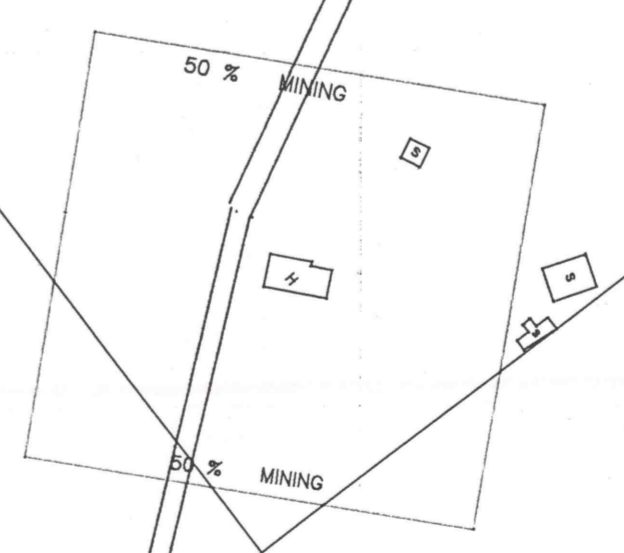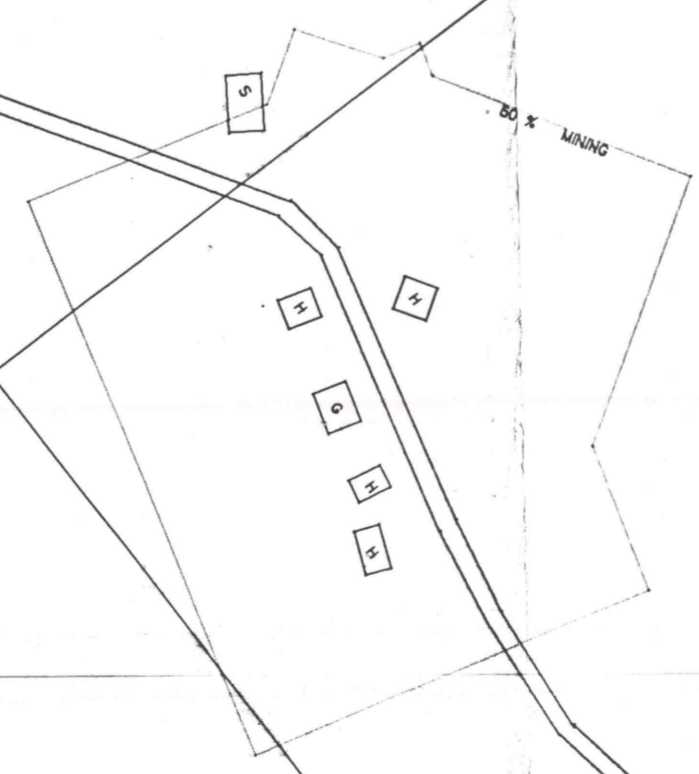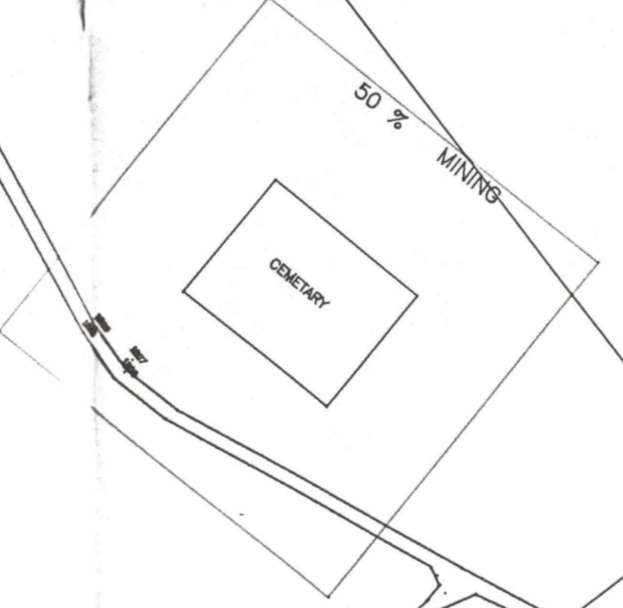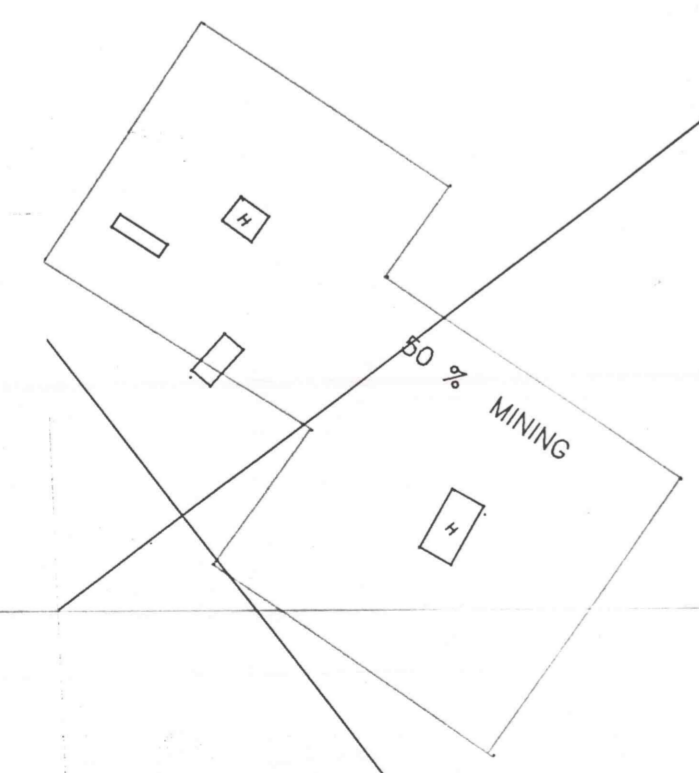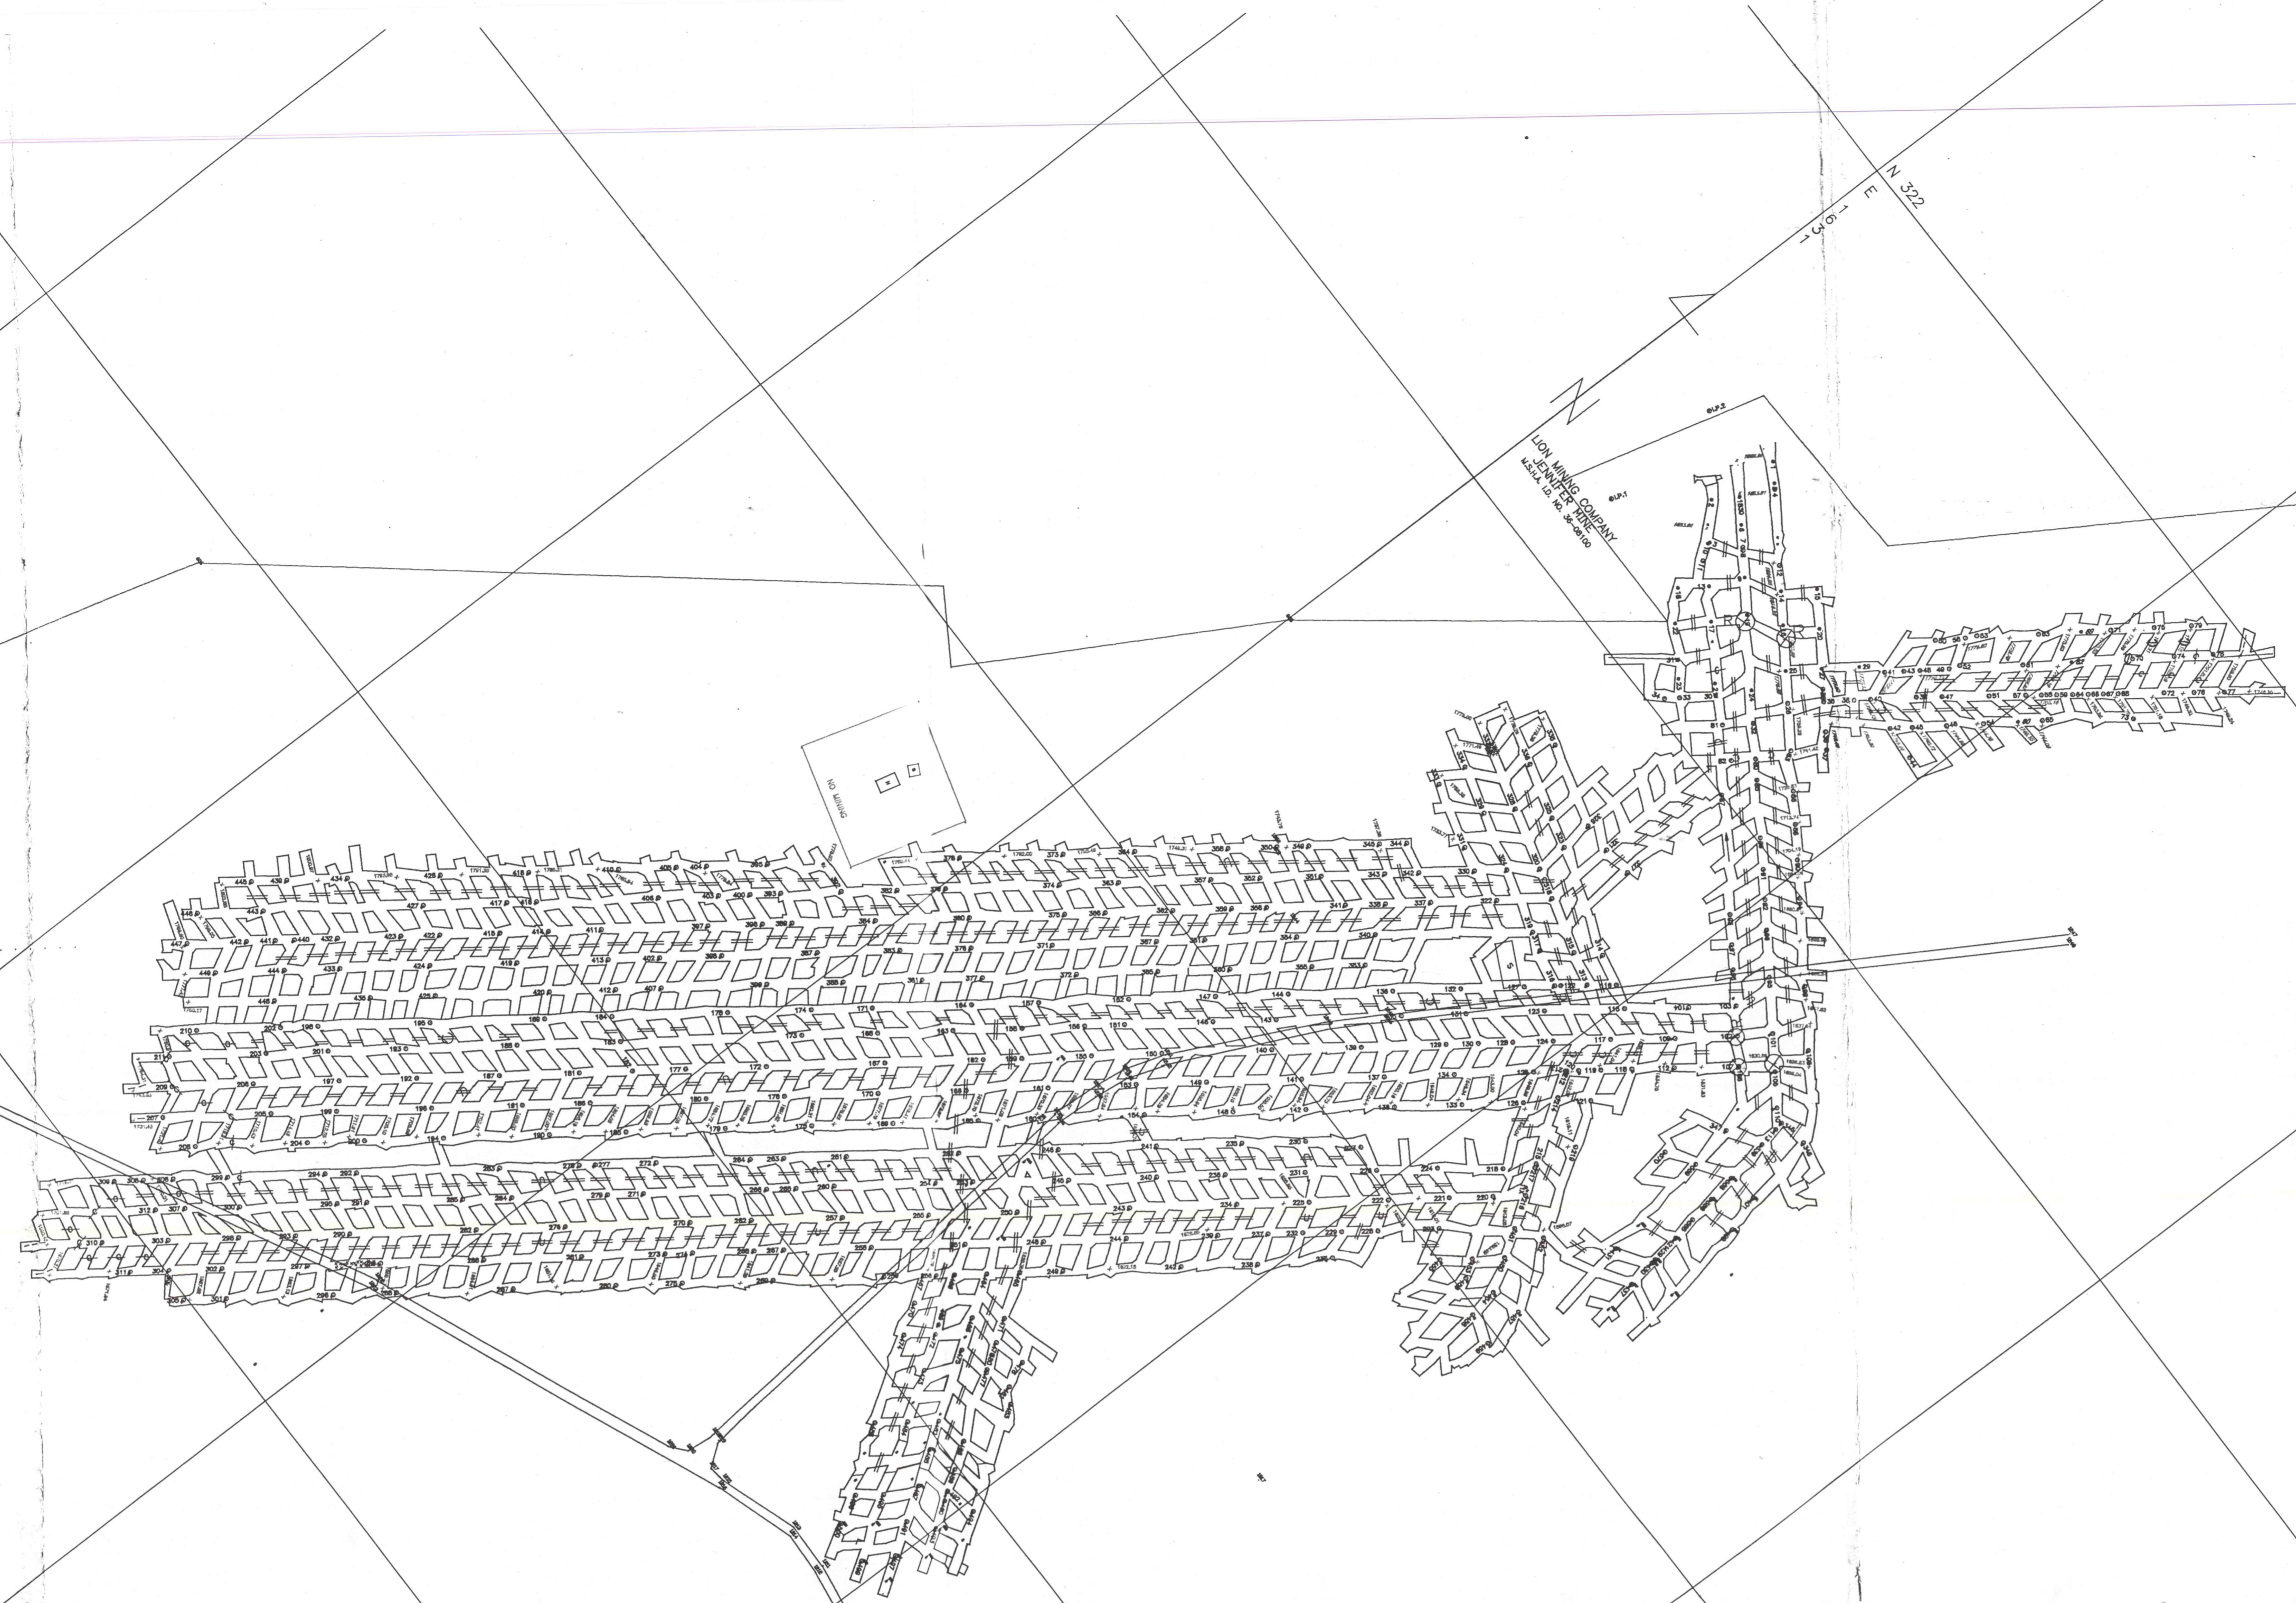

27"x41"

