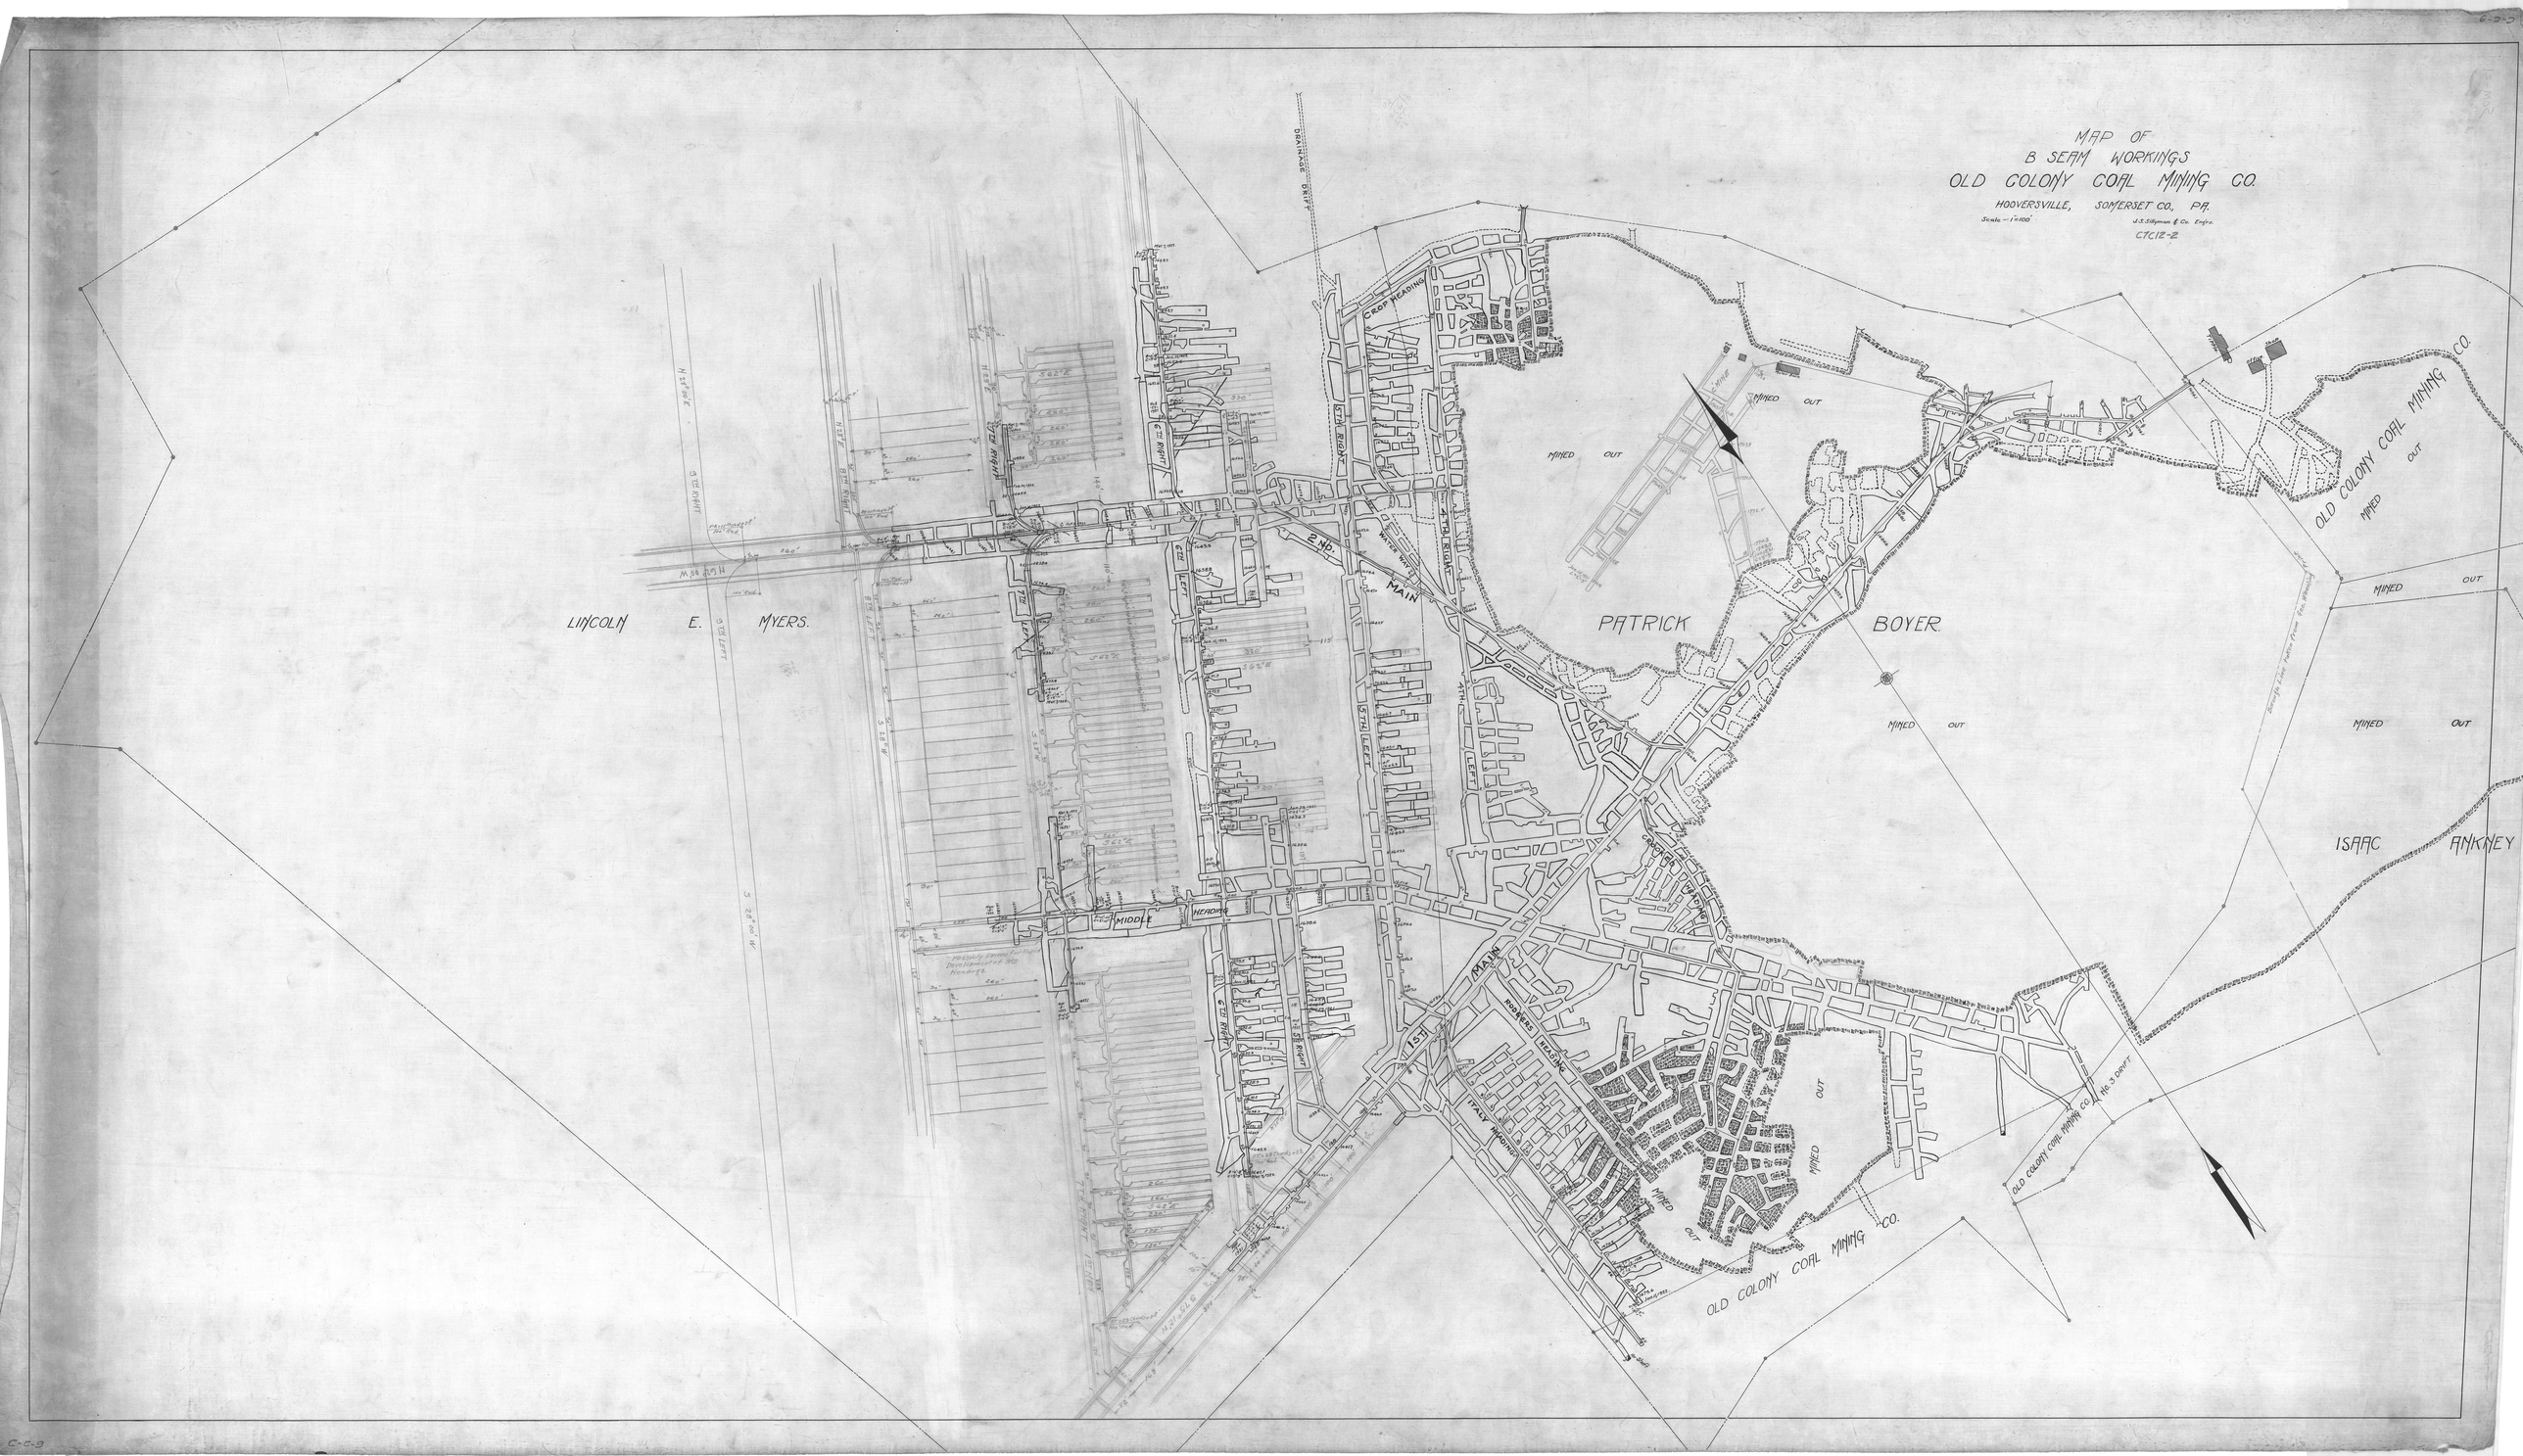
MAP OF
B SEAM WORKINGS
OLD COLONY COAL MINING CO.
HOOVERSVILLE, SOMERSET CO., PA.
Scale — 1" = 100'
J.S. Silyman & Co. Engrs.
CTC12-2
LINCOLN E. MYERS.
PATRICK BOYER
ISAAC ANKNEY
OLD COLONY COAL MINING CO.
MINED OUT
DRAINAGE DRIFT
CROP HEADING
4TH RIGHT
4TH LEFT
2ND MAIN
WATER WAY
5TH RIGHT
5TH LEFT
6TH RIGHT
6TH LEFT
7TH RIGHT
7TH LEFT
8TH RIGHT
8TH LEFT
9TH RIGHT
9TH LEFT
MIDDLE HEADING
MAIN
1ST
ROGERS HEADING
ITALY HEADING
OLD COLONY COAL MINING CO. No. 3 DRIFT
N 34° 45' E
S 28° 00' W
S 22° 00' W
N 88° 25' W