


Match to Barden Line

BARROWS & CO. INC.

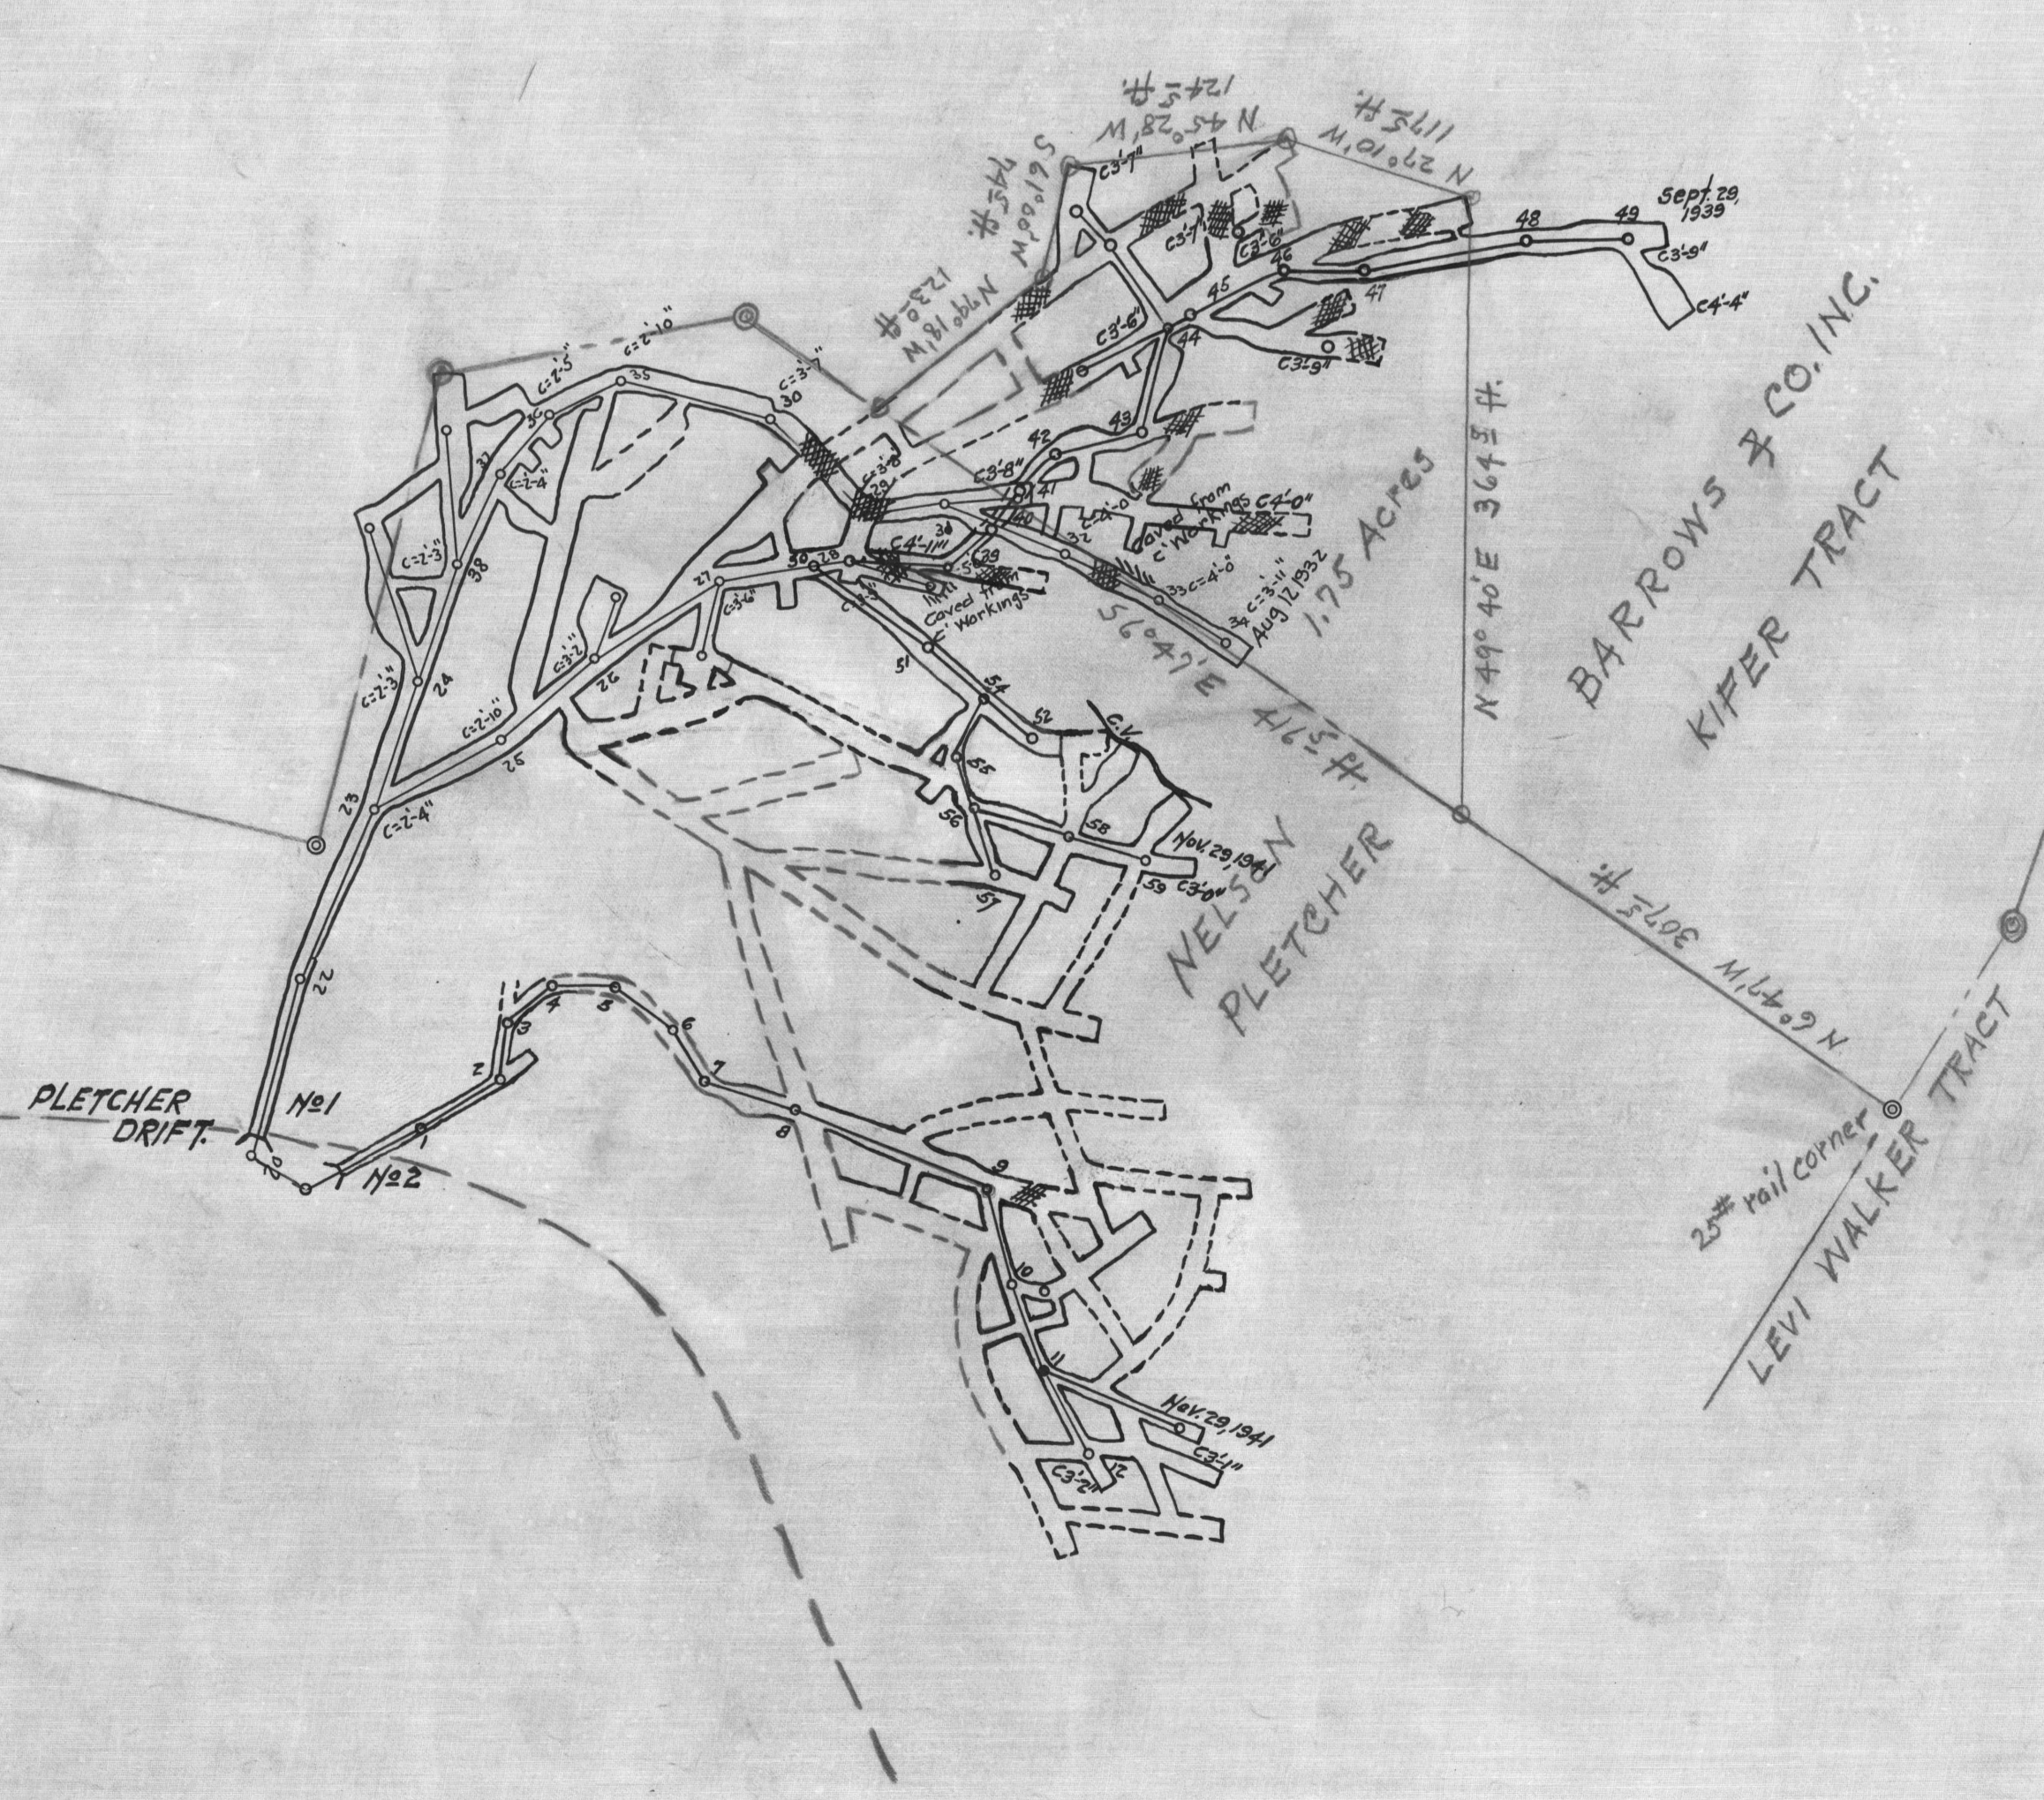

MAP SHOWING WORKINGS
 OF THE
 PLETCHER MINE
 OPERATED BY
 CHARLES ZIEGLER
 NEAR LISTIE, SOMERSET COUNTY, PA.

SCALE: -1"=100'

SILLIMAN & WESTLEY
ENGINEERS
ALTOONA, PA.