

85-1002

PLOT SHOWING COAL DEVELOPMENT
ON THE
THOMAS CARADINE, ROBERT SMOCK,
AND EDWARD ROBERTSON TRACTS.
IN
SHADE TOWNSHIP SOMERSET CO., PA.
APRIL 16 1912
Scale: 1"=100'
Joseph Pittman & Co.
ENGINEERS
C766-2

THOMAS CARADINE

JAMES THOMPSON

ROBERT SMOCK

EDWARD ROBERTSON

BROOKVILLE SEAM
FIRST PEBLEY DRIFT
fallen in

Bot. Coal El. 2475.5
OPENED BY BARNHART
REOPENED BY PEBLEY
fallen in
BROOKVILLE SEAM


El. 2492.5
OPENED BY PEBLEY
fallen in
CLARION SEAM.

SURFACE 2497.0
BOT. COAL El. 2485.0
TR. PIT El. 2490.0
U.S.G.S. 2490.3
CHURCH

GREATEST RISE $\frac{1}{2} 70$
S 73° E

LEVEL
WATER

OUTCROP
OF
"B" COAL

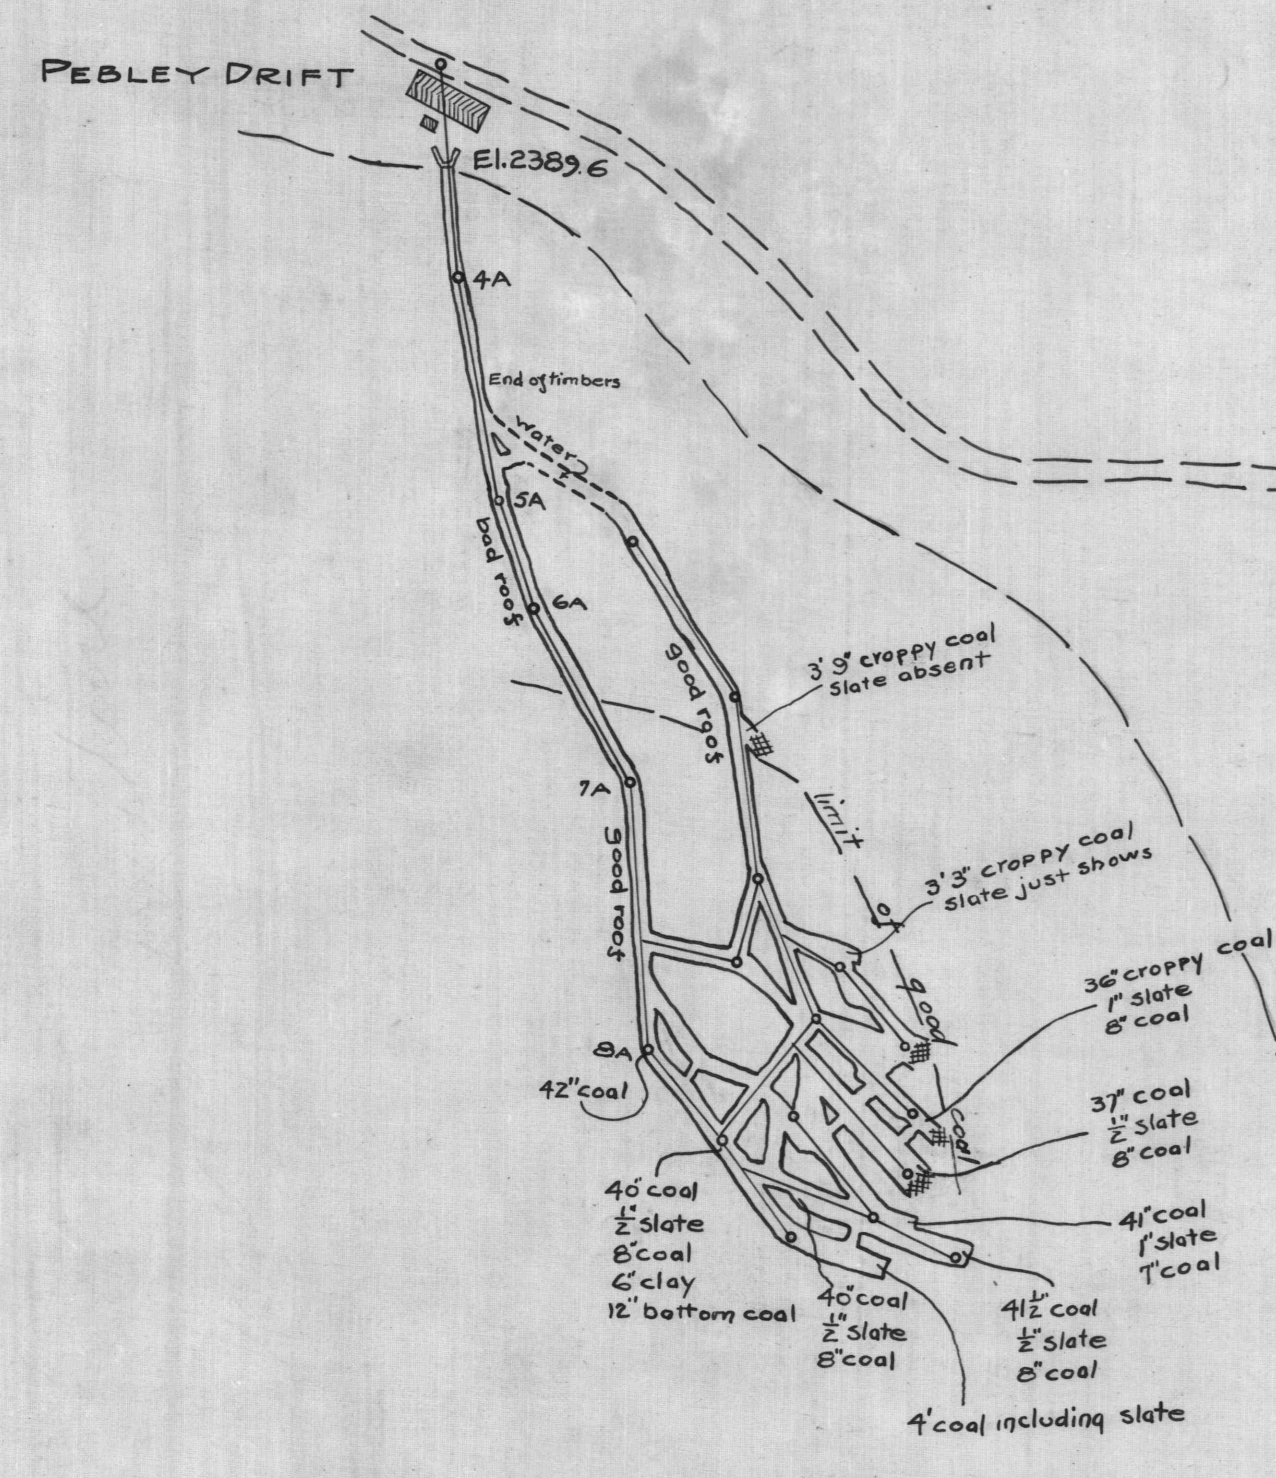

SIMON PERRY

HENRY WEAVER

HOUSE

BARN

CLARK & EALY DRIFT
fallen in

SIME DRIFT
fallen in

BARNHART DRIFT
fallen in

DEECH (gone)
2 beech wit.

El. 2457.5

El. 2494.4

El. 2510.0

El. 2458.0

El. 2438.0

El. 2389.6

El. 2370.0

TO RIETZ

TO WINDOER